


PARENT PARCEL: 09-00-054-000-039

CHILD PARCEL:

STARTING POINT: SOUTHWEST CORNER OF LAND CONVEYED TO MARY ROSS (DV 757/455)

20-04285-A

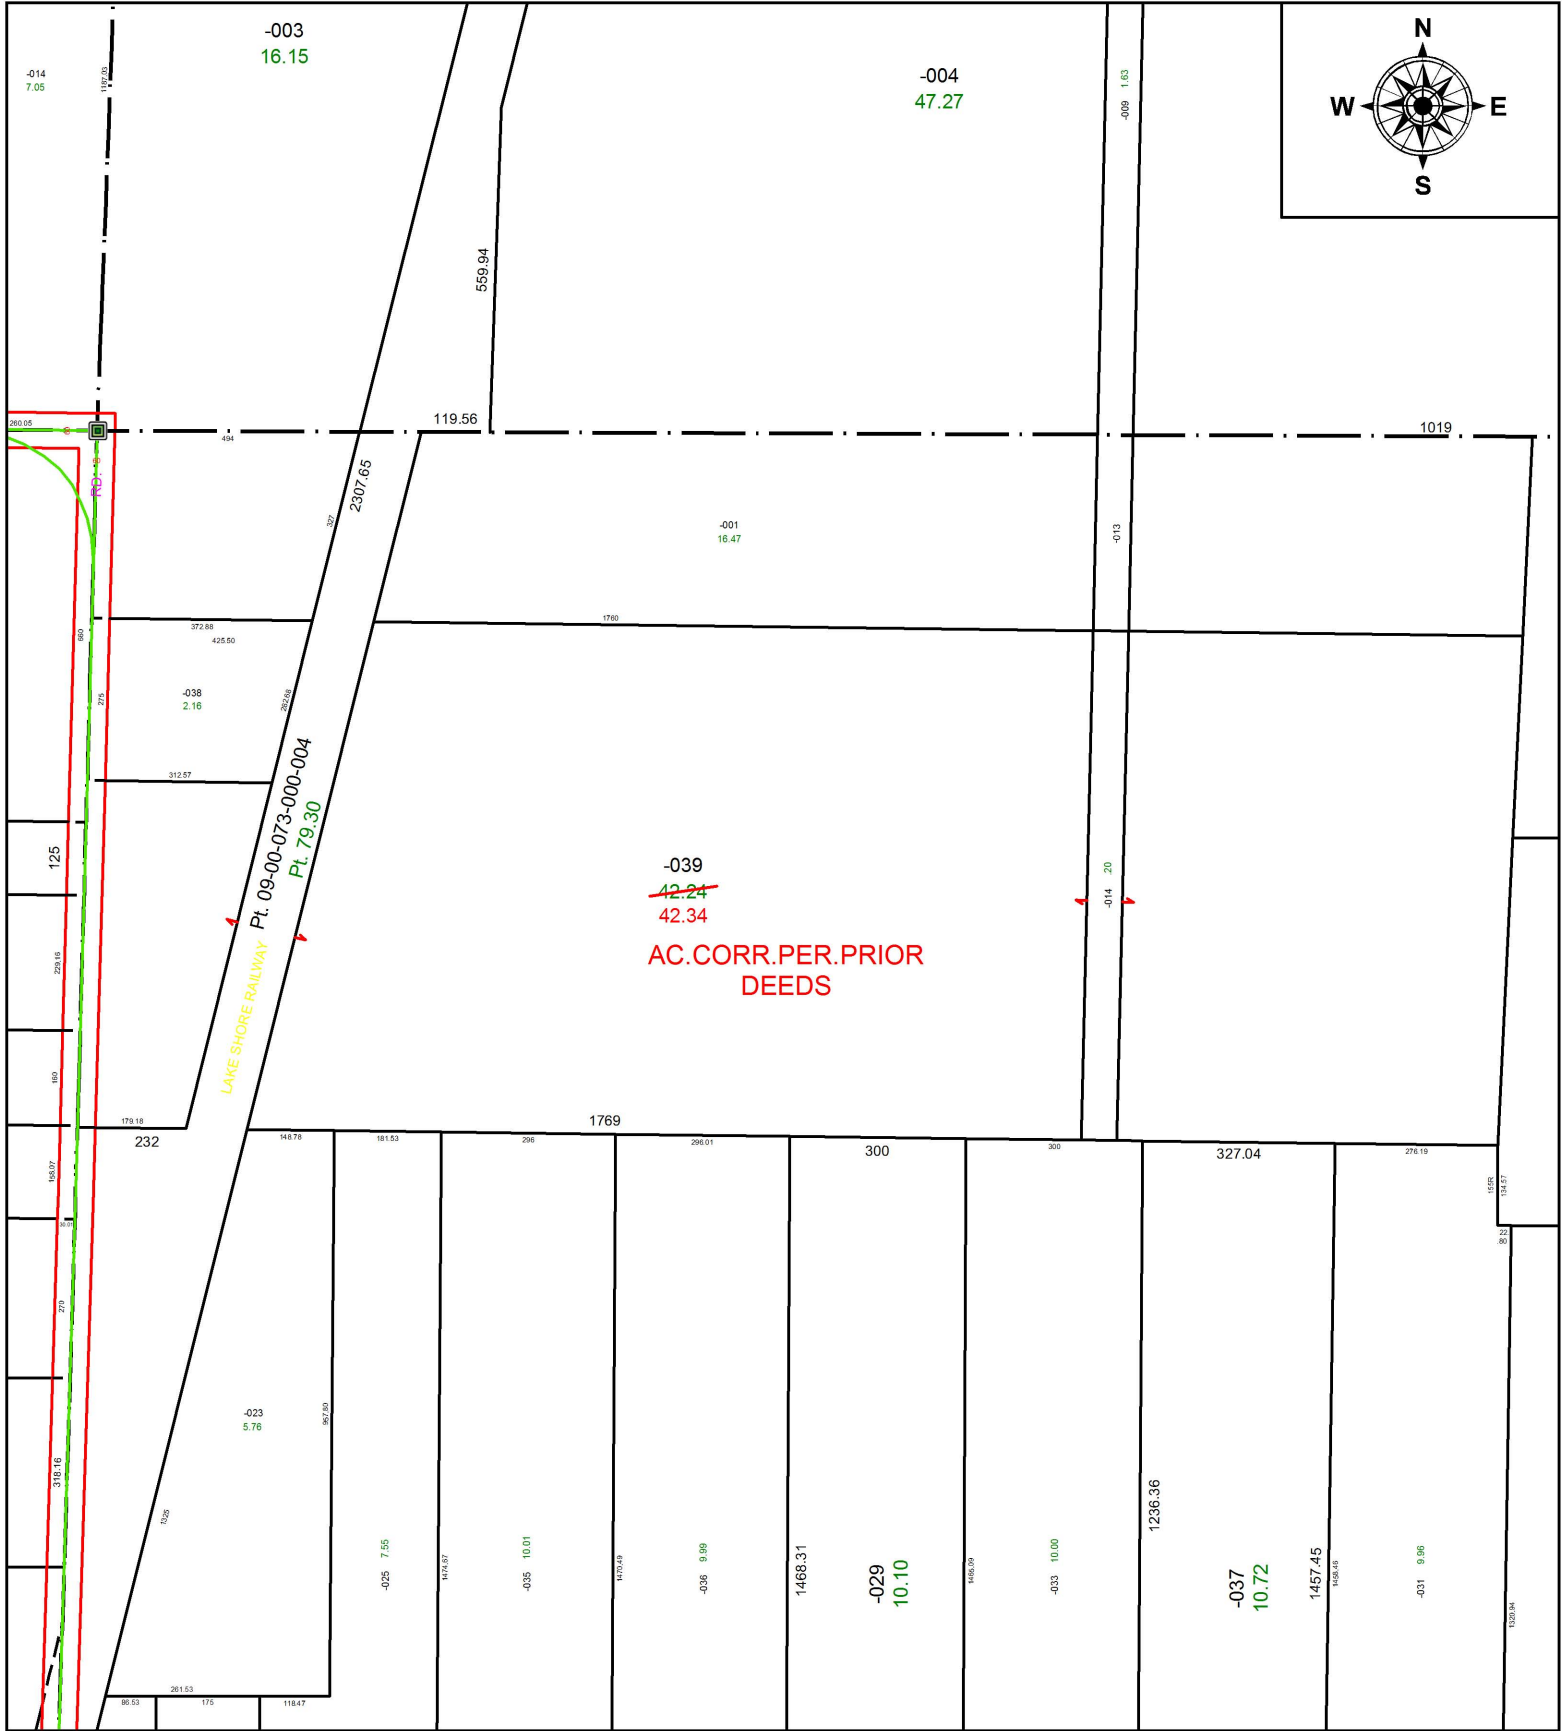

**SPLITS/DEEDS PROCESSED**  
 LORAIN COUNTY TAX MAP DEPARTMENT  
 226 MIDDLE AVE. ELYRIA, OH

SURVEYED BY: \_\_\_\_\_ N/A  
 CLOSURE: \_\_\_\_\_ N/A  
 MAP PAGE(S): \_\_\_\_\_ 9-00-054  
 APPROVED BY: \_\_\_\_\_ RRM DATE: \_\_\_\_\_ 2-5-20  
 SCALE: \_\_\_\_\_ 1" = 325 \_\_\_\_\_ PRIOR INSTRUMENT: \_\_\_\_\_ 19970450936