
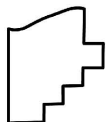


PARENT PARCEL: 15-00-045-105-020

CHILD PARCEL: FRONTAGE CORRECTION PER DEED INST. #1999-0605935 59.98 X 271.59

20-04286-C

STARTING POINT: EAST LINE OF LOT 33, 10 FEET NORTH OF THE S.E. CORNER OF LOT 33

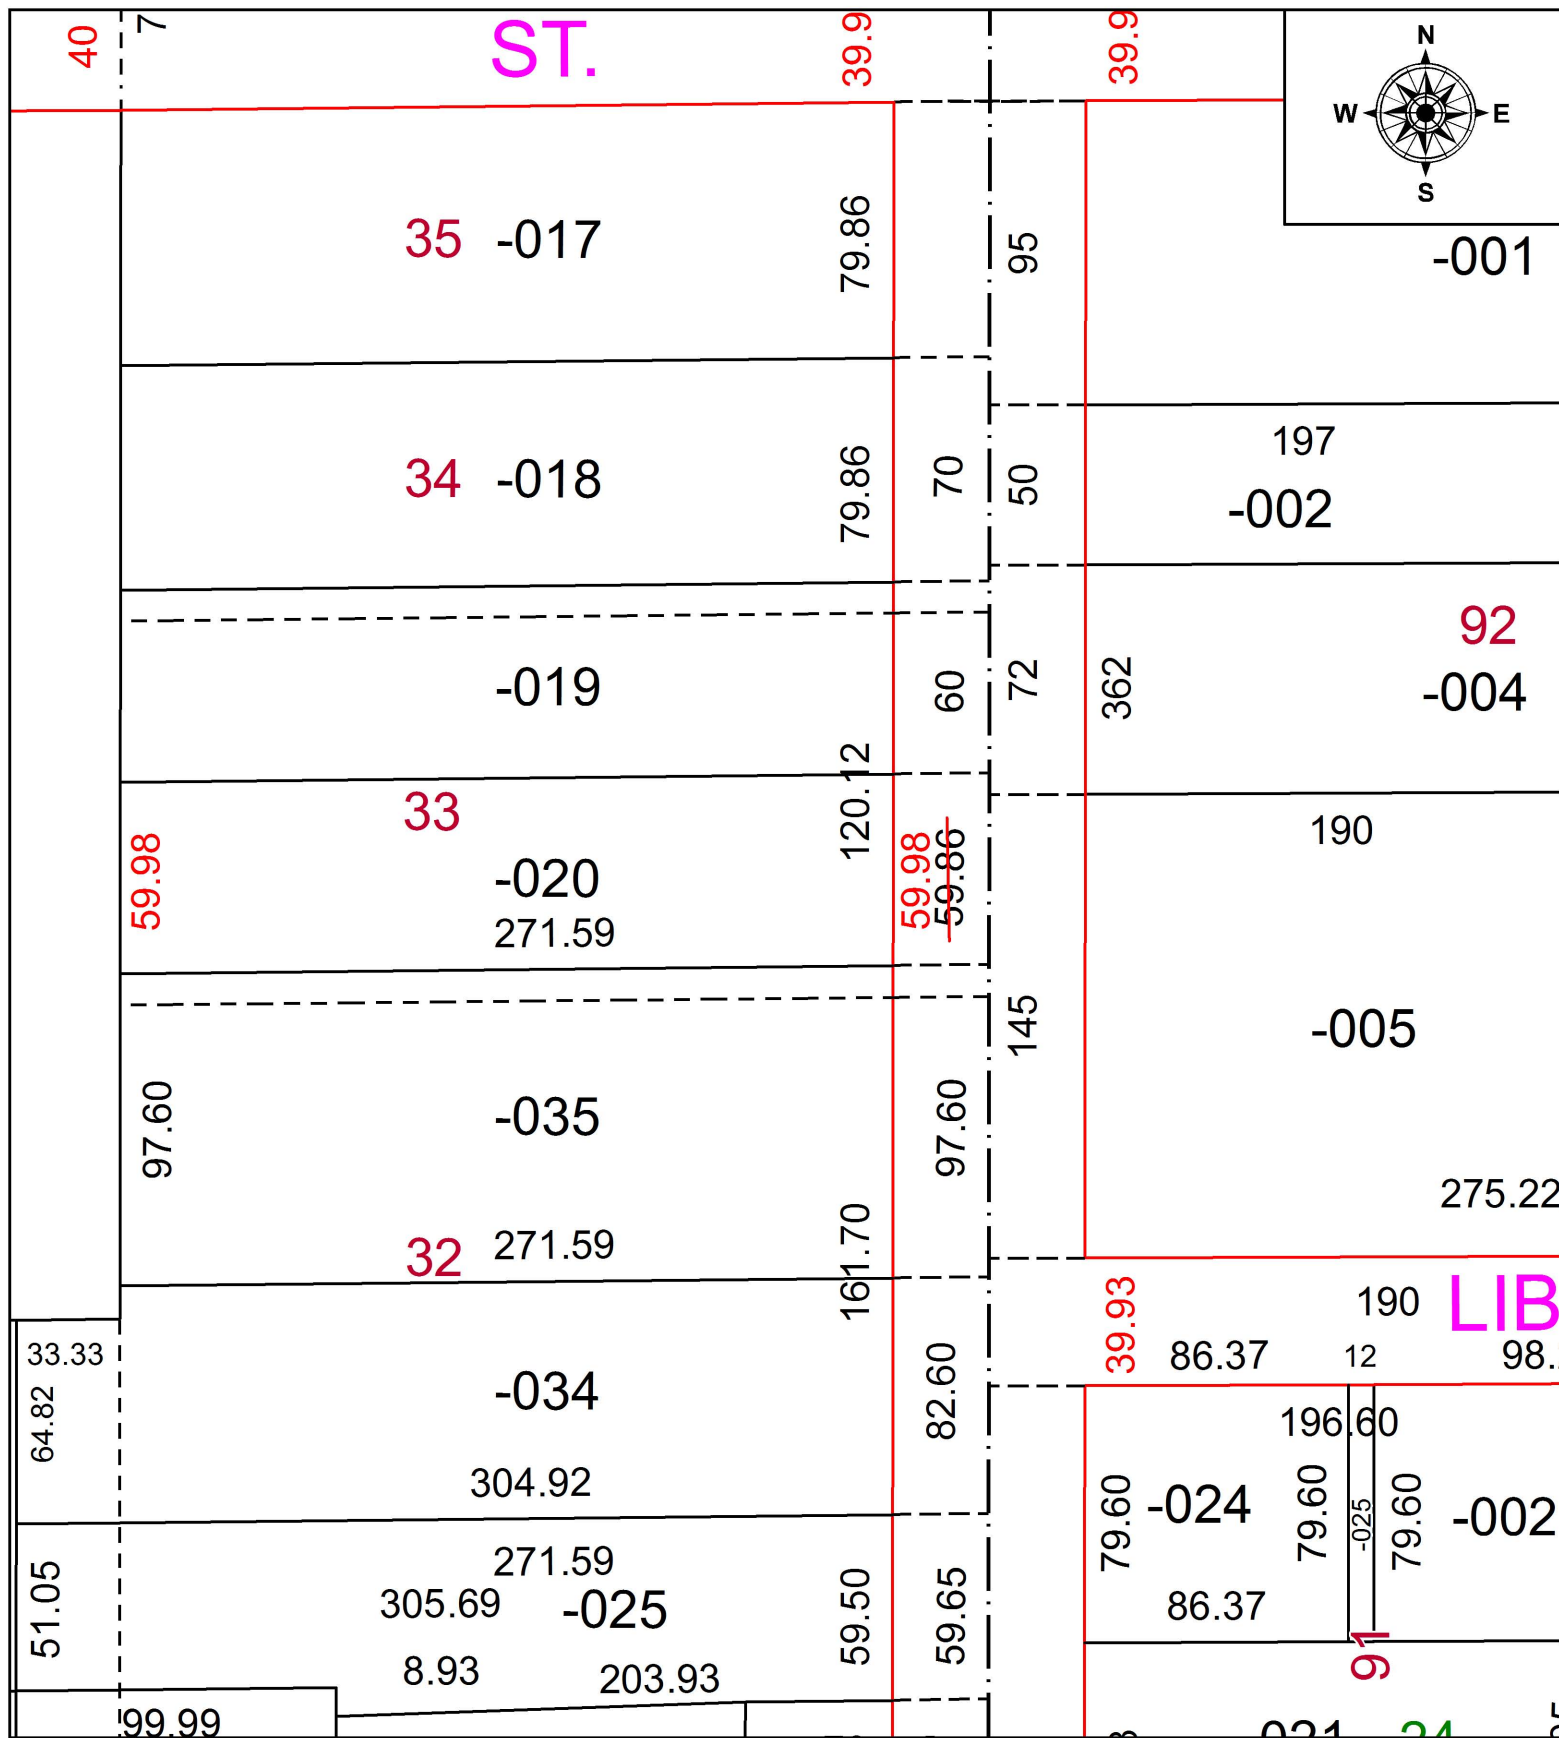

SPLITS/DEEDS PROCESSED
 LORAIN COUNTY TAX MAP DEPARTMENT
 226 MIDDLE AVE. ELYRIA, OH

SURVEYED BY: NA
 CLOSURE: NA
 MAP PAGE(S): 15-00-045
 APPROVED BY: TJS DATE: 2/7/2020
 SCALE: 1" = 60' PRIOR INSTRUMENT: 1999-0605935