
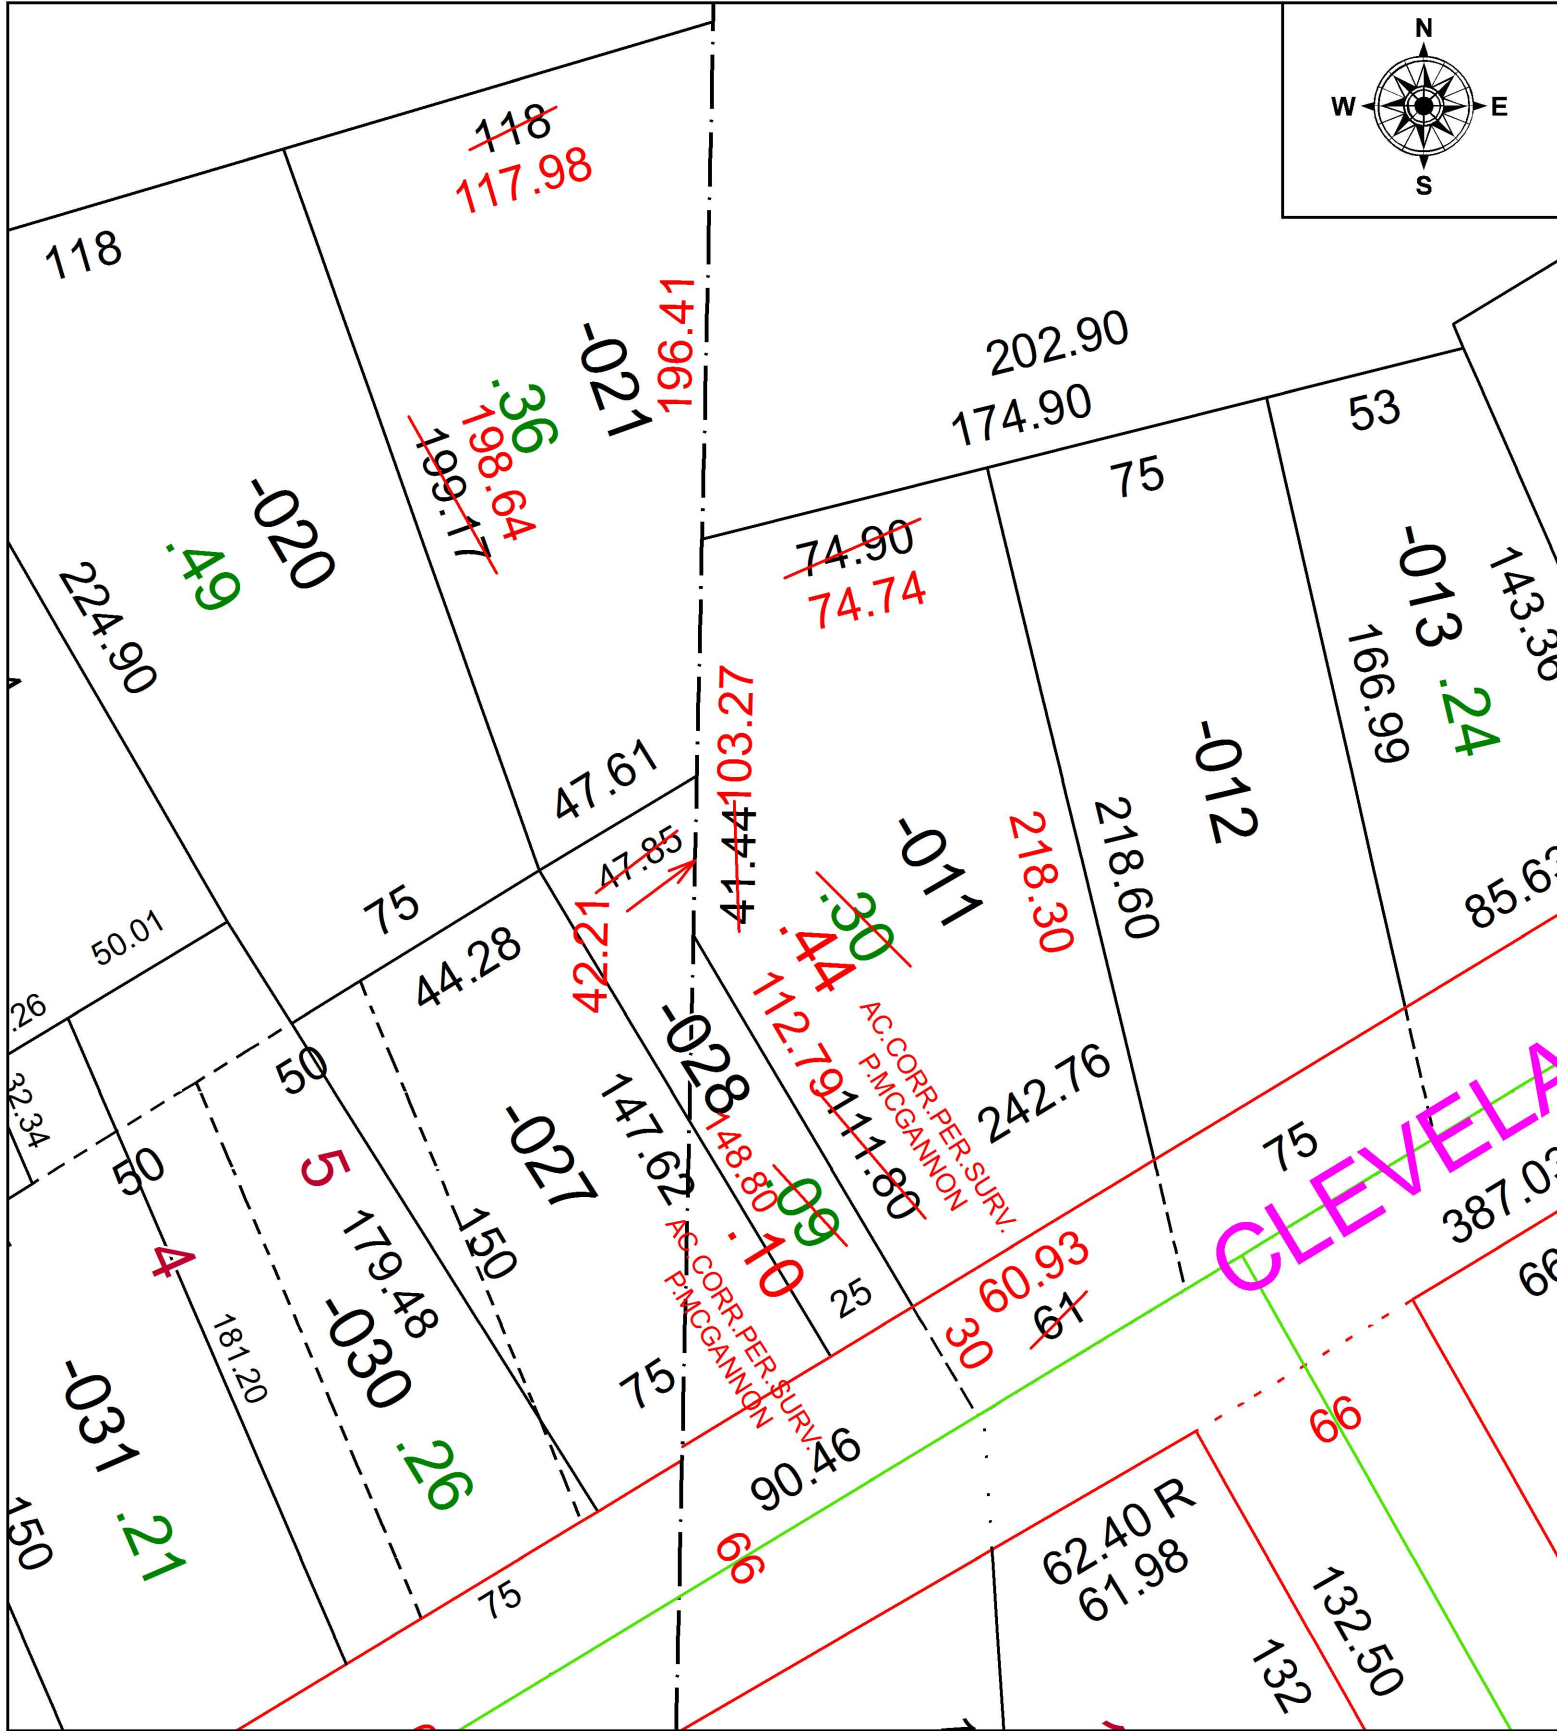


PARENT PARCEL: 05-00-023-107-021, -028, 05-00-038-101-011

CHILD PARCEL:

STARTING POINT: SOUTHWEST CORNER OF S/L 5 IN KOLBE'S FIRST ADD.

20-04288-D

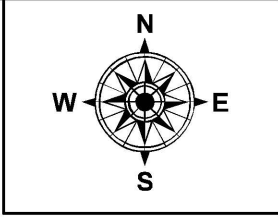

SPLITS/DEEDS PROCESSED
LORAIN COUNTY TAX MAP DEPARTMENT
226 MIDDLE AVE. ELYRIA, OH

SURVEYED BY:	PATRICK A. MCGANNON		
CLOSURE:	1:10,526		
MAP PAGE(S):	5-00-023		
APPROVED BY:	RRM	DATE:	2-19-20
SCALE:	1" = 50	PRIOR INSTRUMENT:	20170621357