
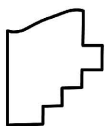


PARENT PARCEL: 07-00-003-102-010

CHILD PARCEL:

STARTING POINT: INTERSECTION OF C/L OF COOK RD. AND C/L OF BUTERNUT RIDGE RD.

20-04289-A

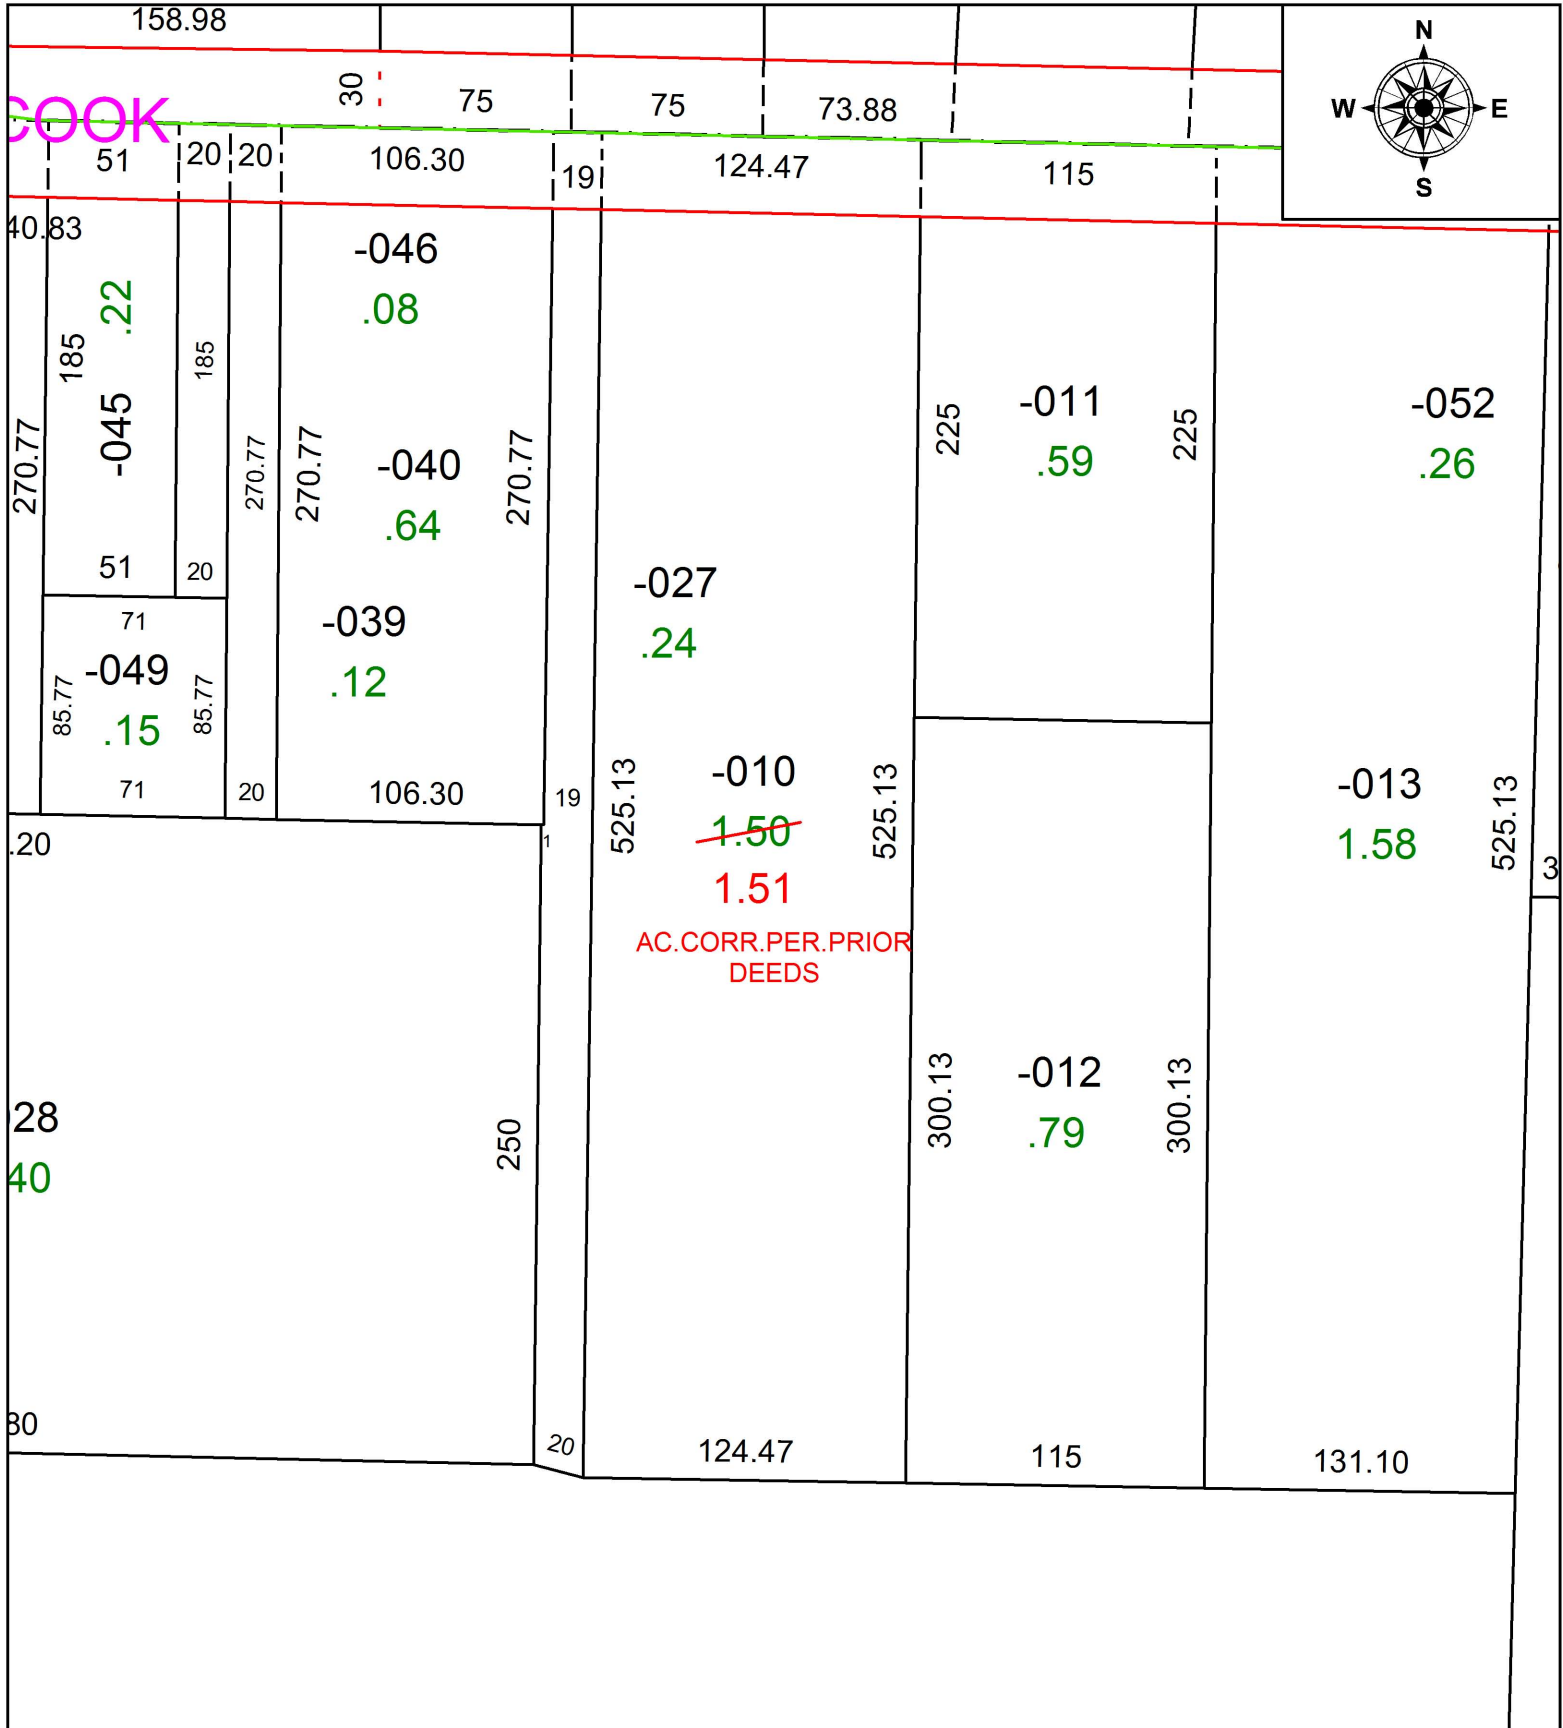

SPLITS/DEEDS PROCESSED
 LORAIN COUNTY TAX MAP DEPARTMENT
 226 MIDDLE AVE. ELYRIA, OH

SURVEYED BY: N/A
 CLOSURE: N/A
 MAP PAGE(S): 7-00-003
 APPROVED BY: RRM DATE: 2-13-20
 SCALE: 1" = 75' PRIOR INSTRUMENT: 20180663201