
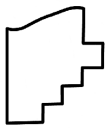


PARENT PARCEL: 08-15-002-000-012 & -013

CHILD PARCEL: 08-15-002-000-014, -015 & -016

STARTING POINT: CL OF GARFIELD RD & VERMILION RD.

21-04289

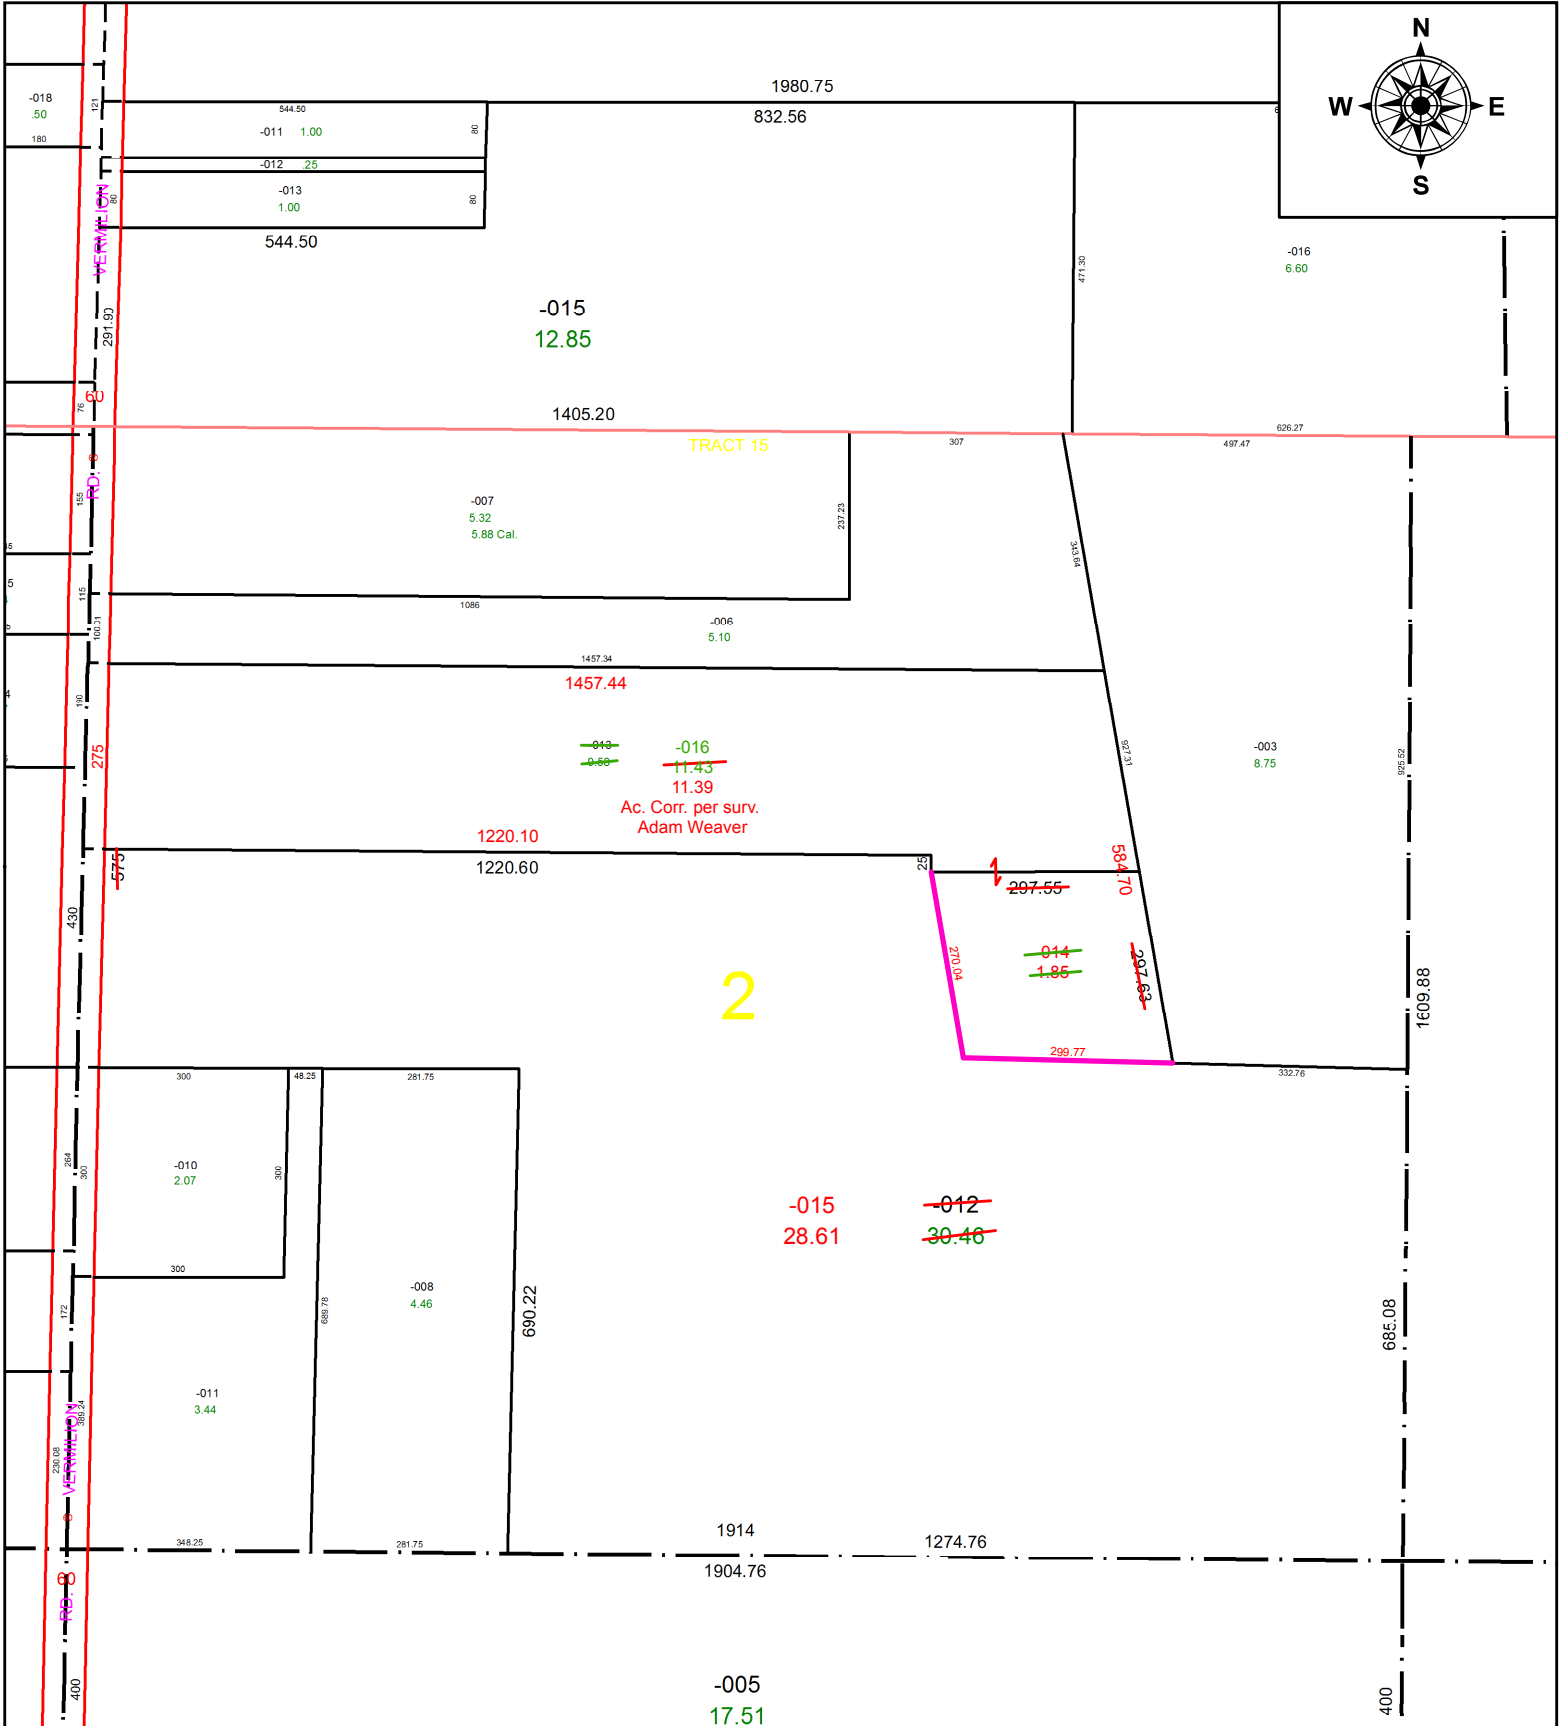

SPLITS/DEEDS PROCESSED
 LORAIN COUNTY TAX MAP DEPARTMENT
 226 MIDDLE AVE. ELYRIA, OH

SURVEYED BY: ADAM WEAVER
CLOSURE: 1: 13,169
MAP PAGE(S): 08-15-002
APPROVED BY: DMA **DATE:** 4/28/21
SCALE: 1" = 275' **PRIOR INSTRUMENT:** INSTR. # 20200747553