

PARENT PARCEL: 20-05-017-102-002

CHILD PARCEL:

STARTING POINT: NORTHEAST CORNER OF O.L.17 TR.5

20-04290-A



013
9.02

-012
5.00

94.95


GRIGGS

420

RD.

GRIGGS

868.61

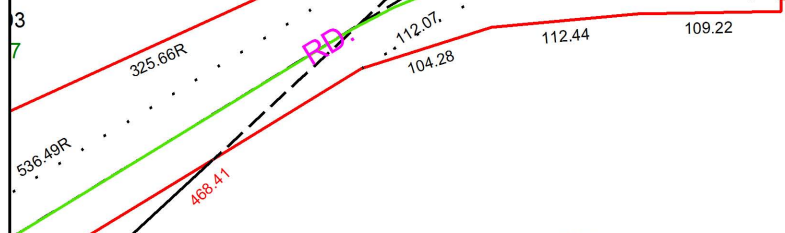


-002
~~7.65~~
7.75

AC.CORR.PER.SURV.
J.LAUGHERY

CONRAIL CORP.
Pt. -001
Pt. 12.17

500

102

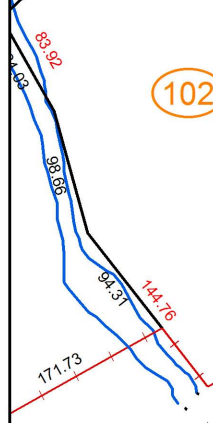


500

Pt. -001
Pt. 12.17

CONRAIL CORP.

Pt. -026
Pt. 53.89

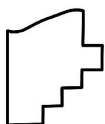

SPLITS/DEEDS PROCESSED
LORAIN COUNTY TAX MAP DEPARTMENT
226 MIDDLE AVE. ELYRIA, OH

SURVEYED BY: JASON K. LAUGHERY

CLOSURE: 1: 450,349

MAP PAGE(S): 20-05-017

APPROVED BY: RRM DATE: 2-20-20

SCALE: 1" = 150 PRIOR INSTRUMENT: 20150547506