
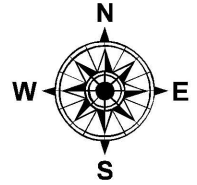


PARENT PARCEL: 05-00-052-000-062, 05-00-053-000-104, 05-00-069-000-001

CHILD PARCEL: _____

STARTING POINT: INTERSECTION OF C/L OF OBERLIN RD. AND SOUTH LINE OF O.L.52


20-04292-A

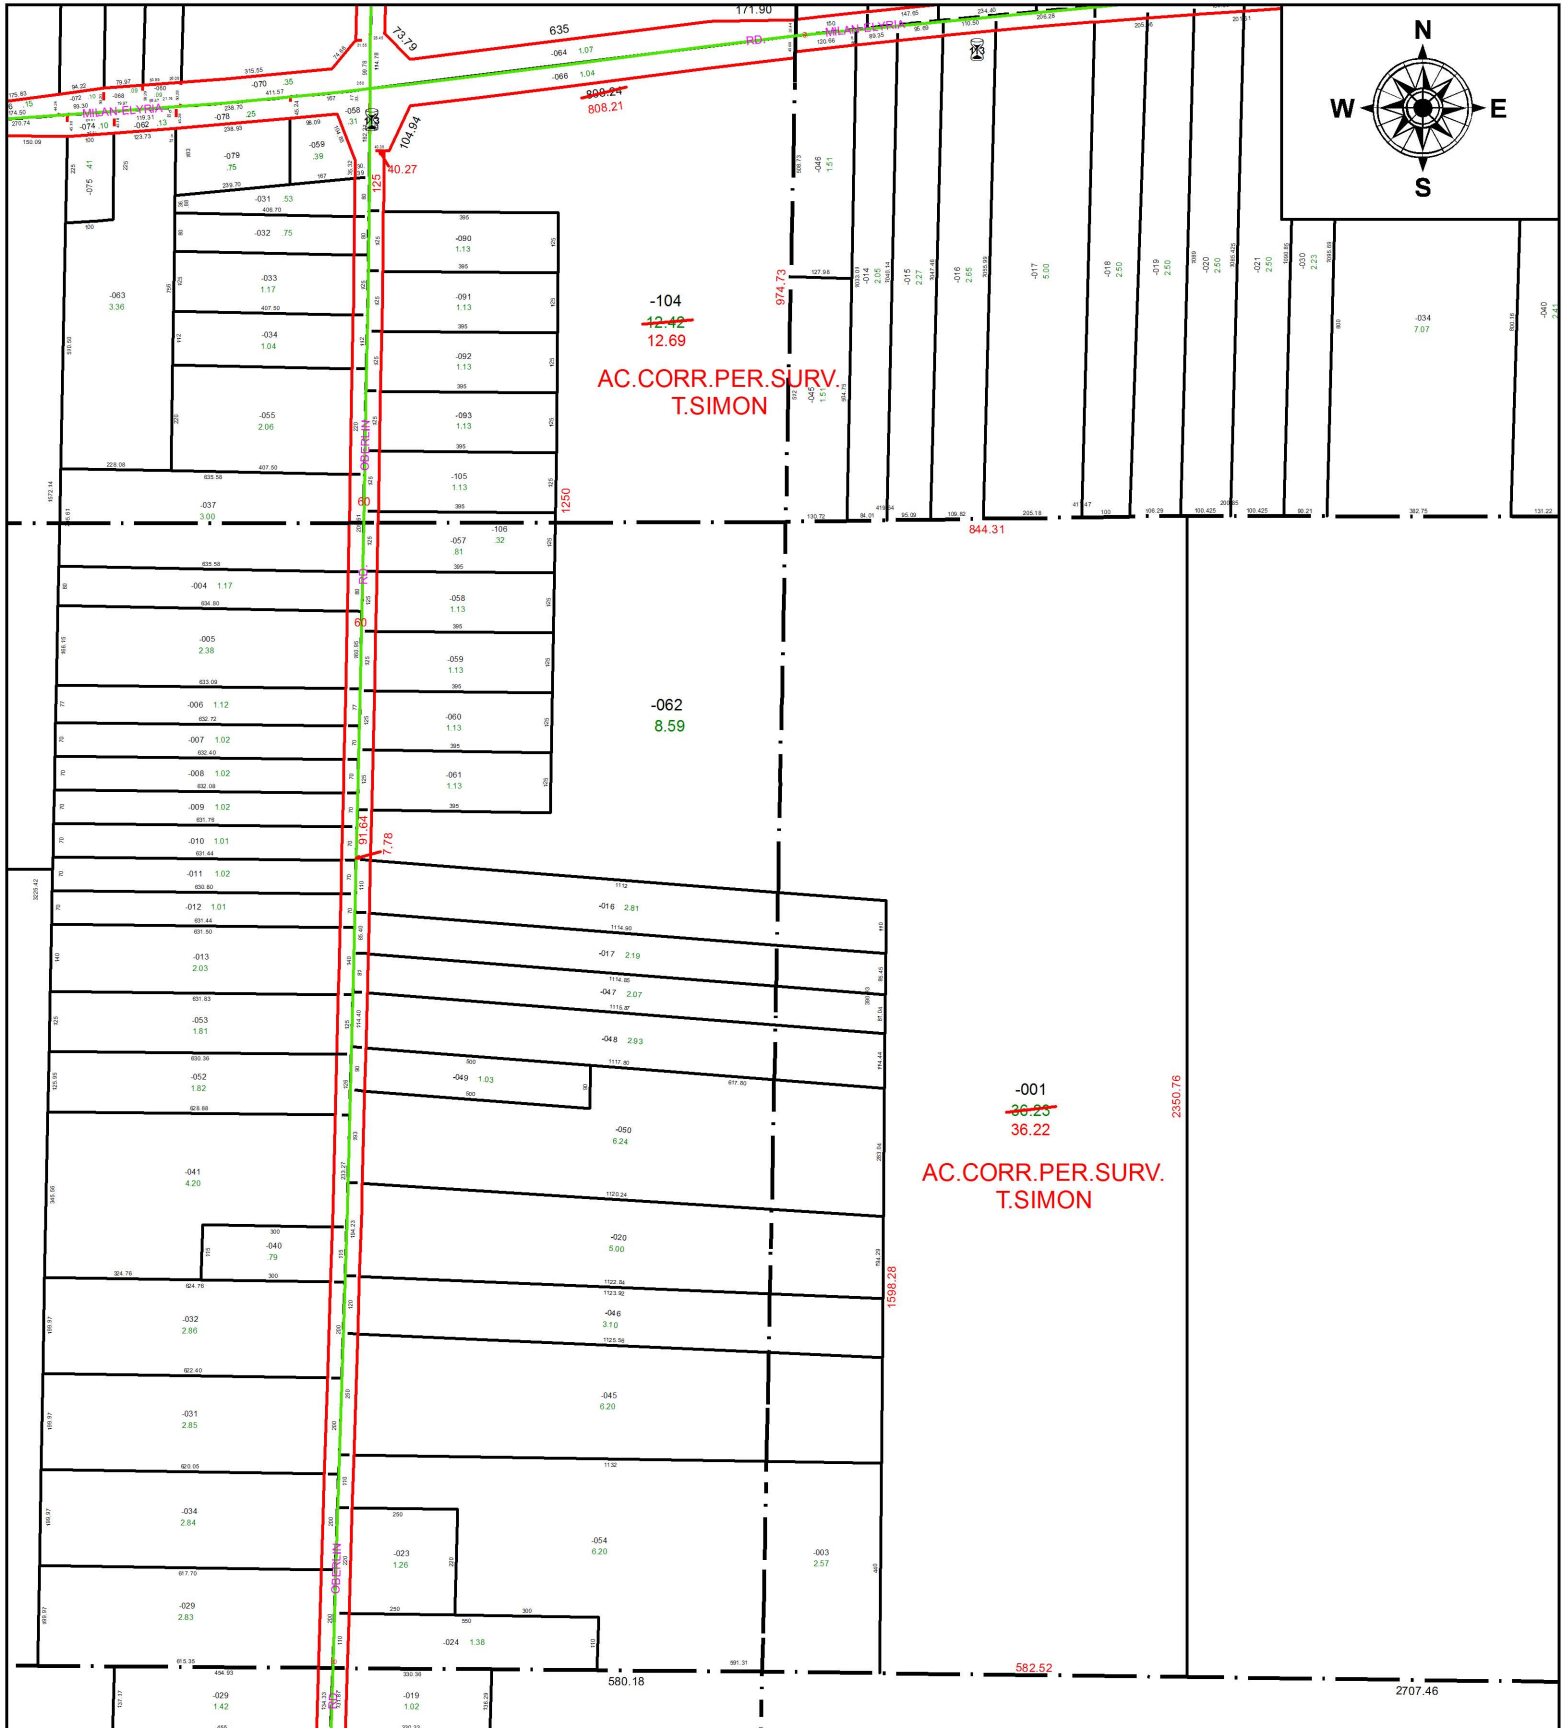

-104
~~12.42~~
 12.69
 AC.CORR.PER.SURV.
 T.SIMON

-062
 8.59

-001
~~36.23~~
 36.22
 AC.CORR.PER.SURV.
 T.SIMON

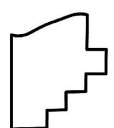

SPLITS/DEEDS PROCESSED
 LORAIN COUNTY TAX MAP DEPARTMENT
 226 MIDDLE AVE. ELYRIA, OH

SURVEYED BY: THOMAS A. SIMON
 CLOSURE: 1:3,040,901
 MAP PAGE(S): 5-00-052
 APPROVED BY: RRM DATE: 2-25-20
 SCALE: 1" = 400 PRIOR INSTRUMENT: 20000707326