


PARENT PARCEL: 05-00-024-116-005 DEPTH CORR. & 05-00-024-116-006 AC. CORR. & ADD TO DUP.

CHILD PARCEL: DEPTH CORR. FROM 40 X 165 TO 40 X 148.26 & AC. CORR. FROM 0.19 A. TO 0.11 A. & ADD TO DUP. 05-00-024-116-032

STARTING POINT: I.P. FD., SOUTH LINE OF CROWN HILL AVE. & WEST LINE OF SOUTH MAIN ST.

20-04296-C

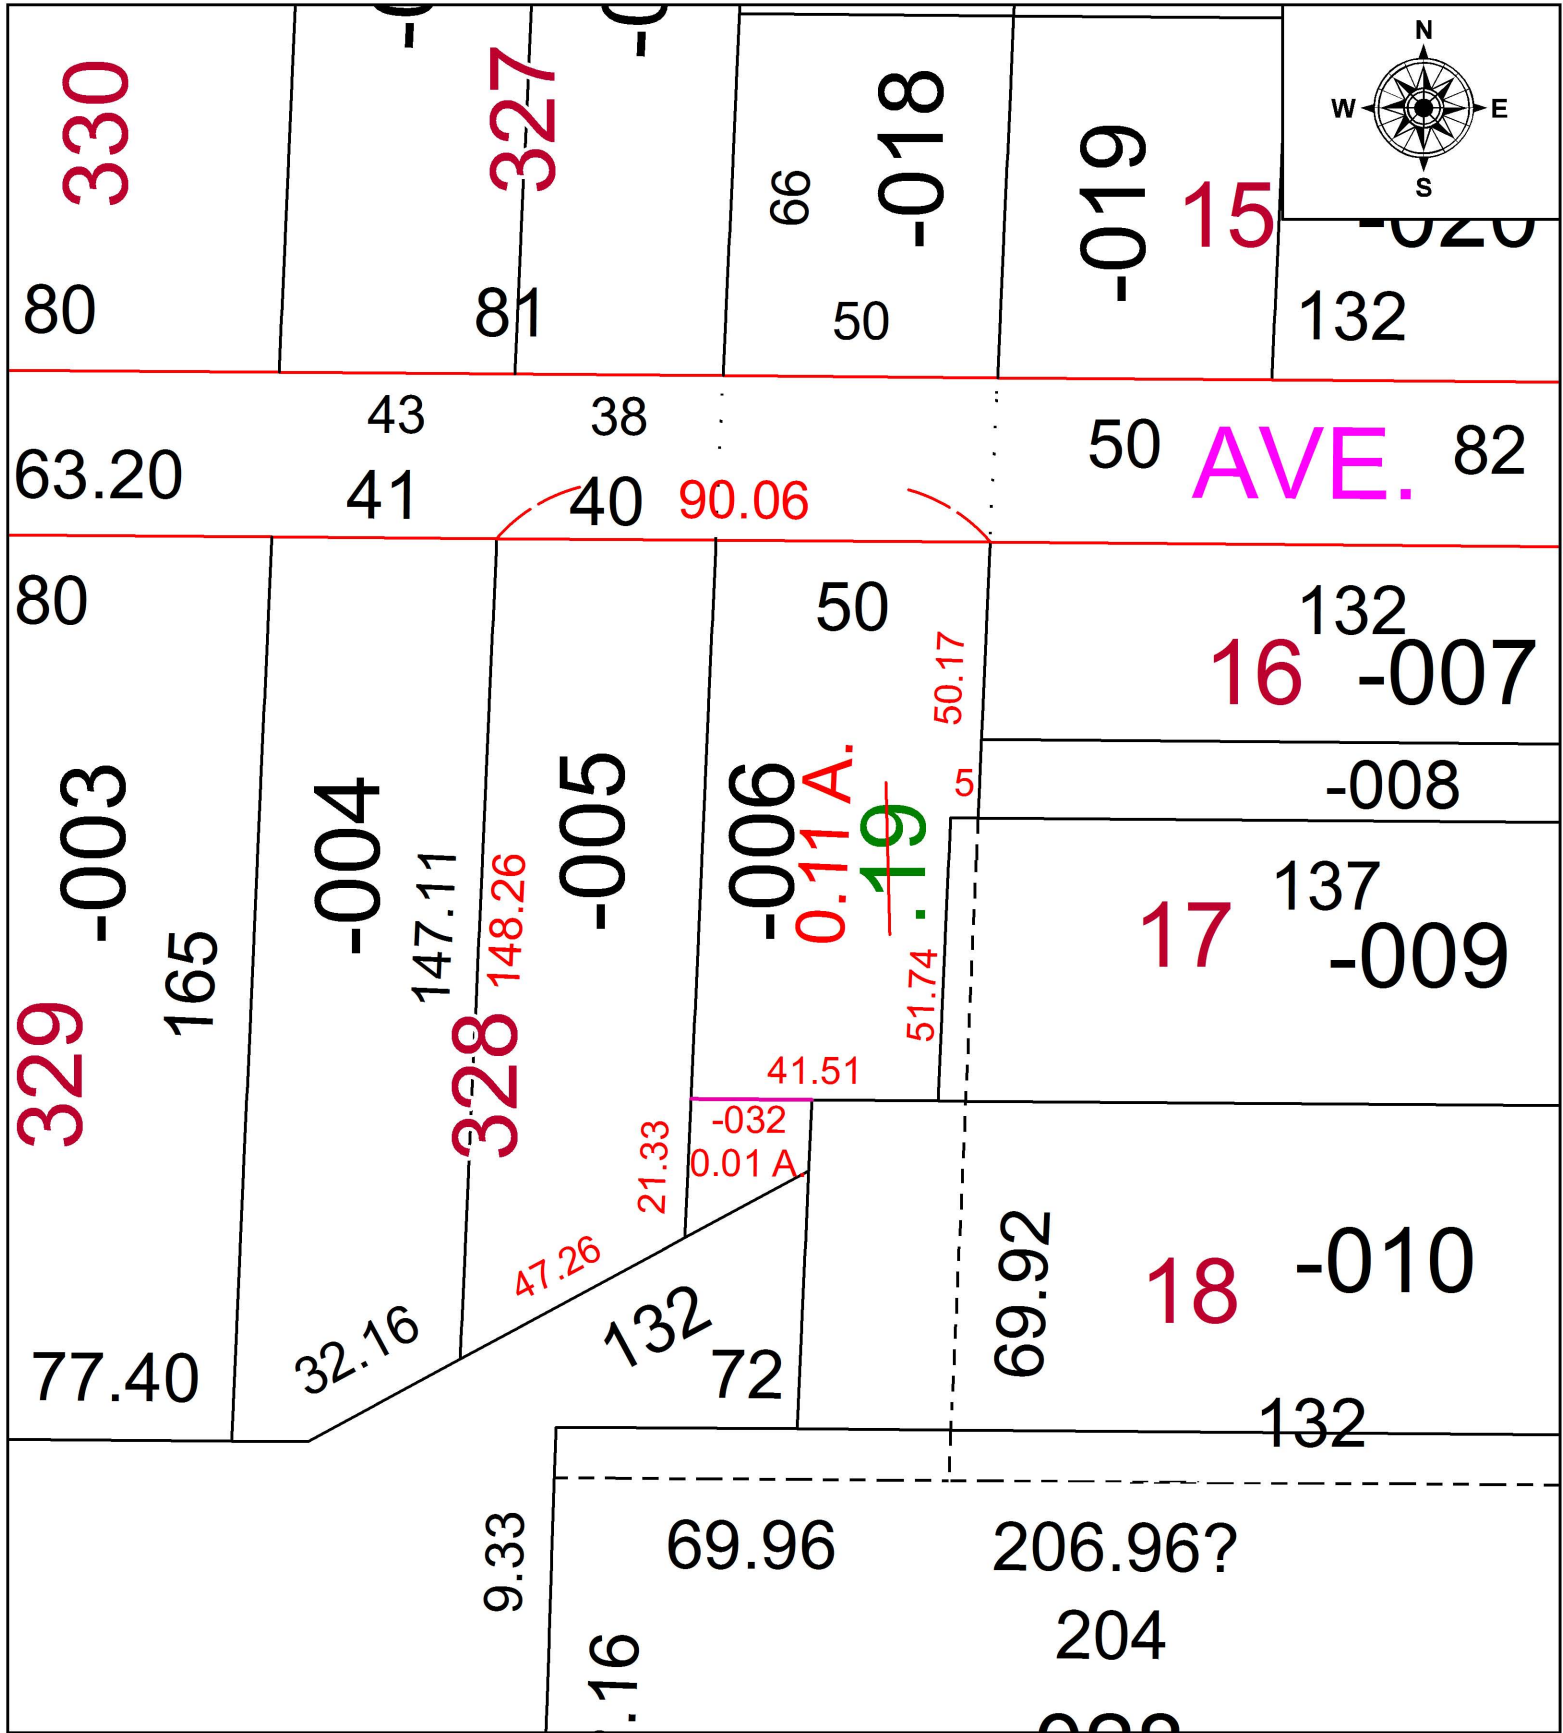

**SPLITS/DEEDS PROCESSED**  
LORAIN COUNTY TAX MAP DEPARTMENT  
226 MIDDLE AVE. ELYRIA, OH

SURVEYED BY: PATRICK A. McGANNON

CLOSURE: 1: 32,000

MAP PAGE(S): 05-00-024

APPROVED BY: TJS DATE: 2/28/2020

SCALE: 1" = 35' PRIOR INSTRUMENT: 2015-0567734