
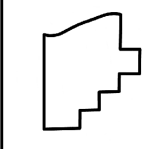
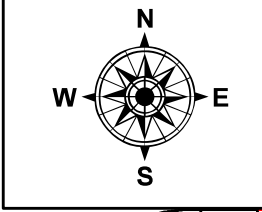


PARENT PARCEL: 04-00-029-116-110

CHILD PARCEL: 04-00-029-116-113 & -114

STARTING POINT: I.P. MON. BOX, CL OF WOODRIDGE WAY & CL OF WINNERS CIRCLE

21-04297

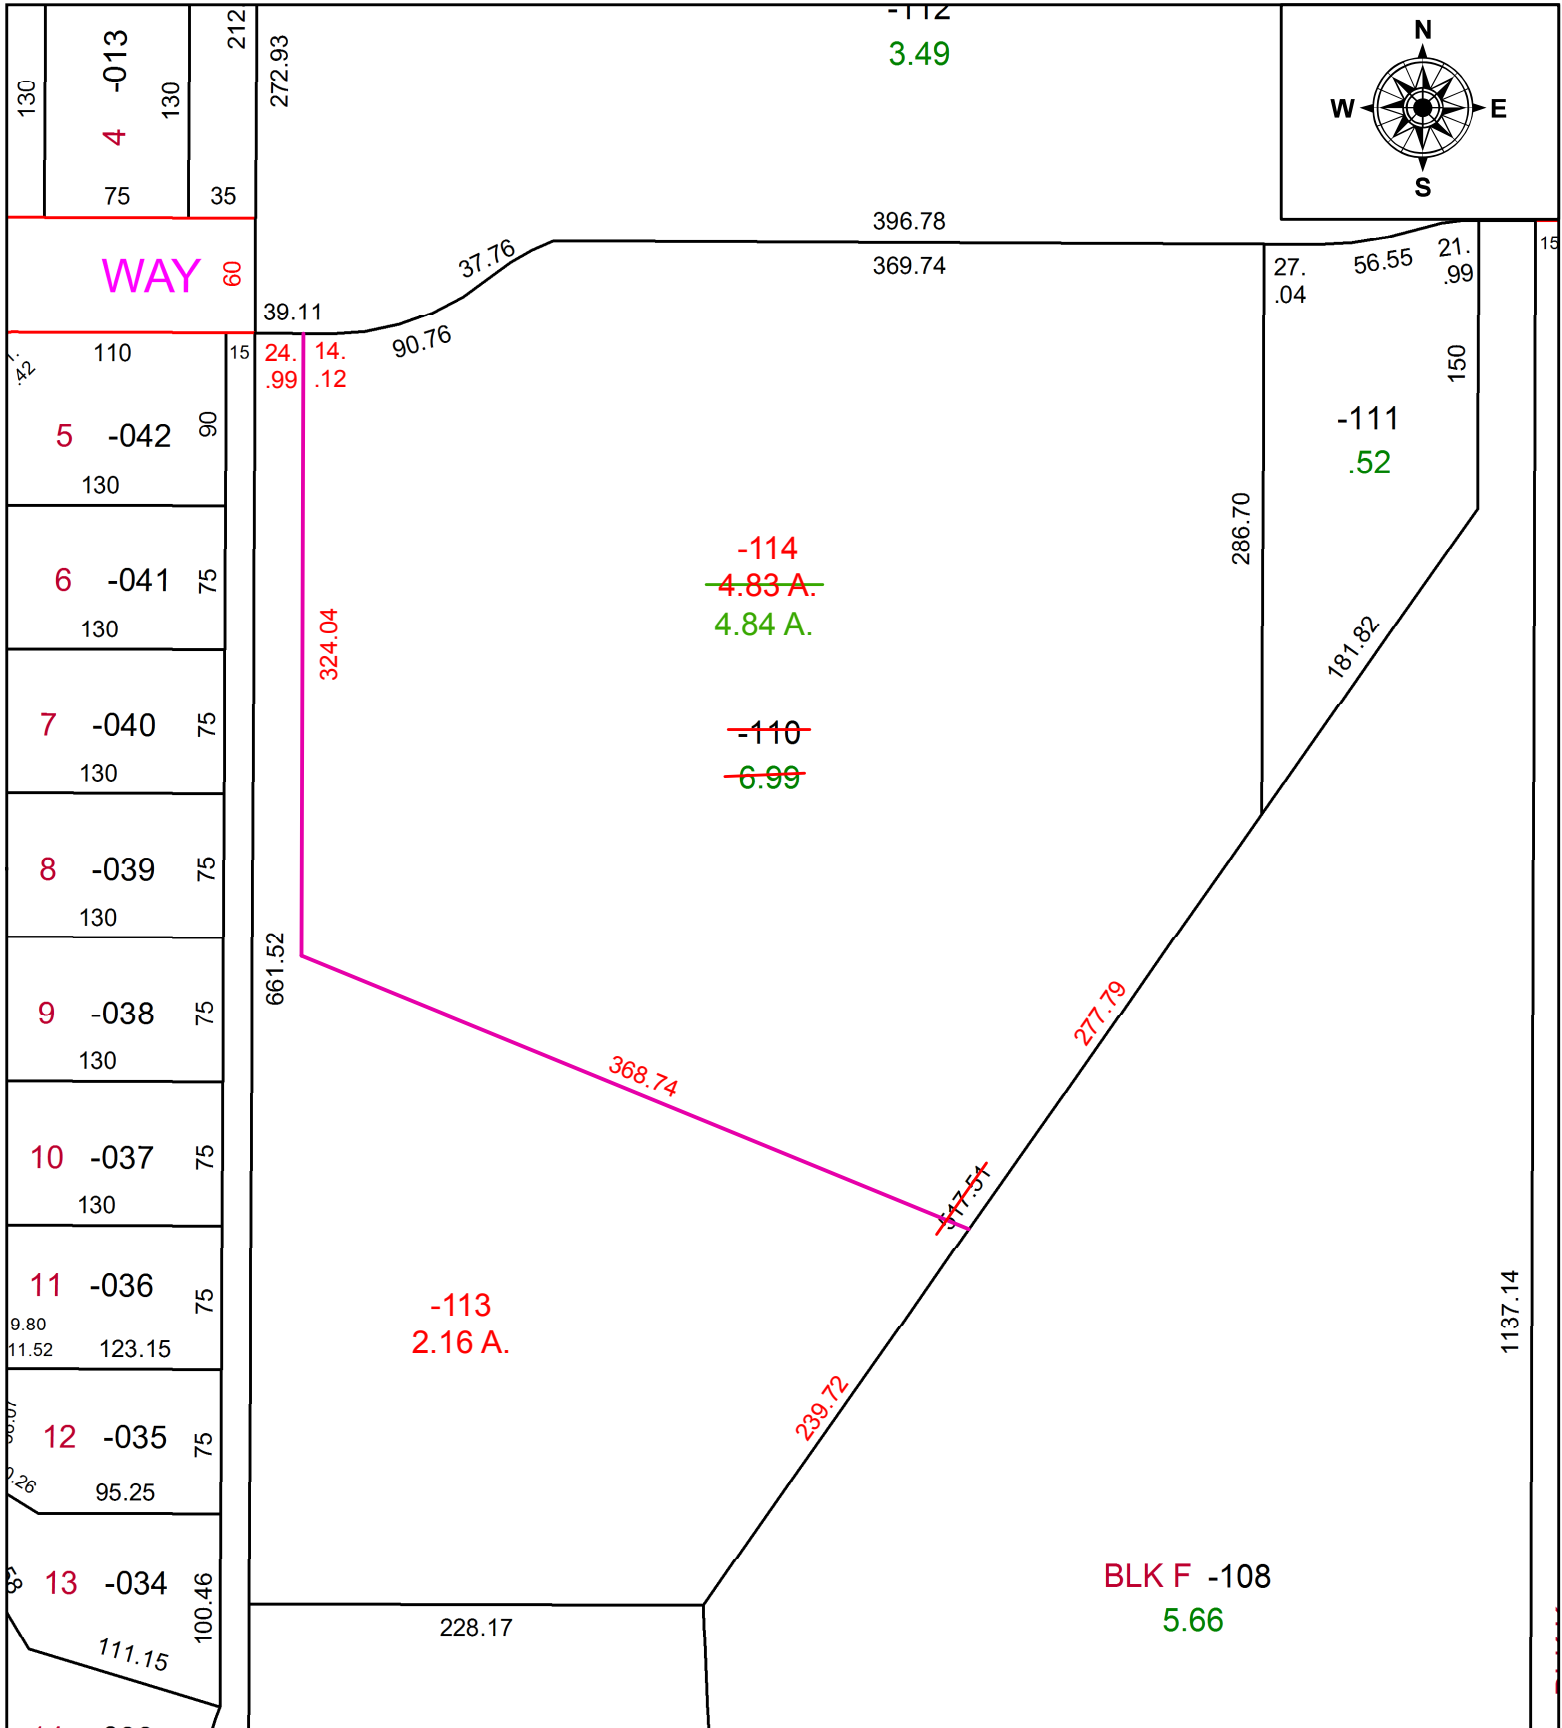

SPLITS/DEEDS PROCESSED
 LORAIN COUNTY TAX MAP DEPARTMENT
 226 MIDDLE AVE. ELYRIA, OH

SURVEYED BY: JAMES T. SAYLER
 CLOSURE: 1:272994
 MAP PAGE(S): 04-00-029
 APPROVED BY: TJS DATE: 5/13/2021
 SCALE: 1" = 100' PRIOR INSTRUMENT: 2021-0802532