
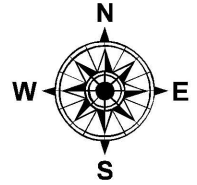


PARENT PARCEL: 18-00-021-112-093

CHILD PARCEL: 18-00-021-112-110, -111

STARTING POINT: S/L 26 & NORTH 1/2 OF S/L 25 IN BLOCK 5 OF S.S. WARNER'S ADDITION

20-04301-U

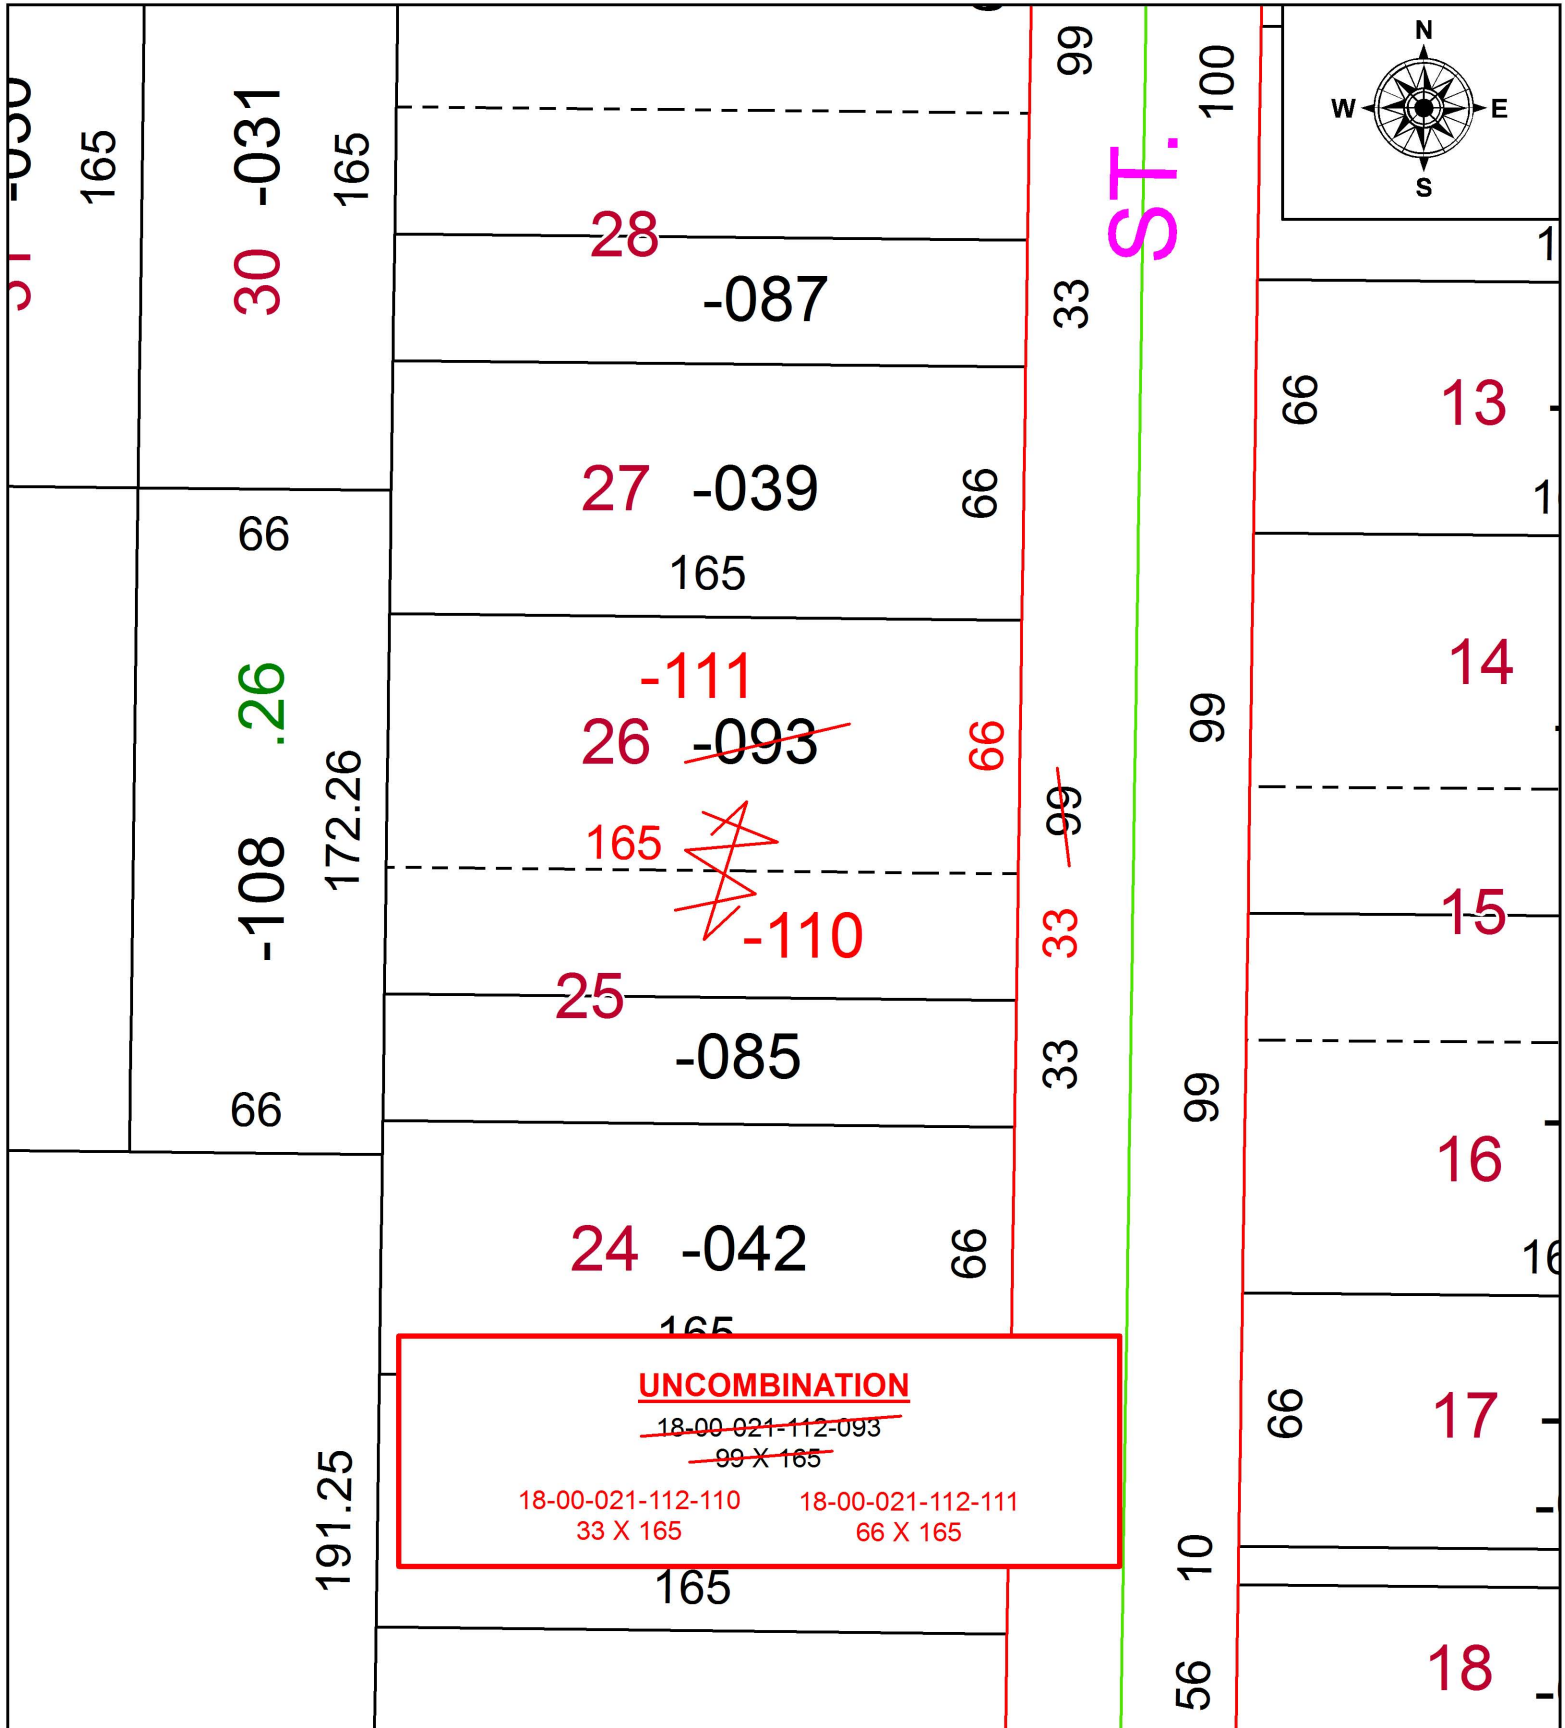

**SPLITS/DEEDS PROCESSED**  
 LORAIN COUNTY TAX MAP DEPARTMENT  
 226 MIDDLE AVE. ELYRIA, OH

SURVEYED BY: N/A  
 CLOSURE: N/A  
 MAP PAGE(S): 18-00-021  
 APPROVED BY: RRM DATE: 3-9-20  
 SCALE: 1" = 50' PRIOR INSTRUMENT: 20120405728