
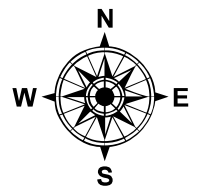


PARENT PARCEL: 07-00-013-000-123 & AC. CORR. 07-00-024-102-055 FROM 11.14 A. TO 11.15 A.

CHILD PARCEL: 07-00-013-000-475 & -476

STARTING POINT: I.P. MON. BOX, CL OF ISLAND RD. & SOUTH LINE OF O.L.13

21-04302

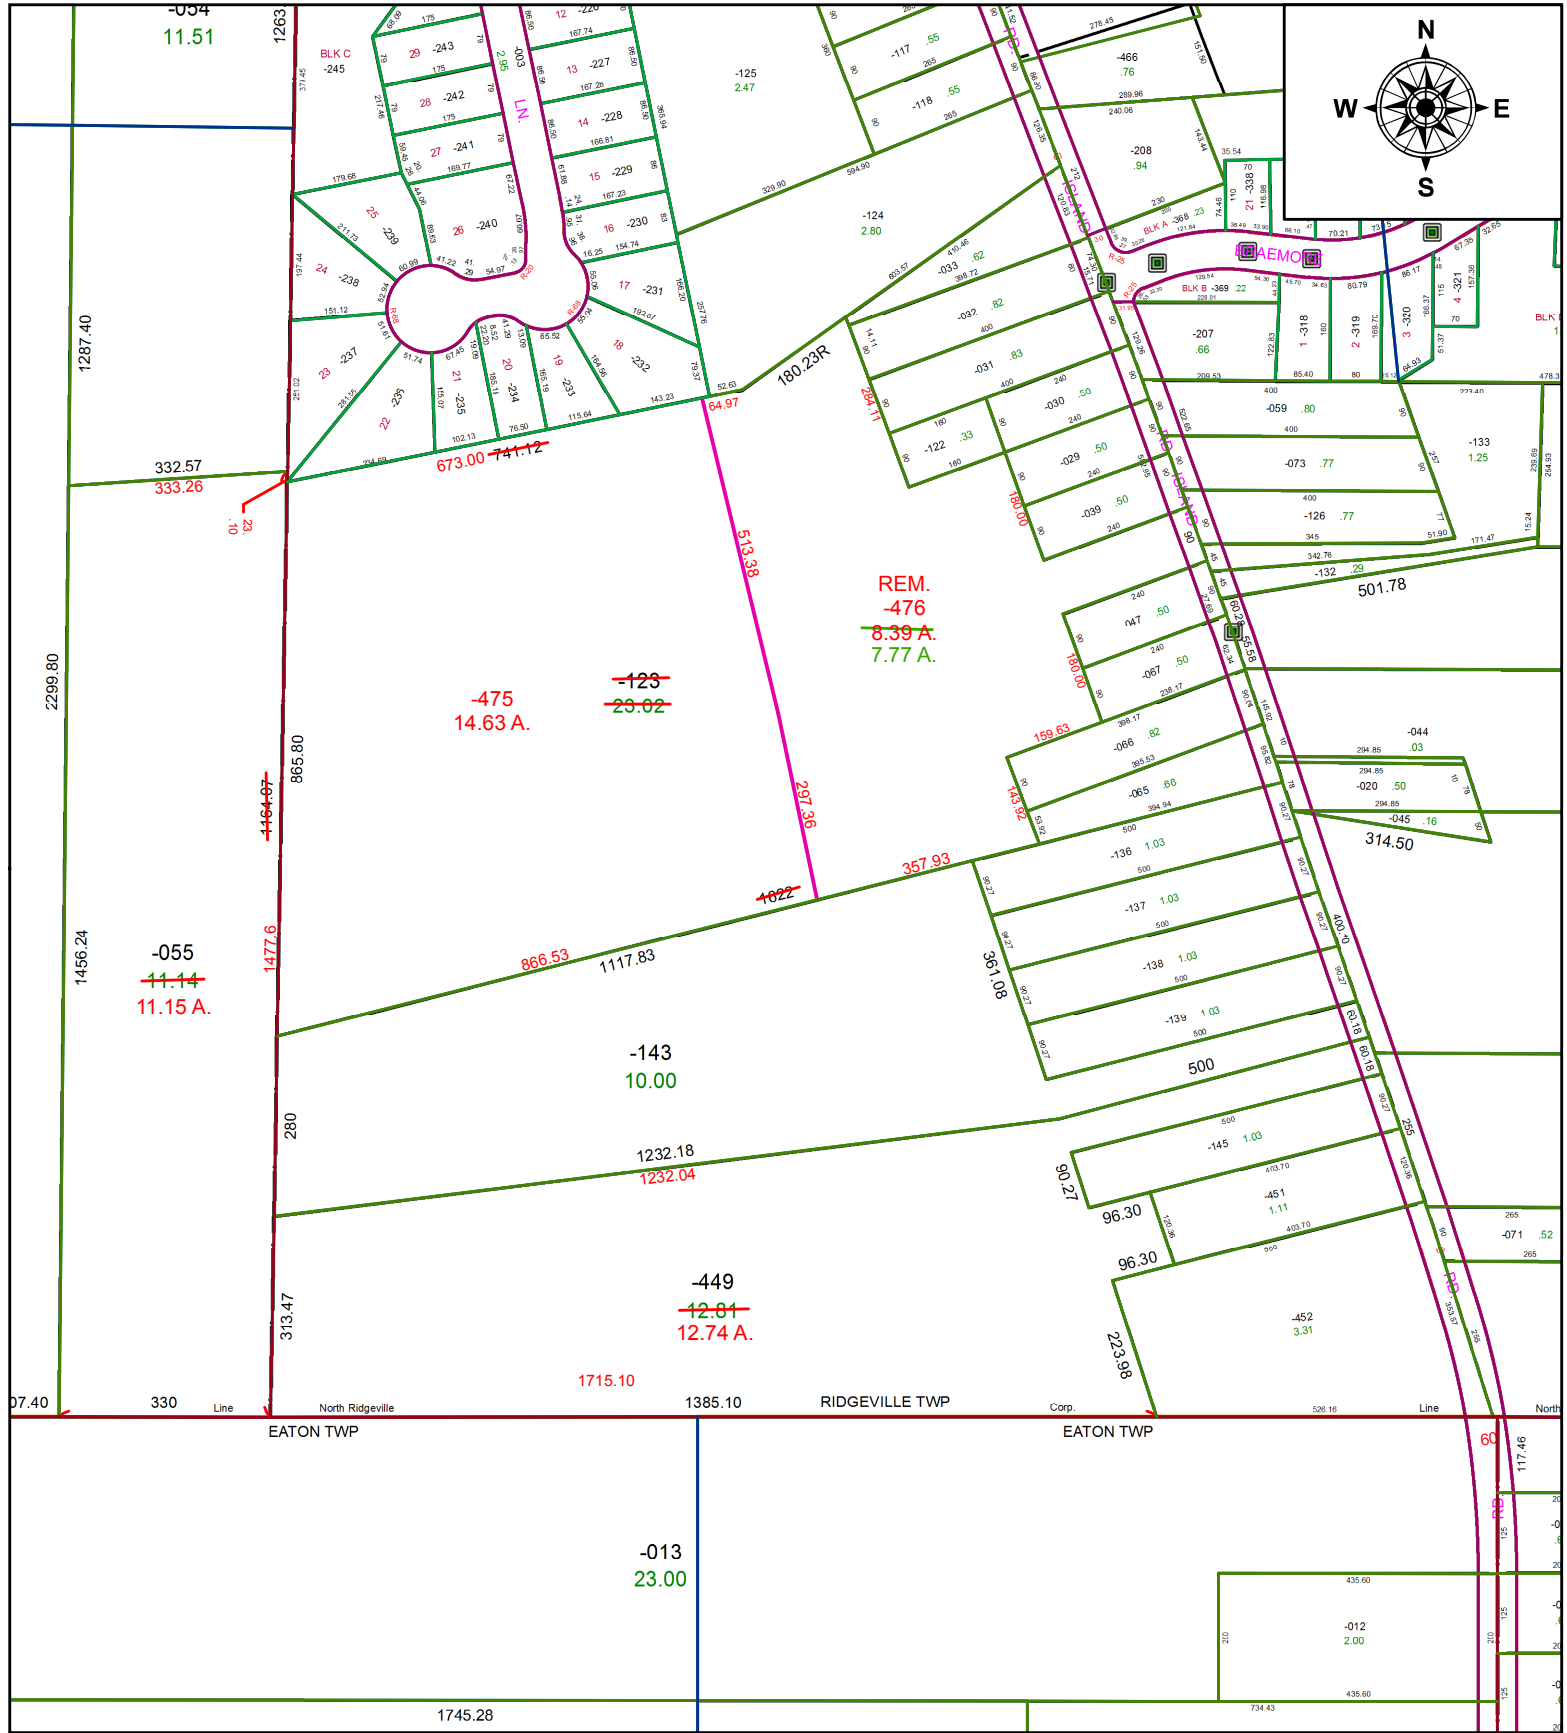

SPLITS/DEEDS PROCESSED
 LORAIN COUNTY TAX MAP DEPARTMENT
 226 MIDDLE AVE. ELYRIA, OH

SURVEYED BY: SEAN A. BOLAND
 CLOSURE: 1:110599
 MAP PAGE(S): 07-00-013 & -024
 APPROVED BY: TJS DATE: 5/19/2021
 SCALE: 1" = 300' PRIOR INSTRUMENT: 2005-0104055