


PARENT PARCEL: 06-25-159-000-010

CHILD PARCEL:

STARTING POINT: NORTHWEST CORNER OF S/L 26 IN ELYWOOD NO.4

20-04304-D

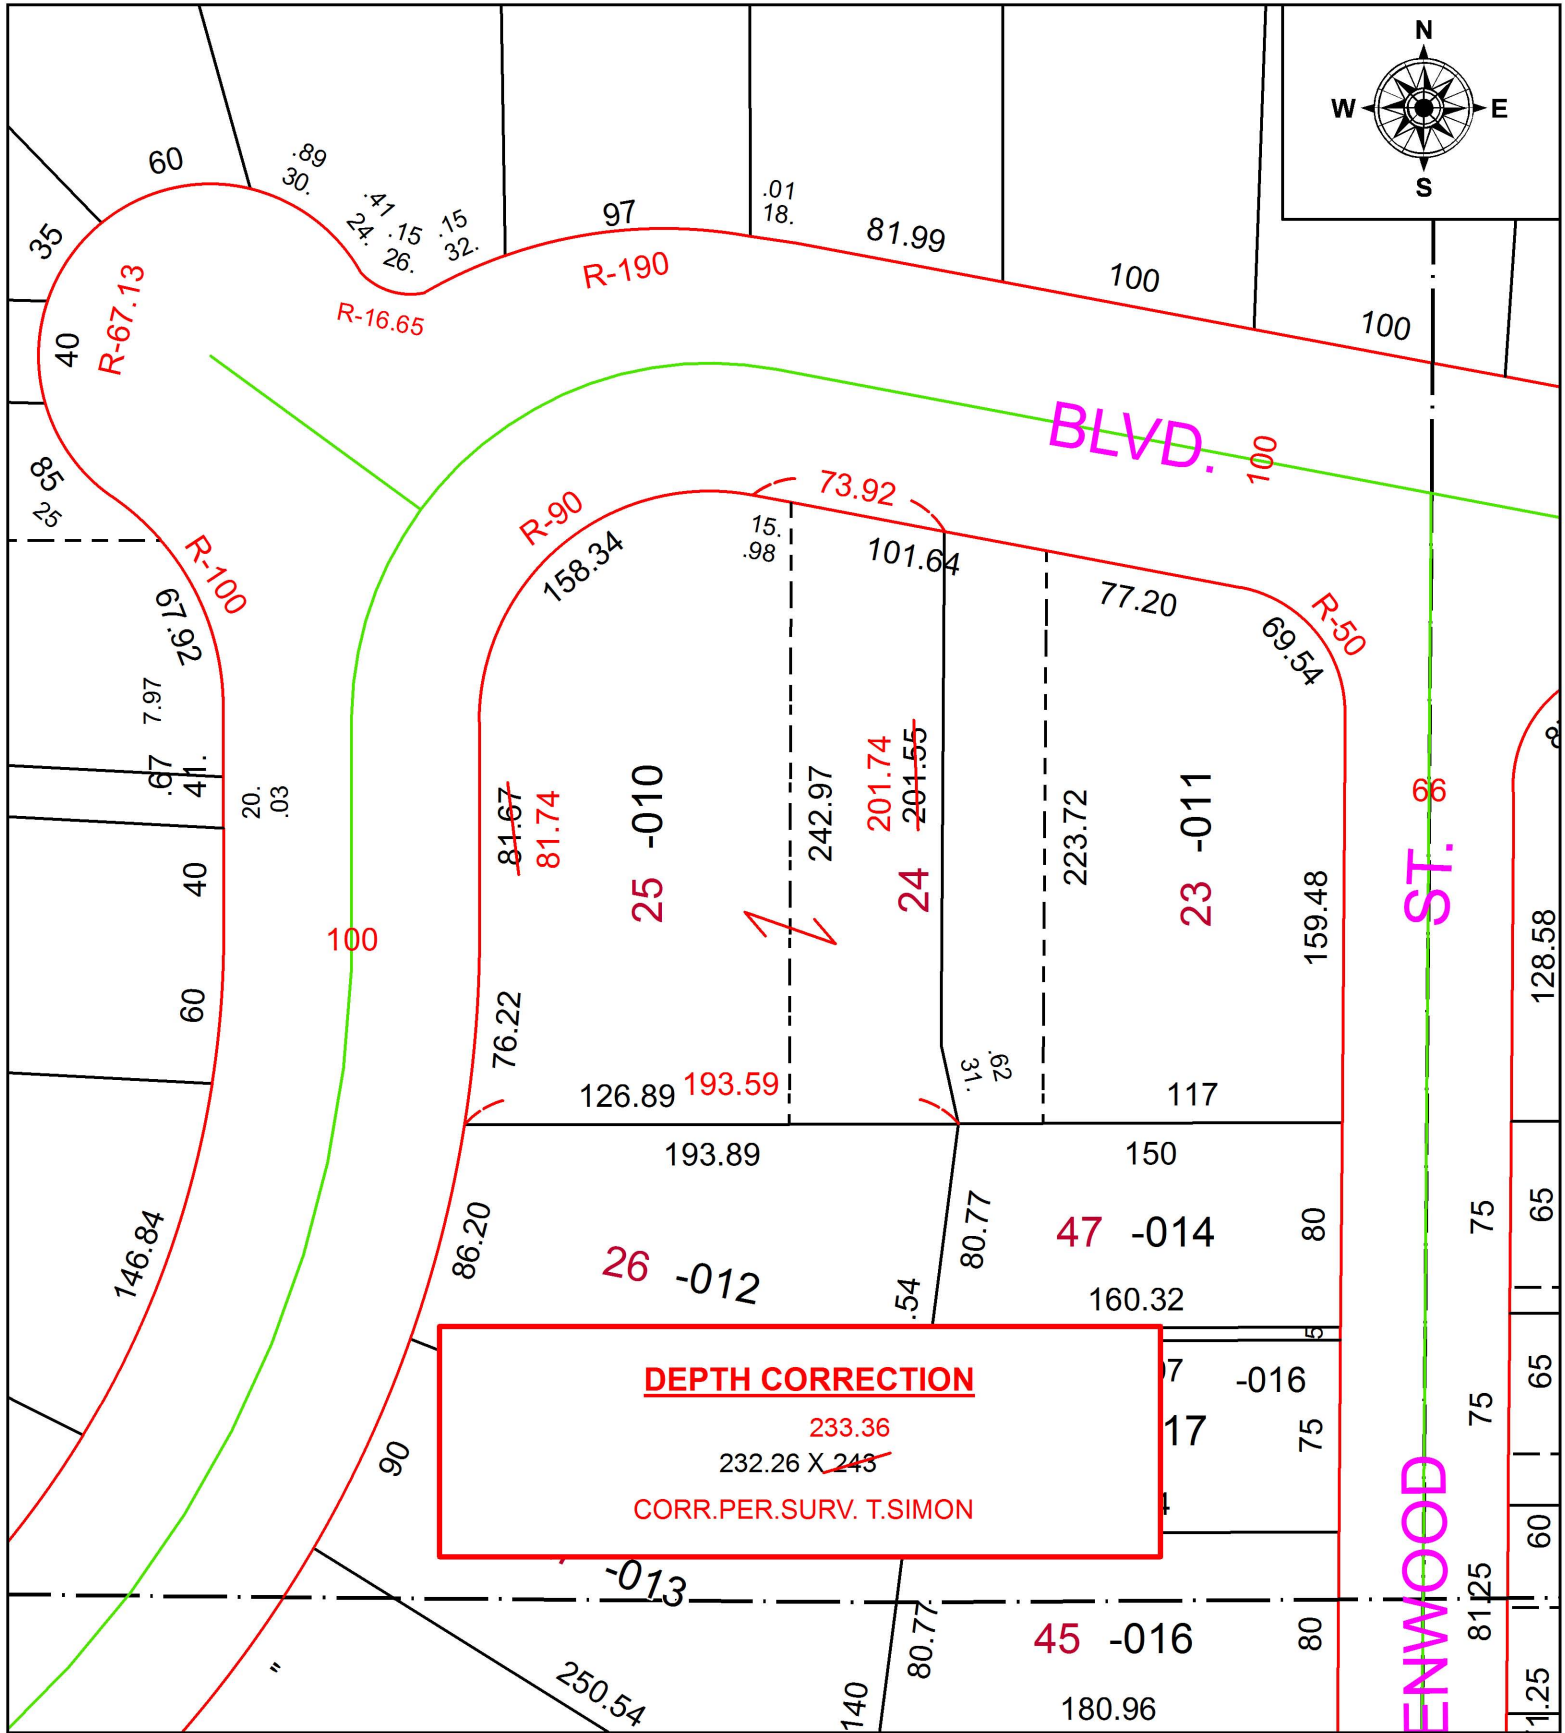

DEPTH CORRECTION
 233.36
 232.26 X ~~243~~
 CORR.PER.SURV. T.SIMON



SPLITS/DEEDS PROCESSED
 LORAIN COUNTY TAX MAP DEPARTMENT
 226 MIDDLE AVE. ELYRIA, OH

SURVEYED BY: THOMAS A. SIMON
 CLOSURE: 1:96,851
 MAP PAGE(S): 6-25-159
 APPROVED BY: RRM DATE: 3-18-20
 SCALE: 1" = 75' PRIOR INSTRUMENT: 20130456735