
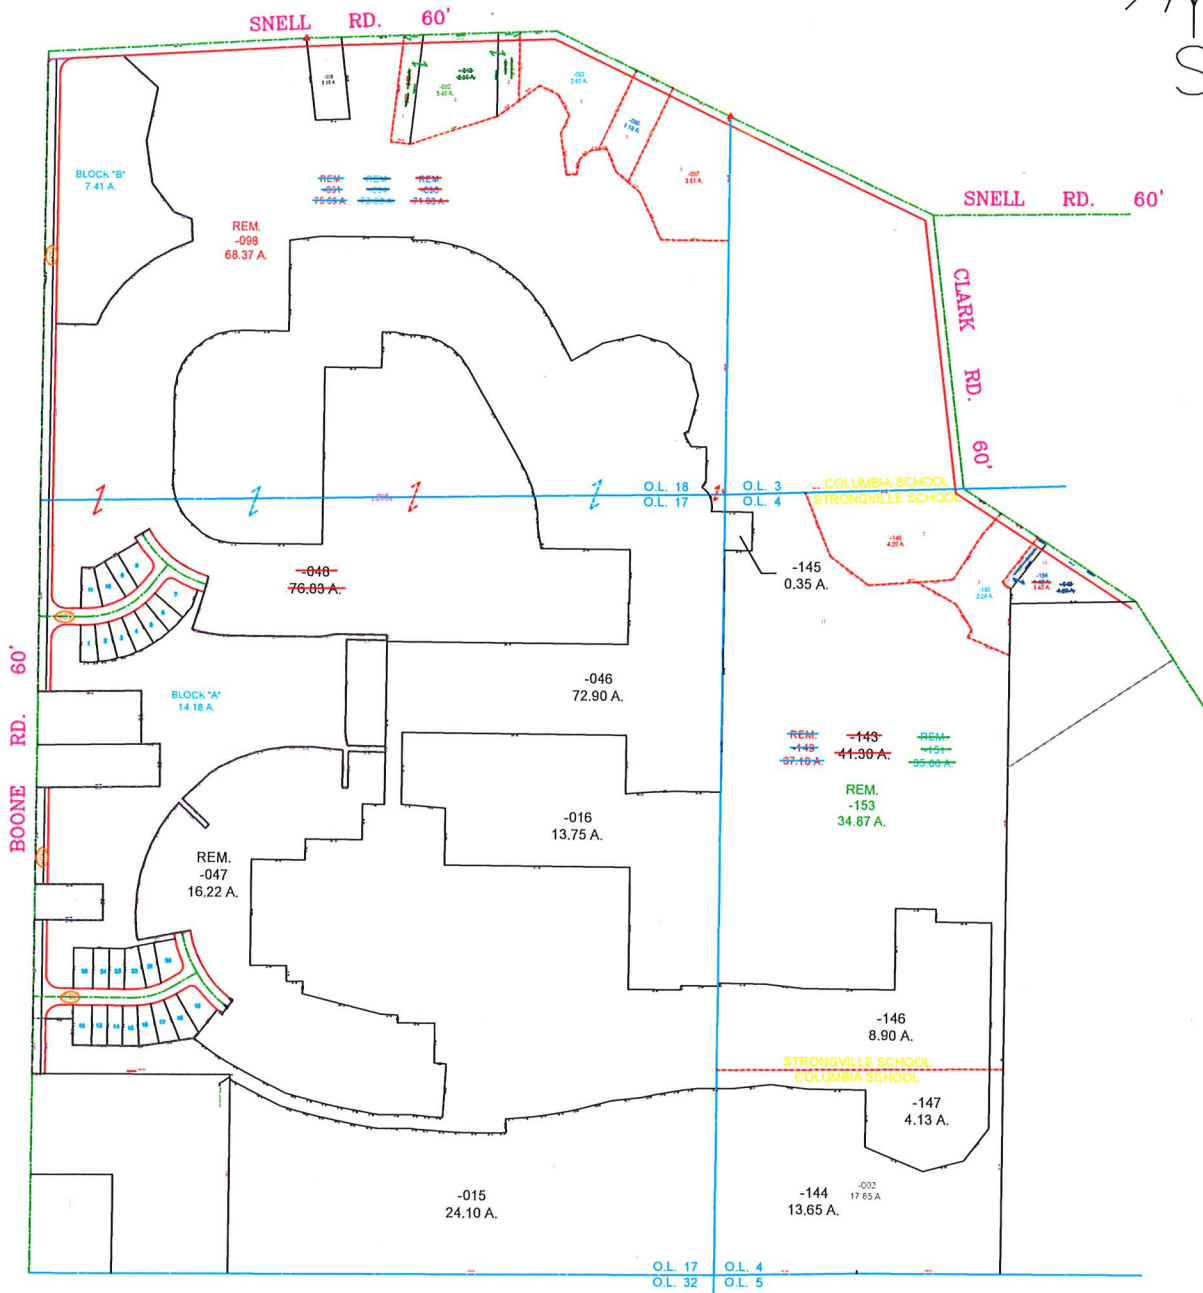


PARENT PARCEL: 12-00-004-000-143 & 12-00-017-000-048

CHILD PARCEL: 12-00-004-000-148 THRU -154 & 12-00-018-000-089 THRU 098

STARTING POINT: NAIL SET CL OF SNELL RD. & CL OF BOONE RD. & CL OF CLARK RD. & NORTH LINE OF O.L. 4

NO. 21-04314

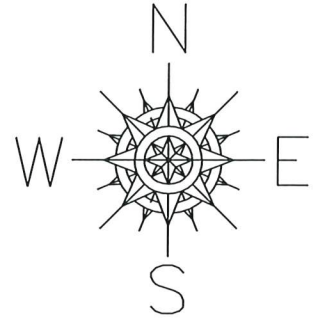

SPLITS/DEEDS PROCESSED

LORAIN COUNTY TAX MAP DEPARTMENT
226 MIDDLE AVE. ELYRIA, OHIO

SURVEYED BY: MICHAEL A. ACKERMAN

CLOSURE: 0.01 : 10.000

MAP PAGE(S): 12-00-004, -017 & -018

APPROVED BY: TJS DATE: 6/25/21

SCALE: 1" = 700 PRIOR INSTRUMENT: 2020-005289