


PARENT PARCEL: 05-00-052-000-046

CHILD PARCEL: 05-00-052-000-063, 05-00-069-000-004

STARTING POINT: INTERSECTION OF C/L OF OBERLIN RD. AND SOUTH LINE OF O.L.52

20-04315-D

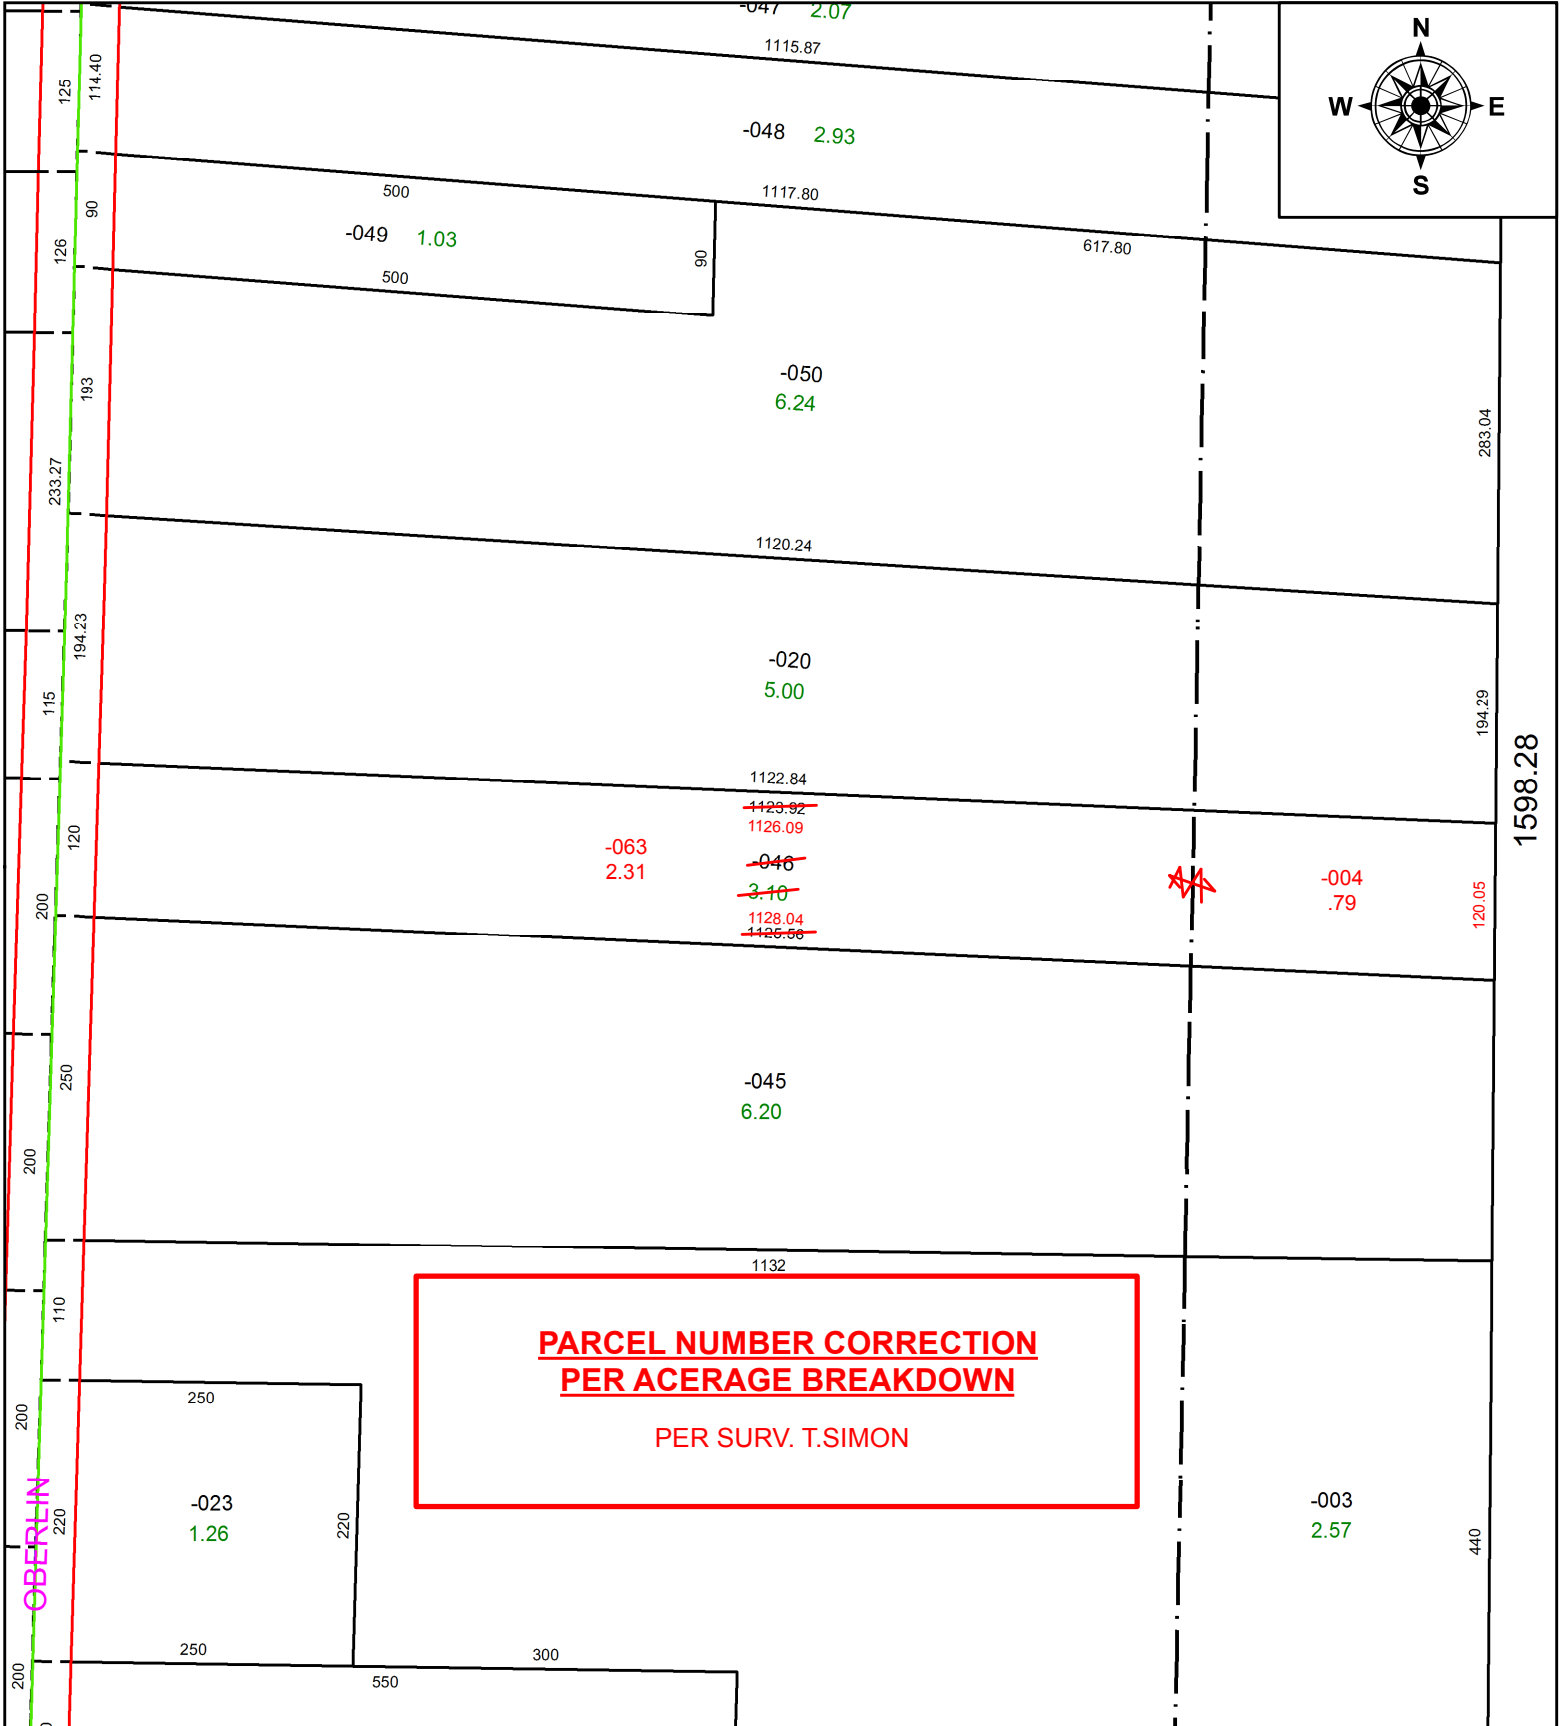

**PARCEL NUMBER CORRECTION
PER ACERAGE BREAKDOWN
PER SURV. T.SIMON**



SPLITS/DEEDS PROCESSED
LORAIN COUNTY TAX MAP DEPARTMENT
226 MIDDLE AVE. ELYRIA, OH

SURVEYED BY: THOMAS A. SIMON
 CLOSURE: 1:1,123,461
 MAP PAGE(S): 5-00-052
 APPROVED BY: RRM DATE: 4-15-20
 SCALE: 1" = 150 PRIOR INSTRUMENT: 20190741826