
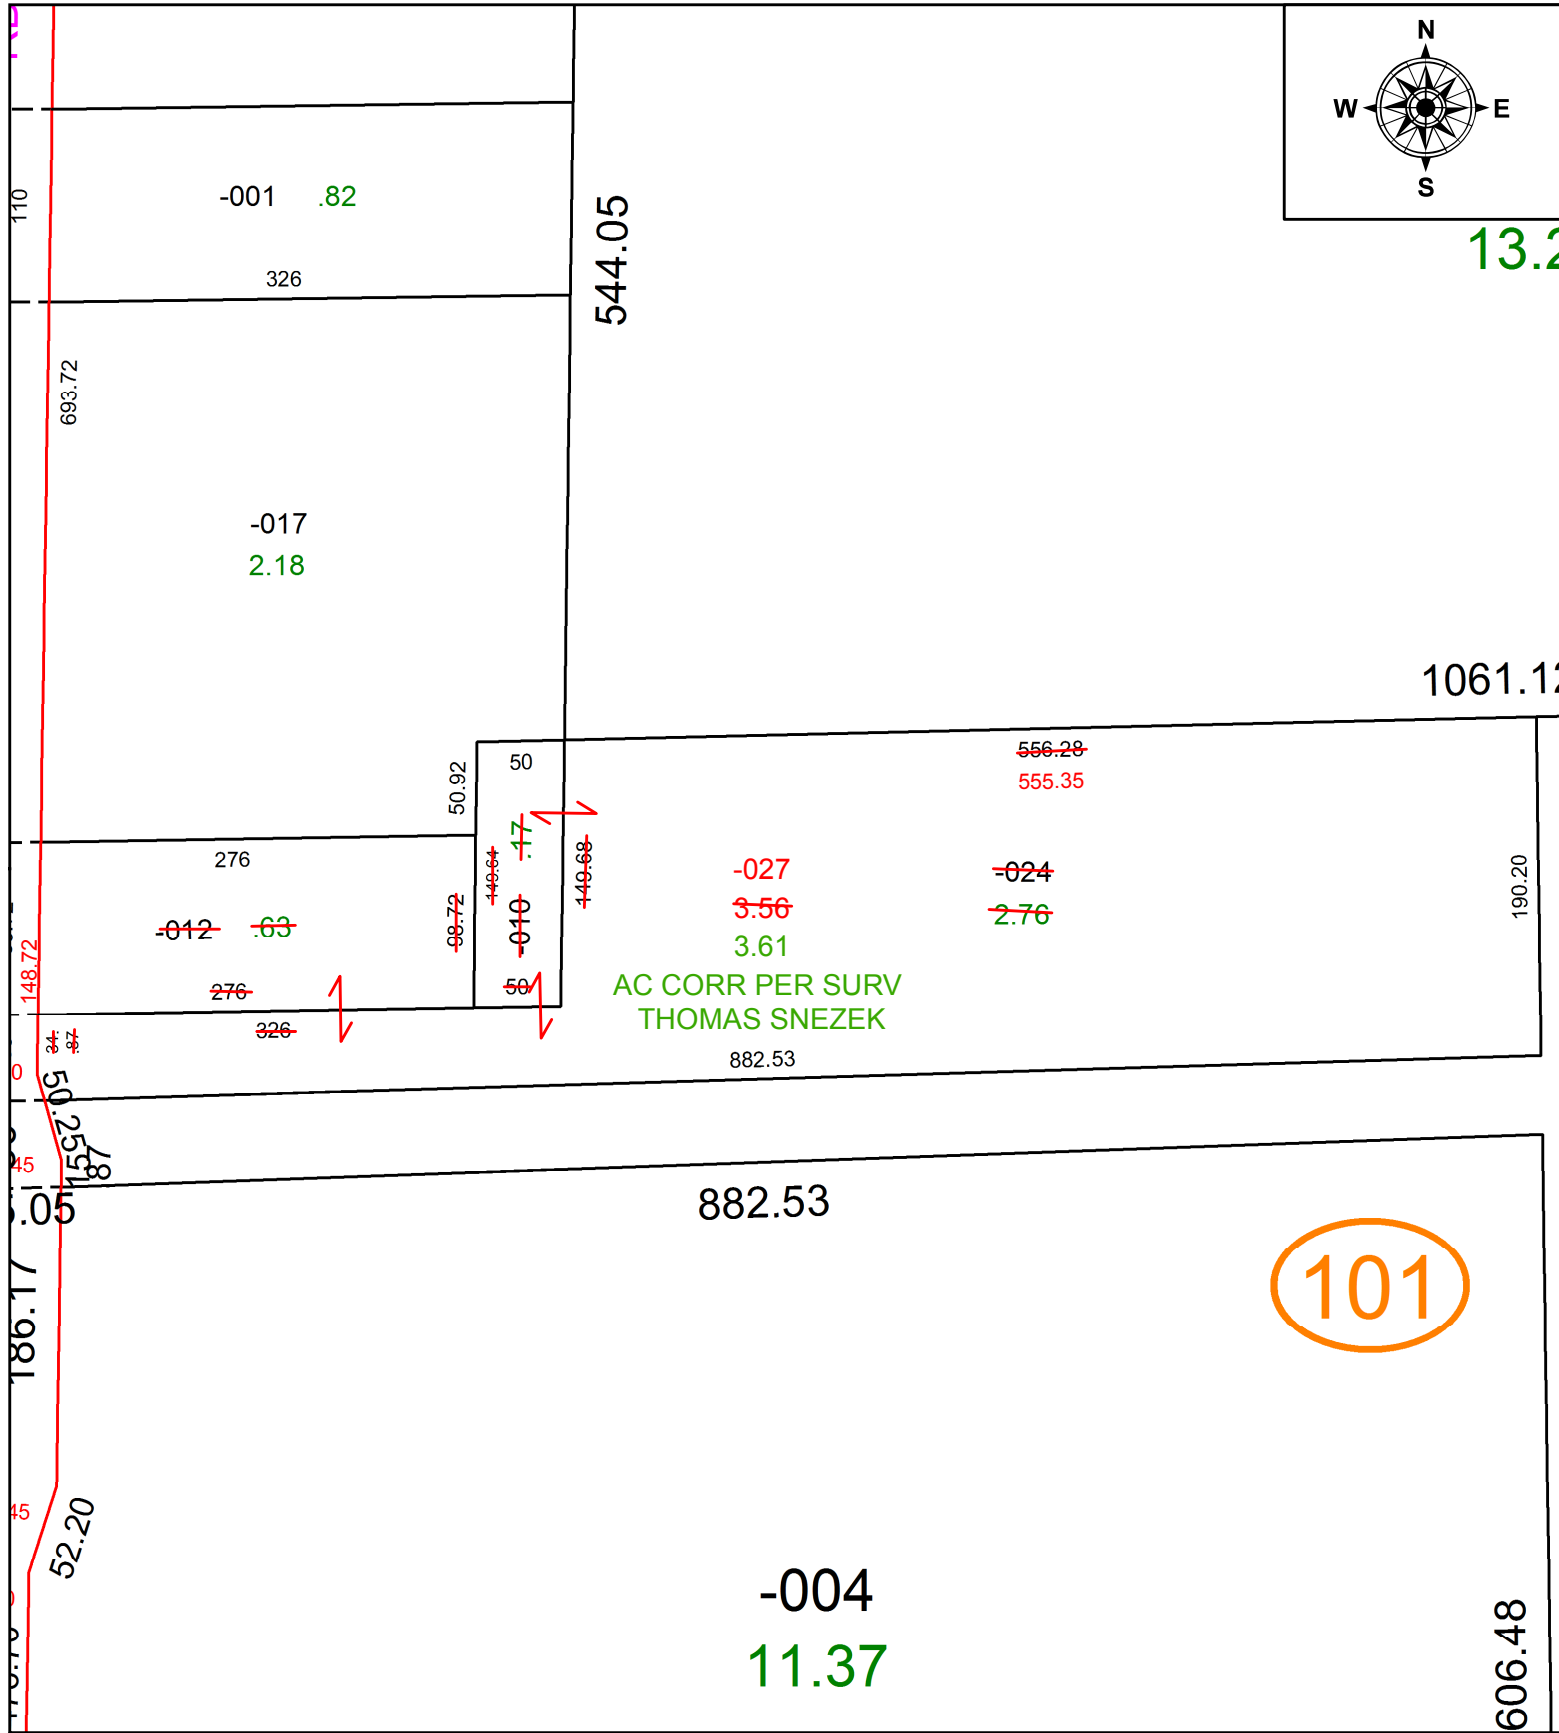


PARENT PARCEL: 06-23-001-101-010, -012, -024

CHILD PARCEL: 06-23-001-101-027


STARTING POINT: C/L OF WEST RIDGE ROAD AND NORTH LINE OF LOT 1 OF BRACE TRACT.

21-04316

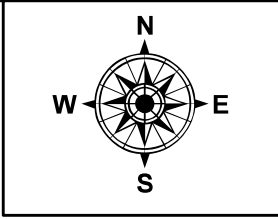

AC CORR PER SURV
THOMAS SNEZEK

101

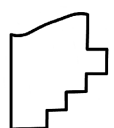

SPLITS/DEEDS PROCESSED
LORAIN COUNTY TAX MAP DEPARTMENT
226 MIDDLE AVE. ELYRIA, OH

SURVEYED BY: THOMAS M. SNEZEK
CLOSURE: 1: 1442275
MAP PAGE(S): 06-19
APPROVED BY: AC DATE: 6/14/2021
SCALE: 1" = 110 PRIOR INSTRUMENT: 1986-0219914