
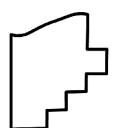


PARENT PARCEL: 05-00-060-105-039

CHILD PARCEL:

STARTING POINT: INTERSECTION OF C/L OF NORTH RIDGE RD, AND C/L OF OBERLIN RD.

20-04325-A

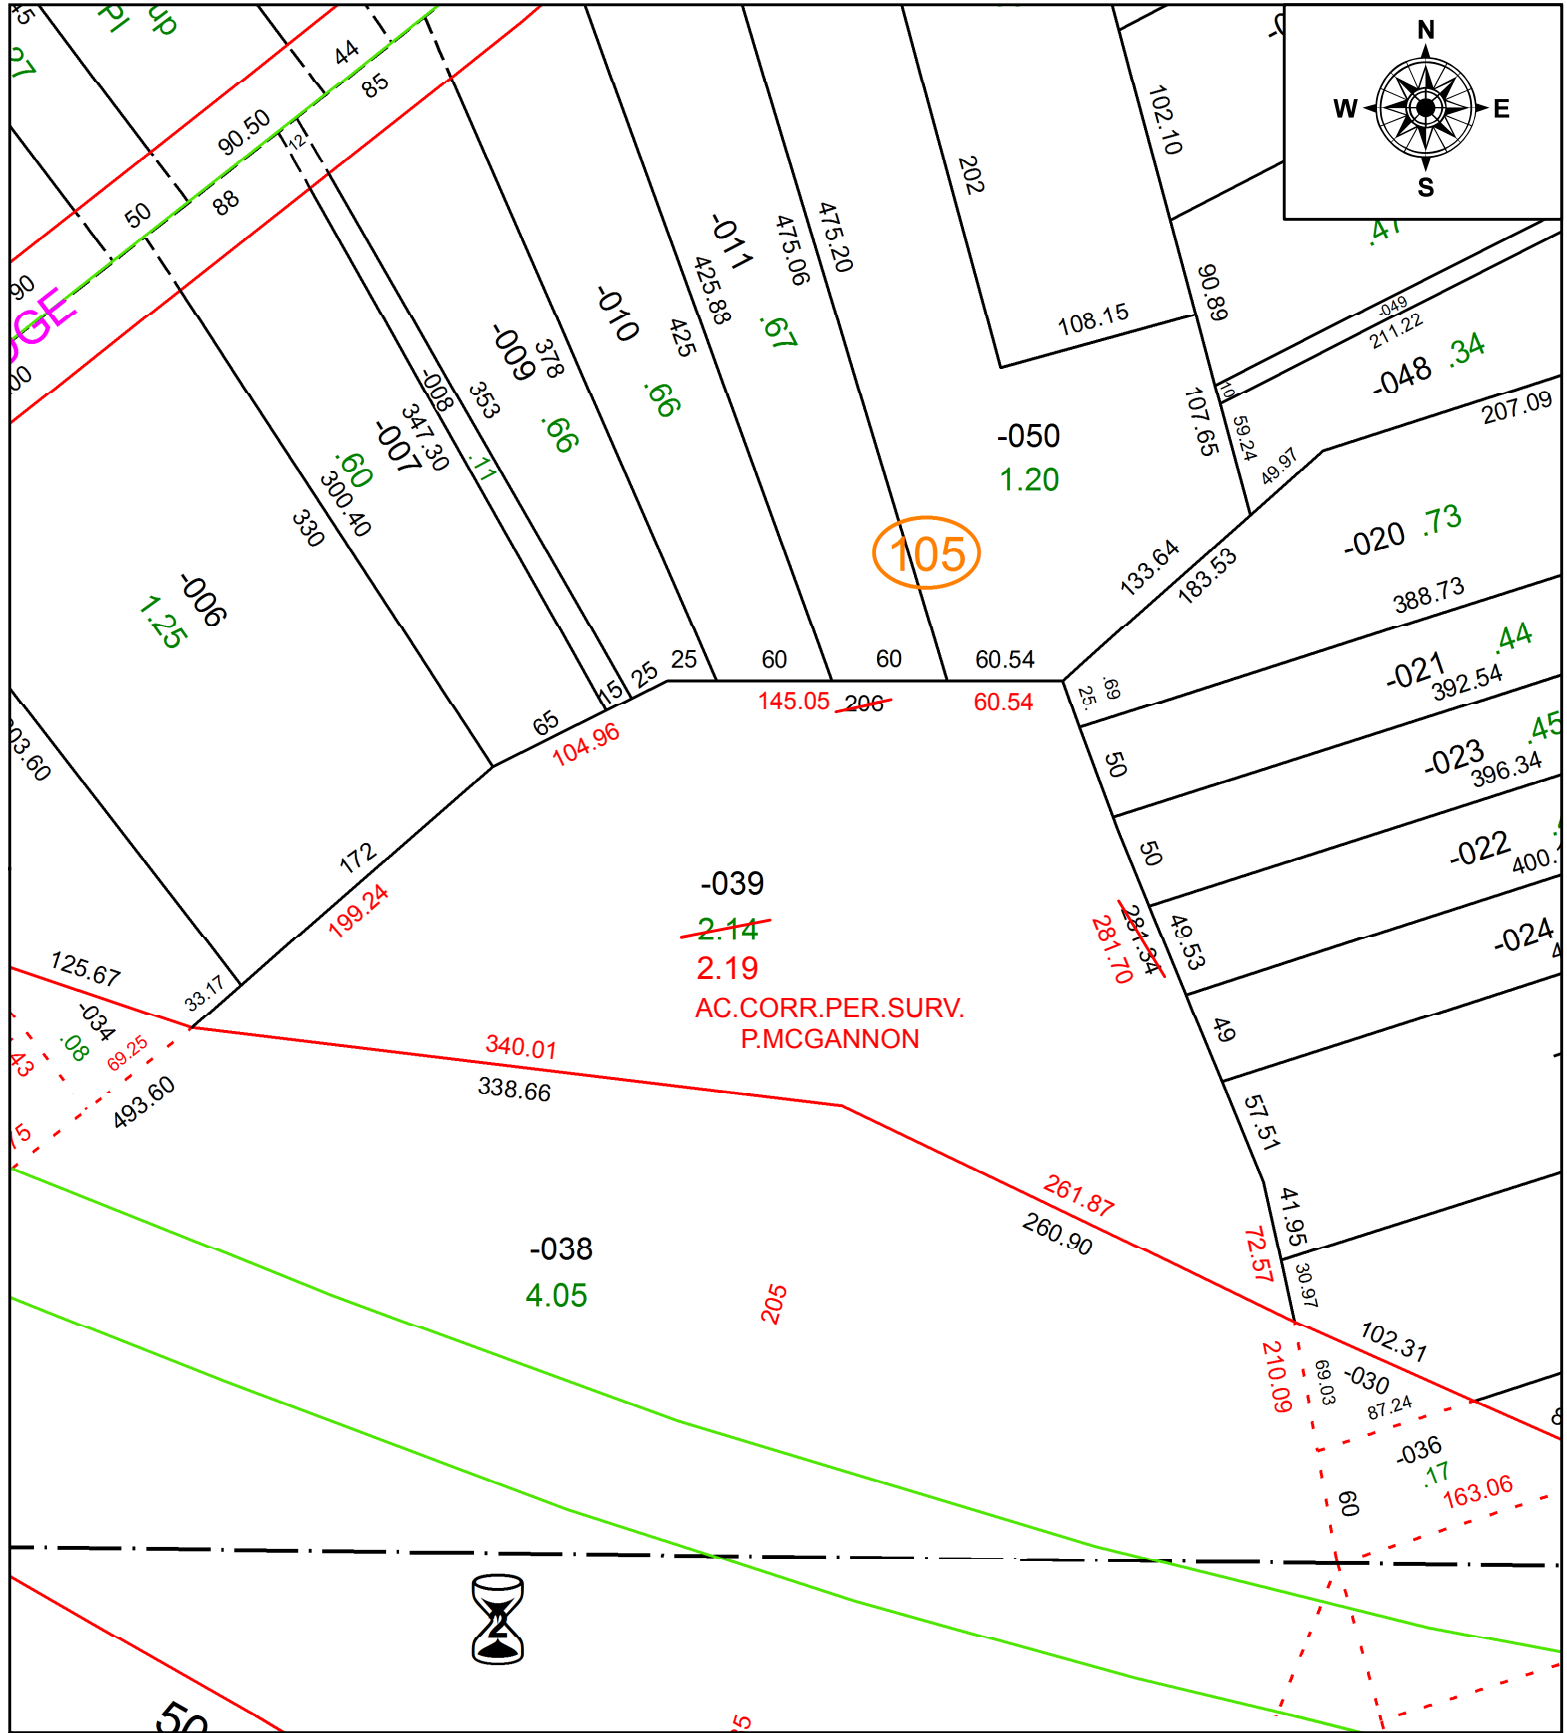

SPLITS/DEEDS PROCESSED
 LORAIN COUNTY TAX MAP DEPARTMENT
 226 MIDDLE AVE. ELYRIA, OH

SURVEYED BY: PATRICK A. MCGANNON
CLOSURE: 1:286,721
MAP PAGE(S): 5-00-060
APPROVED BY: RRM **DATE:** 5-6-20
SCALE: 1" = 100 **PRIOR INSTRUMENT:** 20180667246