
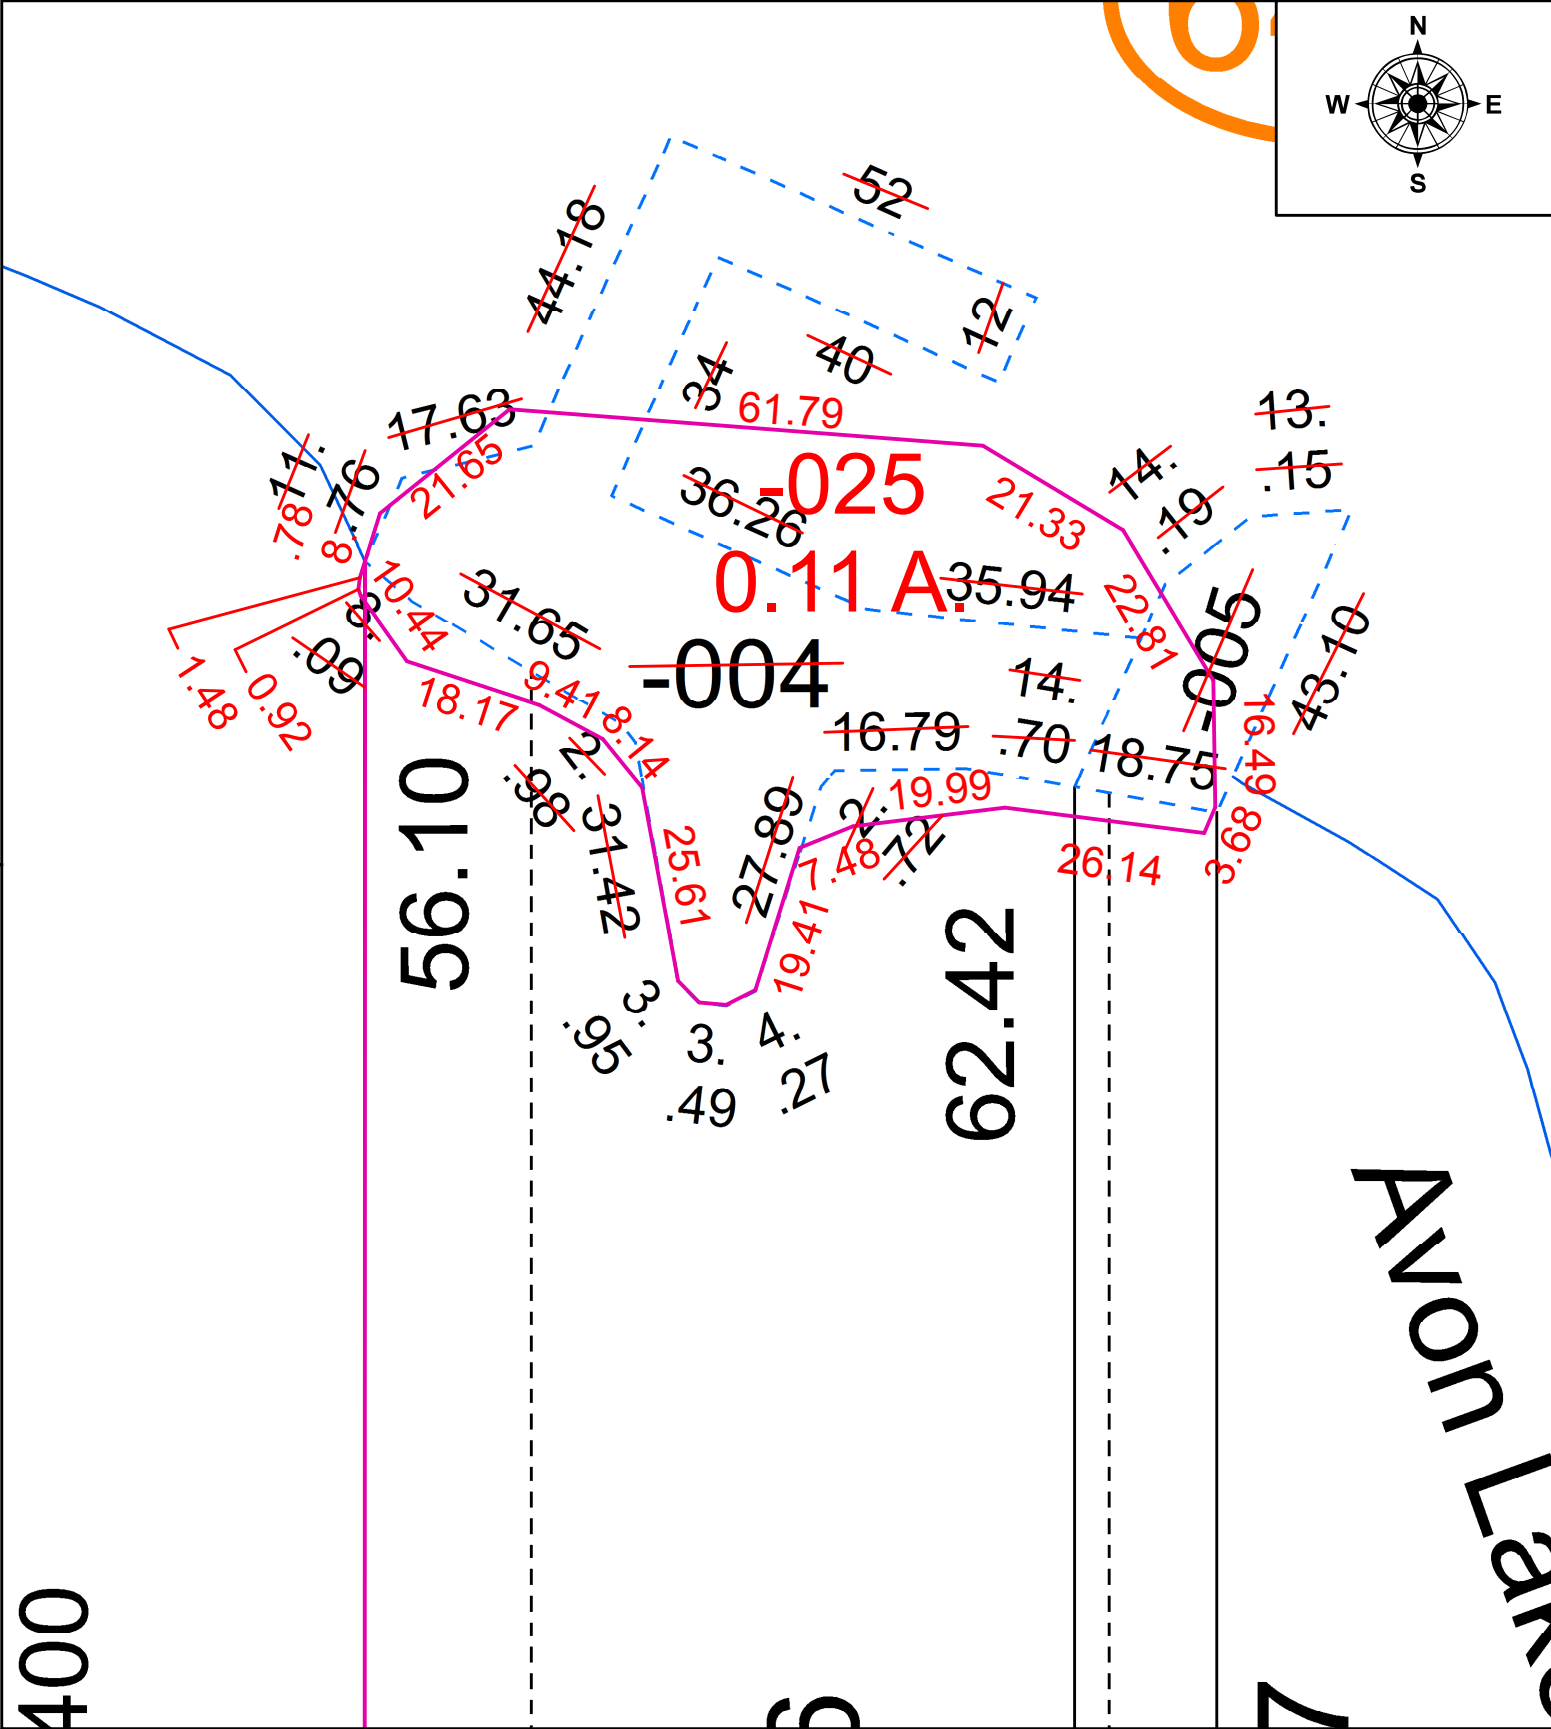


PARENT PARCEL: DROP FROM DUPLICATE 04-00-030-640-004 SUB-0934-LO & -005 SUB-2321-LO
 CHILD PARCEL: ADD TO DUPLICATE 04-00-030-640-025 0.11 A. SUBMERGED LAND LEASE SUB-2505-LO
 STARTING POINT: DRILL HOLE IN STONE MON., CL OF LAKE RD. & CL OF NORTH POINT DR. EXTENSION

21-04327

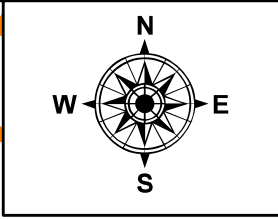


400

50

7

AVON LAKE

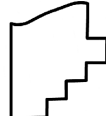 **SPLITS/DEEDS PROCESSED**
 LORAIN COUNTY TAX MAP DEPARTMENT
 226 MIDDLE AVE. ELYRIA, OH

SURVEYED BY: TREVOR BIXLER
 CLOSURE: 1: 33,000
 MAP PAGE(S): 04-00-030
 APPROVED BY: TJS DATE: 7/19/2021
 SCALE: 1" = 25' PRIOR INSTRUMENT: 2009-0305927