
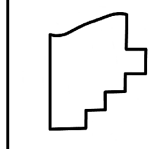
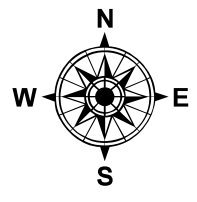


PARENT PARCEL: 04-00-015-108-040 & -045

CHILD PARCEL: 04-00-015-108-046 thru -048

STARTING POINT: CL OF DETROIT RD. & GARDEN DR.

21-04328

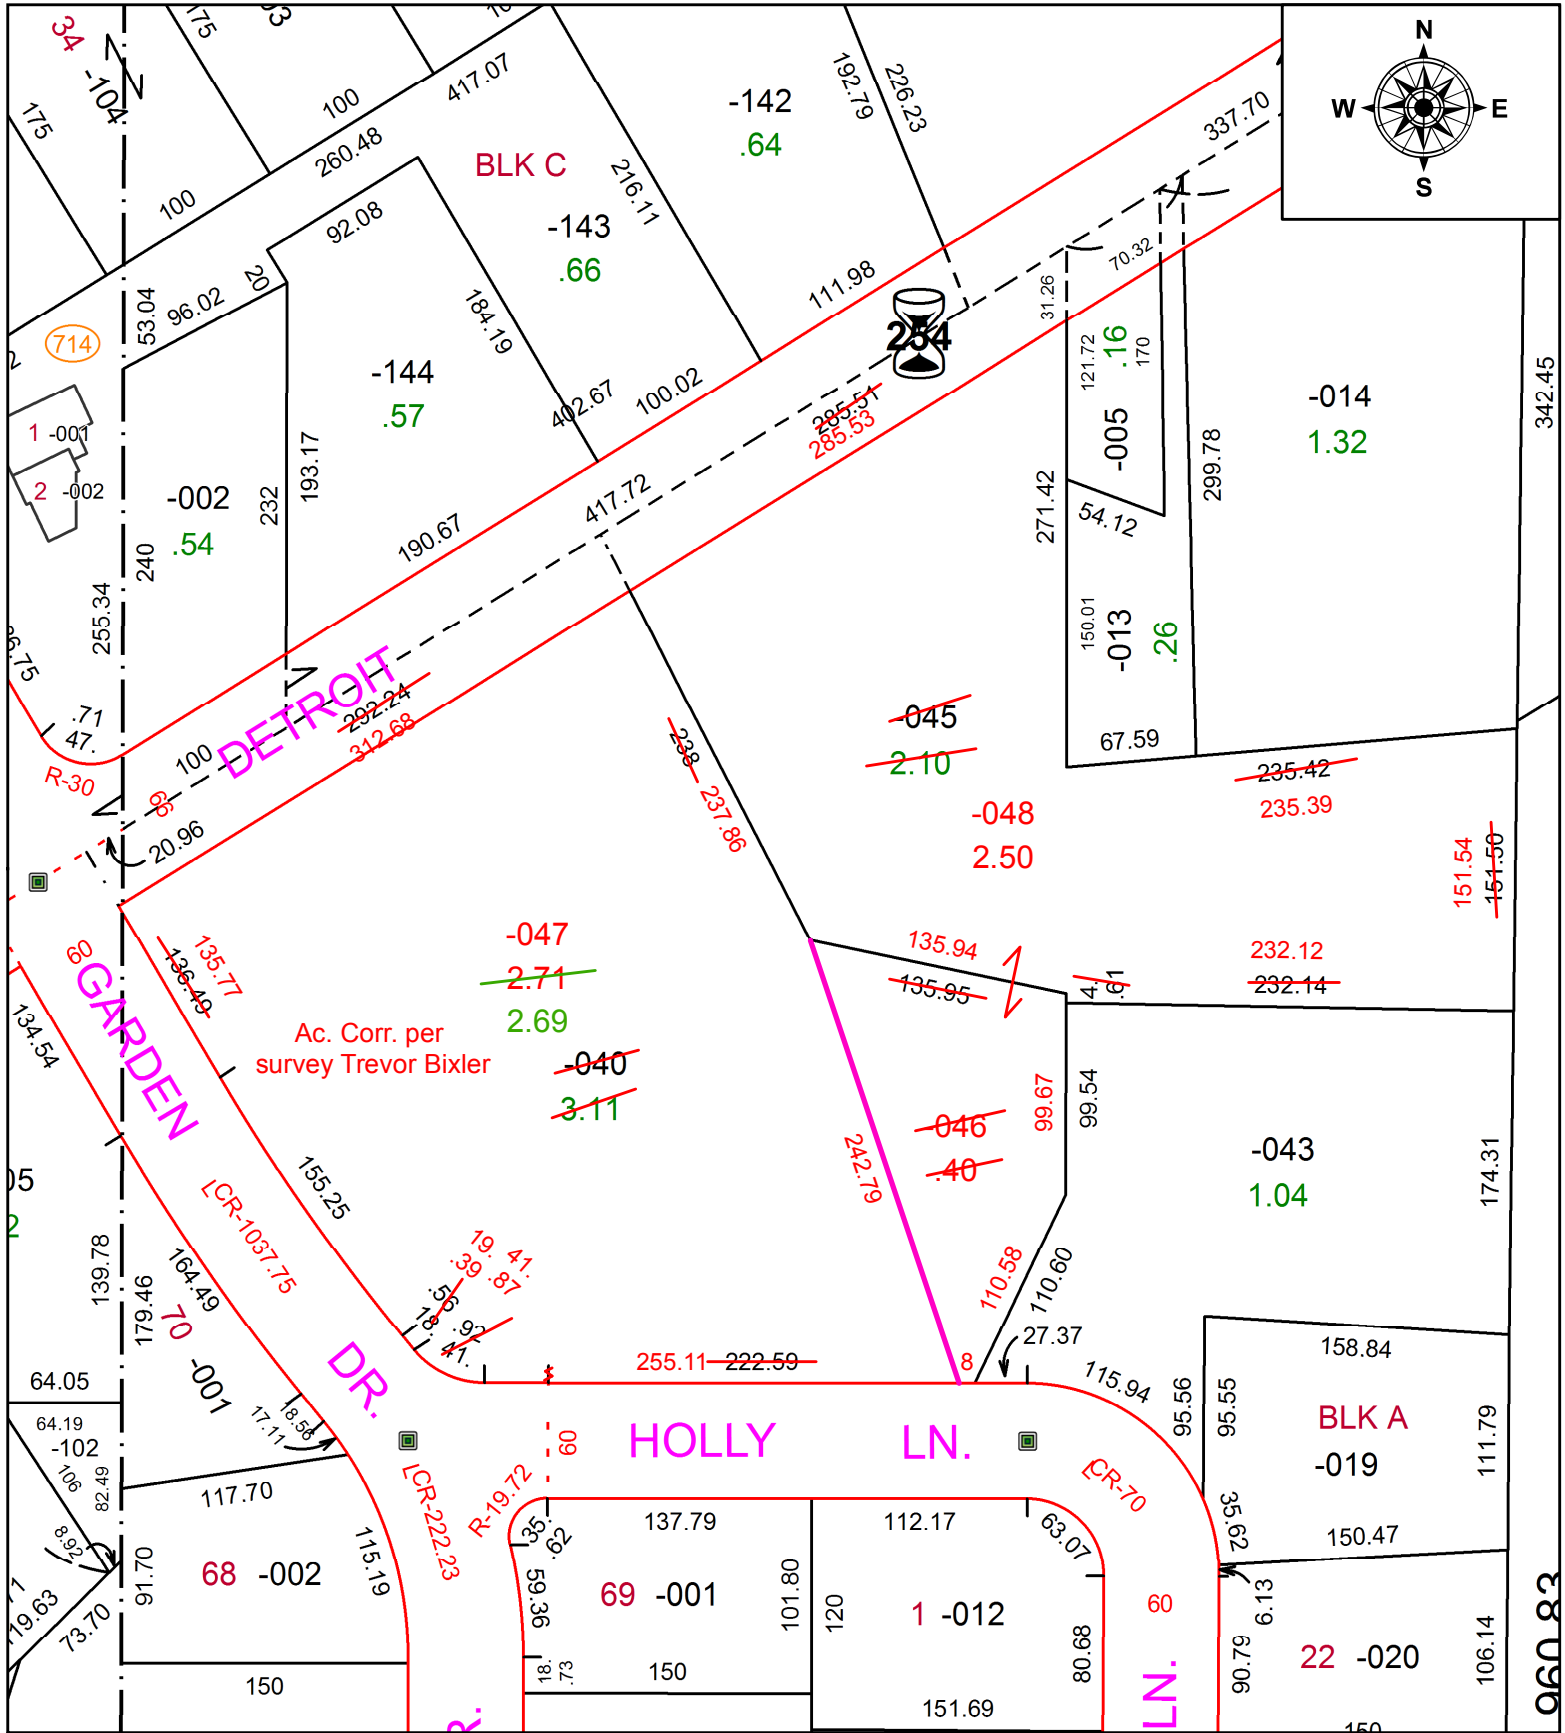

SPLITS/DEEDS PROCESSED
 LORAIN COUNTY TAX MAP DEPARTMENT
 226 MIDDLE AVE. ELYRIA, OH

SURVEYED BY: TREVOR BIXLER
CLOSURE: 1: 902,803
MAP PAGE(S): 04-00-015
APPROVED BY: DMA **DATE:** 7/16/2021
SCALE: 1" = 100 **PRIOR INSTRUMENT:** 20050119334