
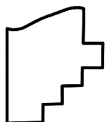


PARENT PARCEL: 03-00-035-101-007, -009 THRU -012

CHILD PARCEL: 03-00-035-101-029

21-04330

STARTING POINT: NORTHEAST CORNER OF SUBLOT 8 IN BORDER CITIES CO'S SHORE SUBDIVISION

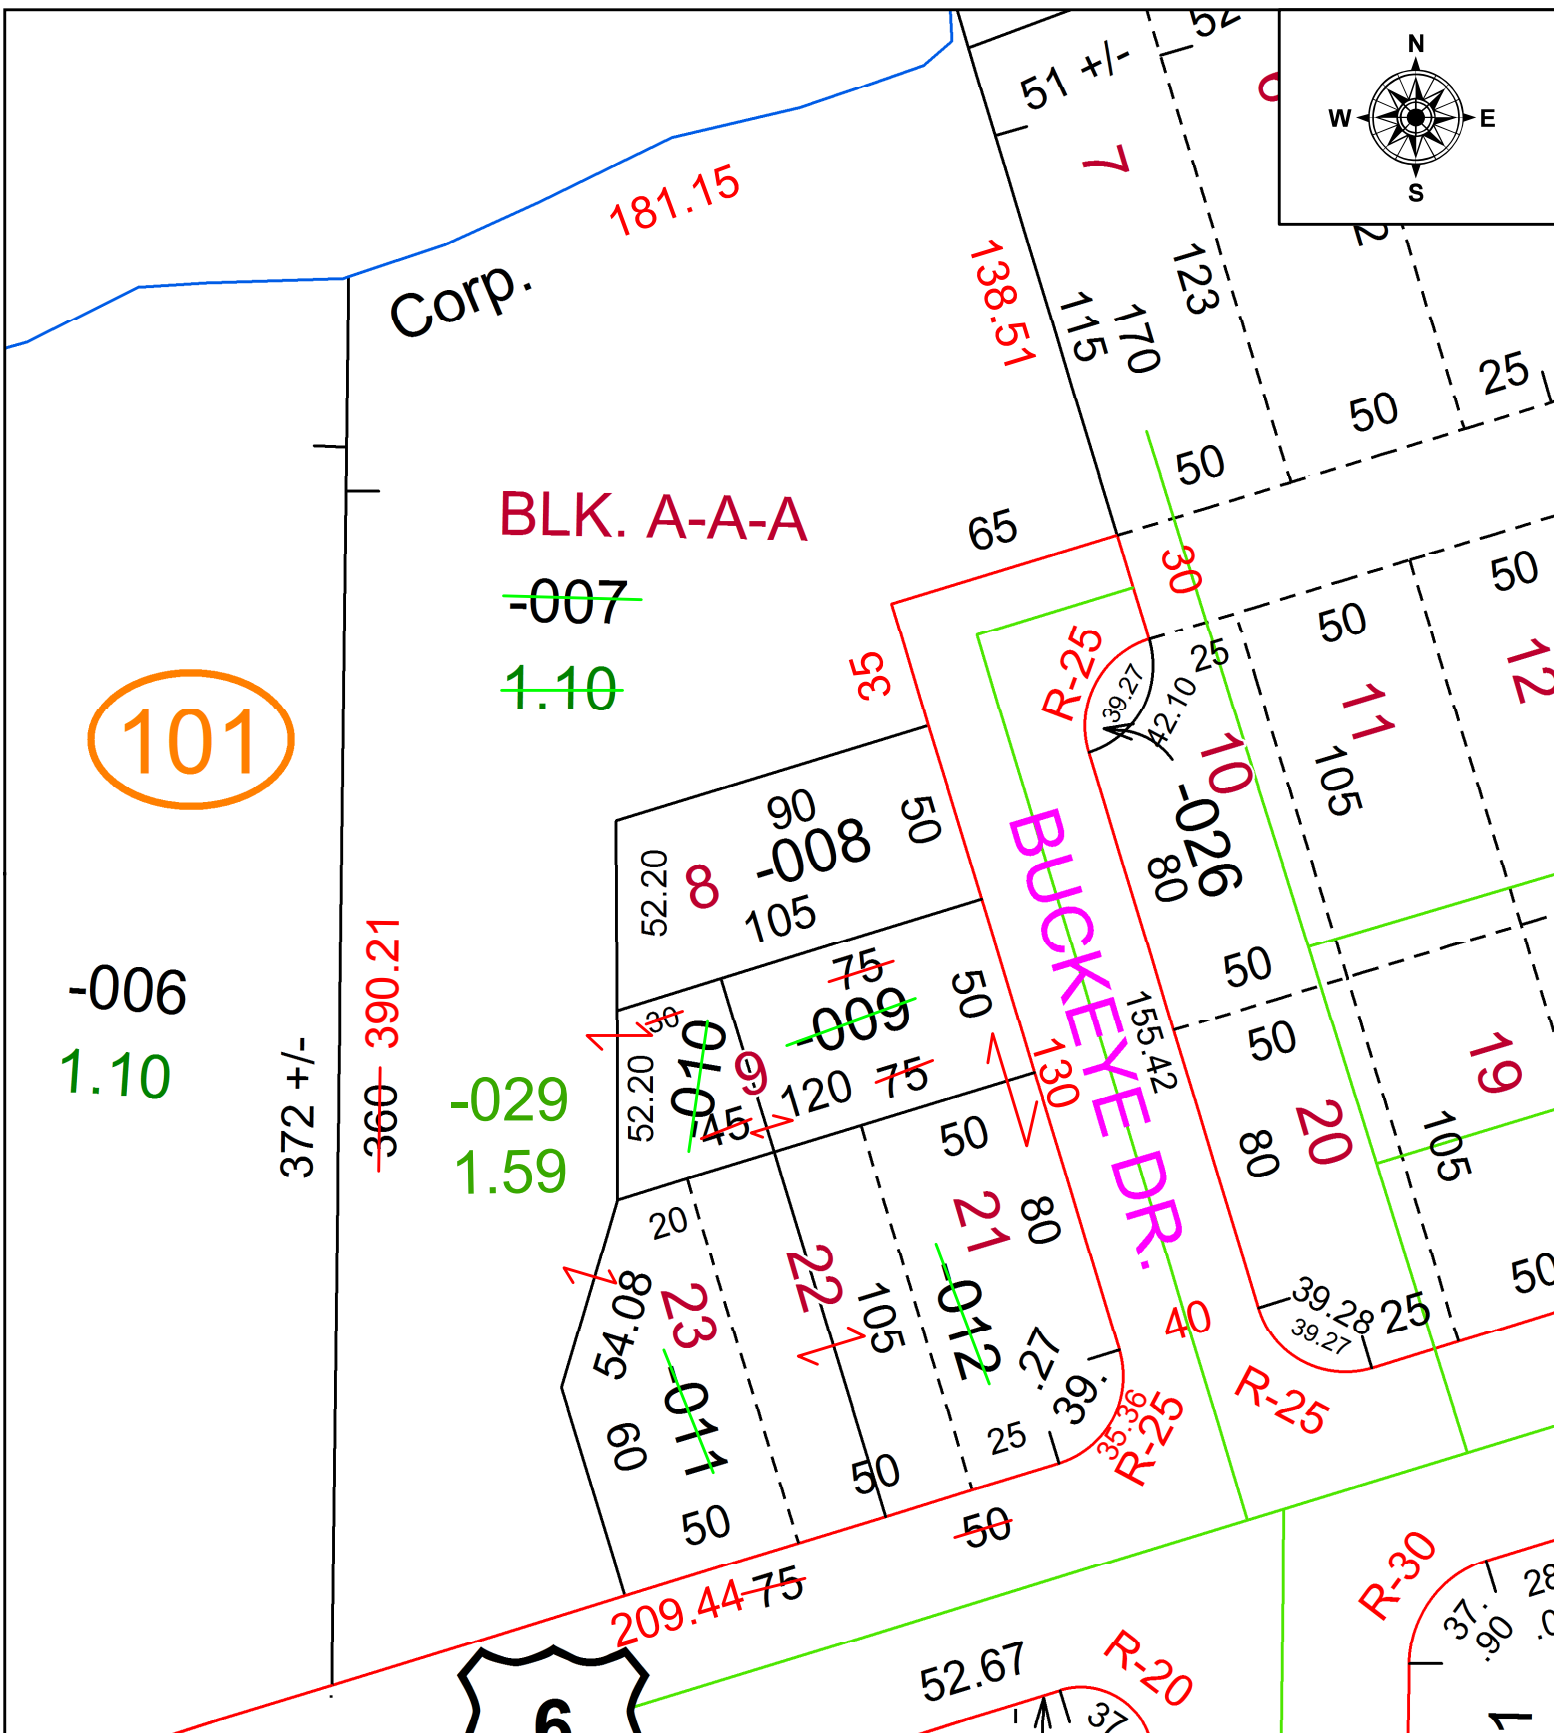

SPLITS/DEEDS PROCESSED
 LORAIN COUNTY TAX MAP DEPARTMENT
 226 MIDDLE AVE. ELYRIA, OH

SURVEYED BY: JOSEPH A BURGOON

CLOSURE: 1:430,144

MAP PAGE(S): 03-00-035

APPROVED BY: WRZ **DATE:** 7/21/2021

SCALE: 1" = 50 **PRIOR INSTRUMENT:** 2021-0829797