
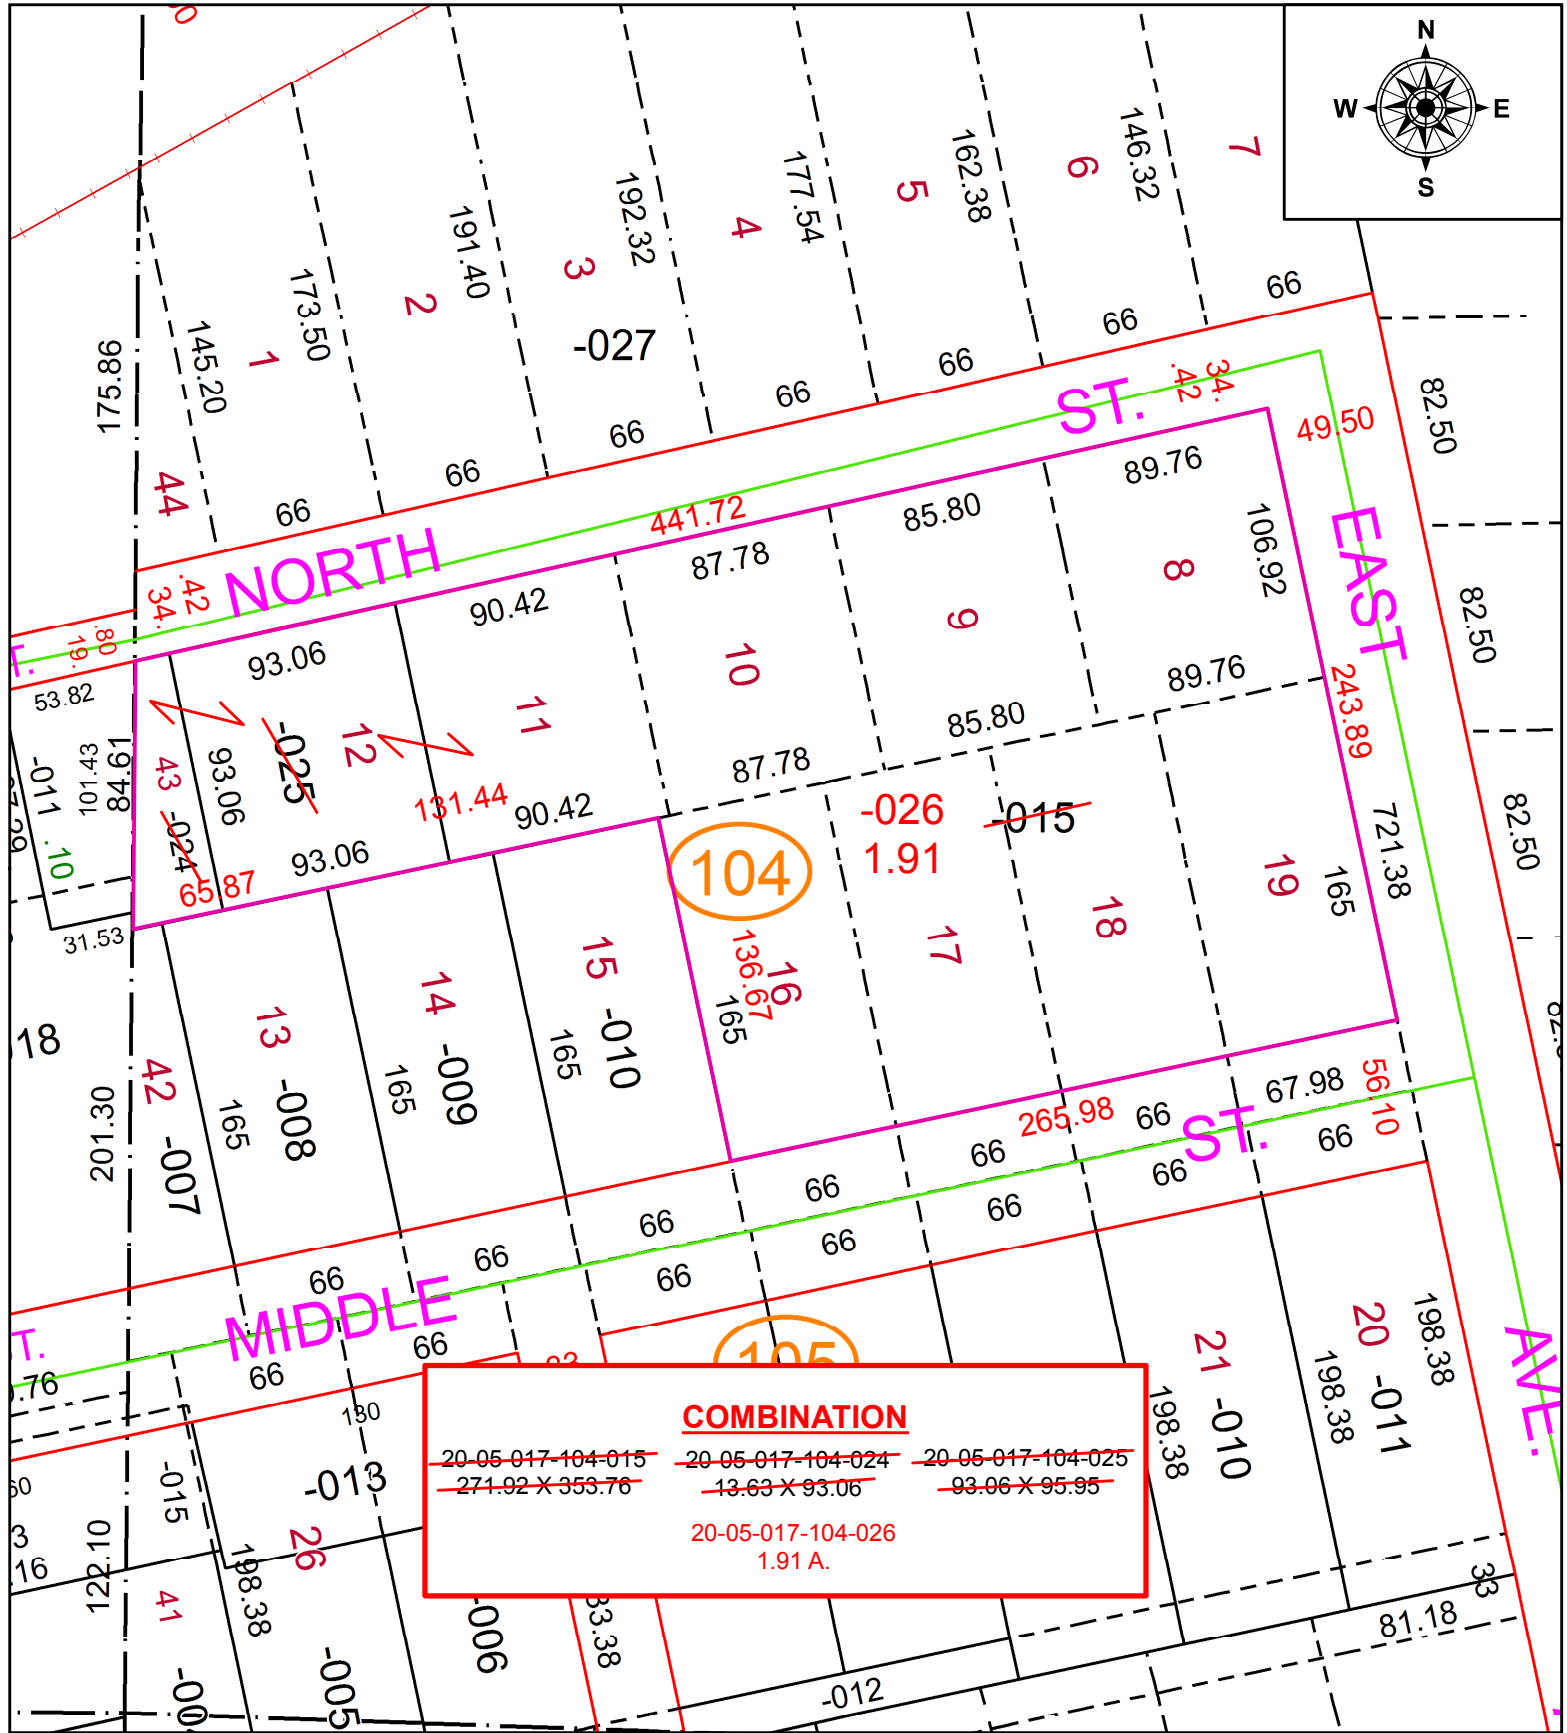


PARENT PARCEL: 20-05-017-104-015, -024, -025


CHILD PARCEL: 20-05-017-104-026

STARTING POINT: NORTHWEST CORNER OF S/L 13 IN WHEELER & MITCHELL ADD

20-04334-D

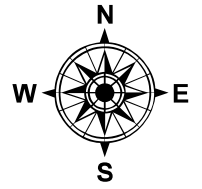

COMBINATION		
20-05-017-104-015	20-05-017-104-024	20-05-017-104-025
271.92 X 353.76	13.63 X 93.06	93.06 X 95.95
20-05-017-104-026 1.91 A.		

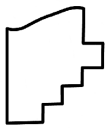

SPLITS/DEEDS PROCESSED
LORAIN COUNTY TAX MAP DEPARTMENT
226 MIDDLE AVE. ELYRIA, OH

SURVEYED BY: JASON K. LAUGHERY
CLOSURE: 1:278,459
MAP PAGE(S): 20-05-017
APPROVED BY: RRM **DATE:** 5-20-20
SCALE: 1" = 75 **PRIOR INSTRUMENT:** 20150547506