
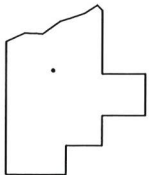


PARENT PARCEL: 05-00-023-112-037 & -040

CHILD PARCEL: **MAP AND ACREAGE CORRECTION**

STARTING POINT: DRILL HOLE SET, SOUTHEAST CORNER OF SUBLOT 1

**20-04336-C**

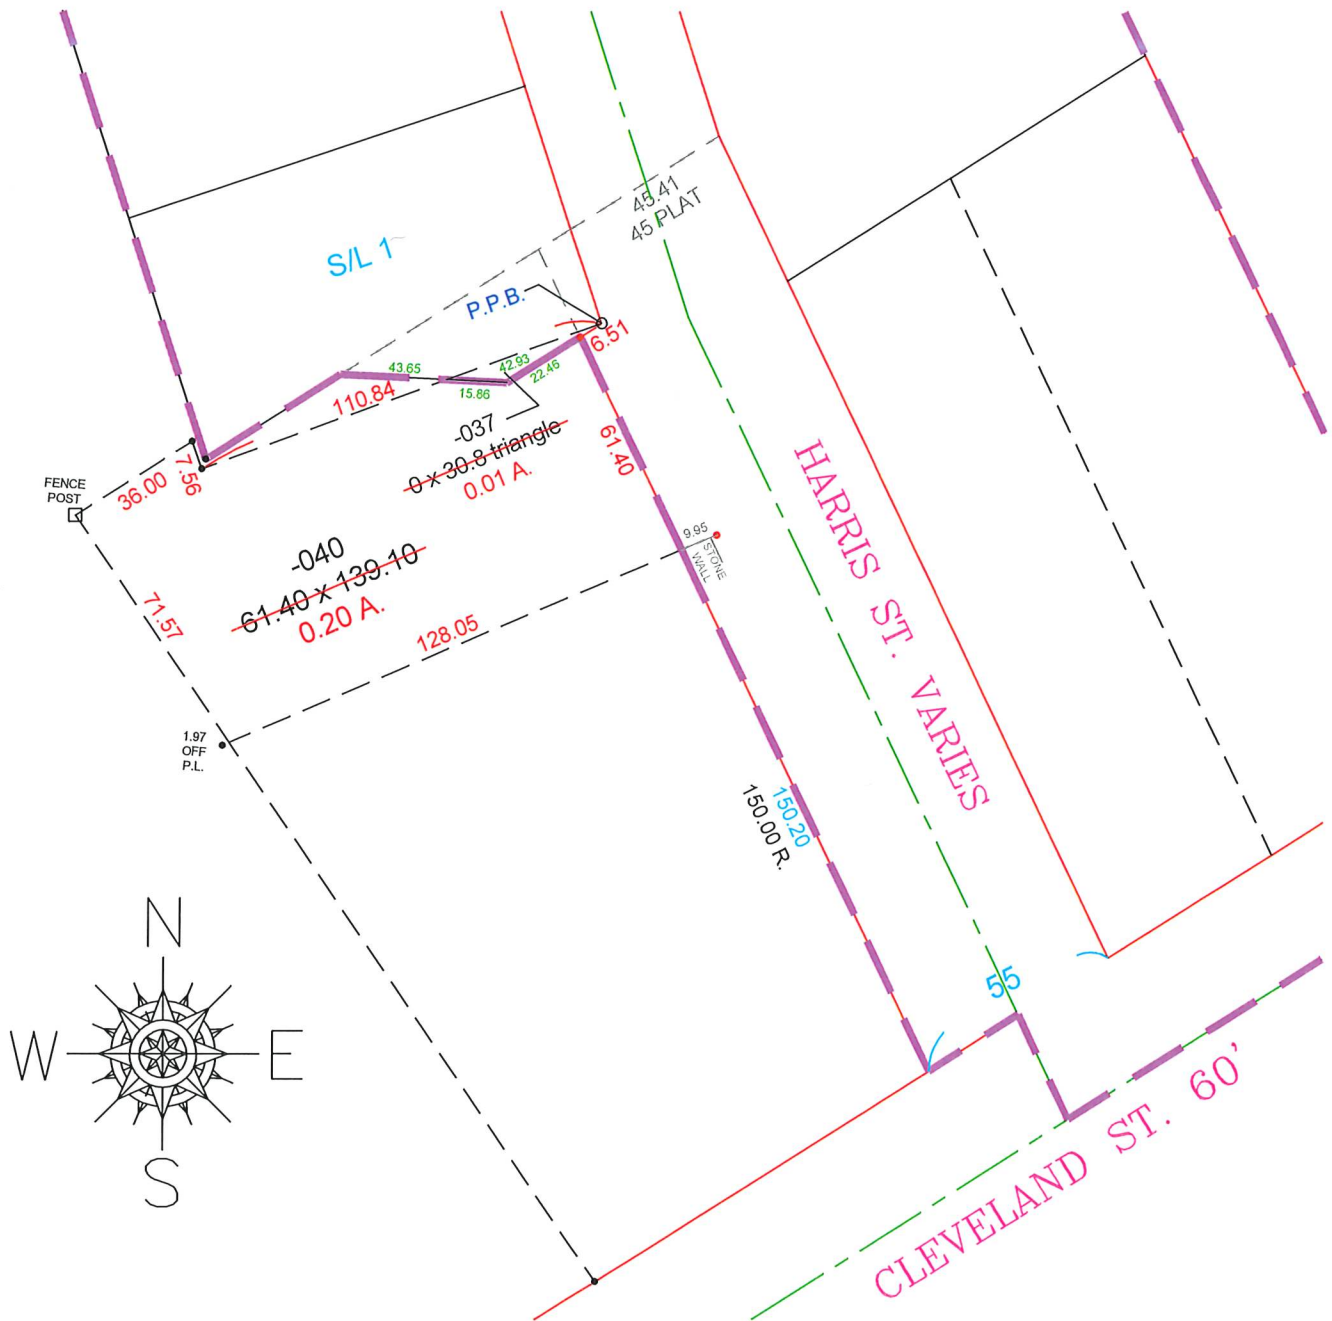

**SPLITS/DEEDS PROCESSED**

LORAIN COUNTY TAX MAP DEPARTMENT  
226 MIDDLE AVE. ELYRIA, OHIO

SURVEYED BY: WILFREDO BARBOSA  
 CLOSURE: 0.01 : 10,000  
 MAP PAGE(S): 05-00-023  
 APPROVED BY: TJS DATE: 5/20/20  
 SCALE: 1" = 50' PRIOR INST.: 2014-0497919