


PARENT PARCEL: 02-00-051-139-024,-028,-029,-032 & 02-00-051-143-007 & -008, & 02-00-052-000-003 & -004

CHILD PARCEL: 02-00-051-139-033, 02-00-051-143-009, & 02-00-052-000-010

STARTING POINT: MAG. NAIL SET, CL OF BRIDGE DR. & CL OF IDAHO AVE.

21-04343

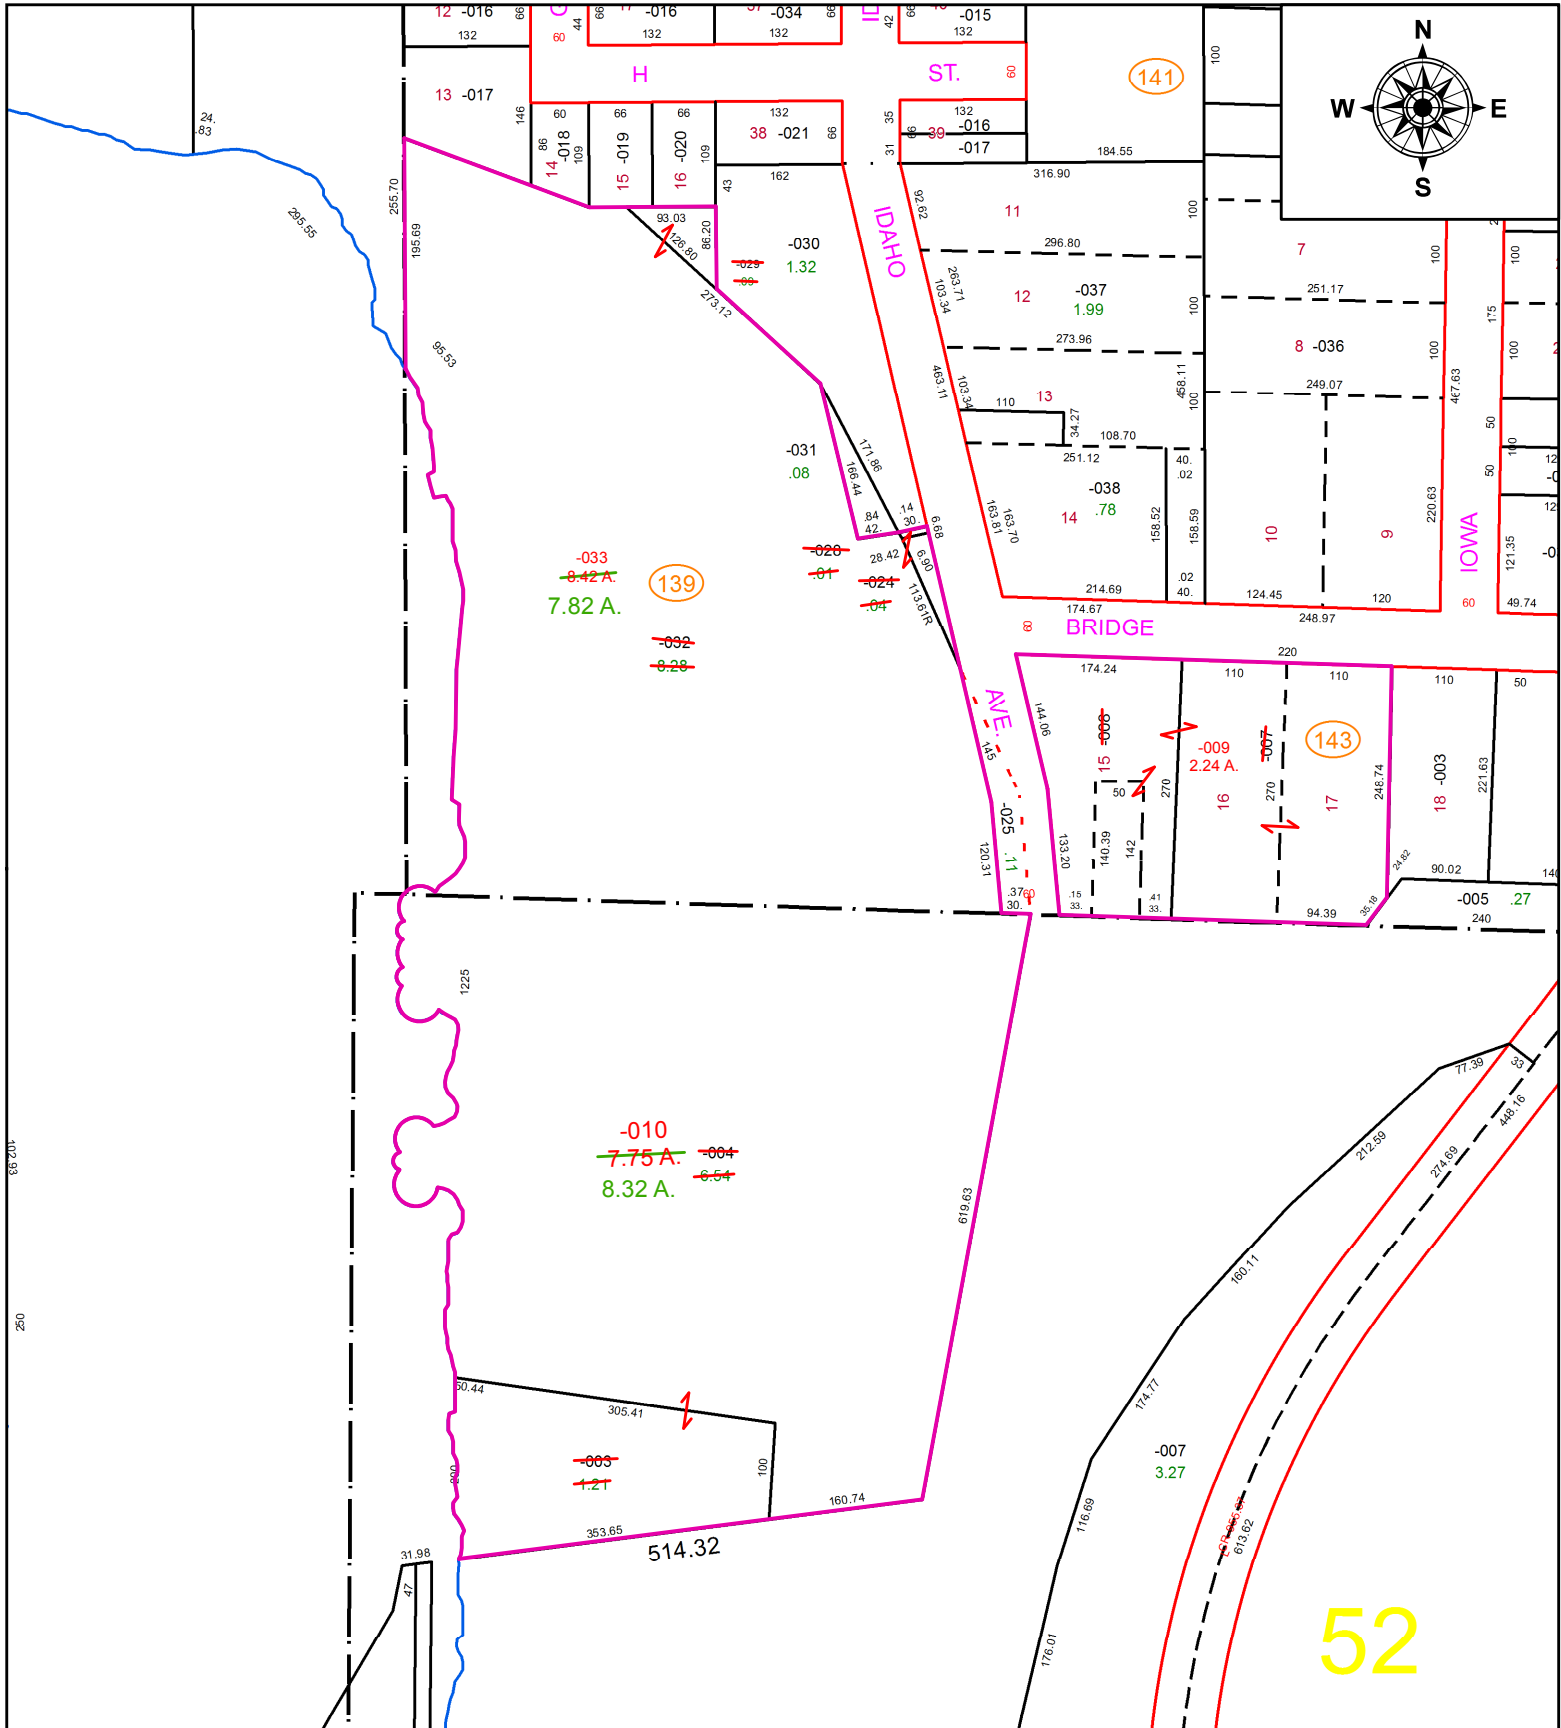

**SPLITS/DEEDS PROCESSED**  
LORAIN COUNTY TAX MAP DEPARTMENT  
226 MIDDLE AVE. ELYRIA, OH

SURVEYED BY: DARRELL PLUMMER  
CLOSURE: 1: 196000  
MAP PAGE(S): 02-00-051 & -052  
APPROVED BY: TJS DATE: 8/11/2021  
SCALE: 1" = 200' PRIOR INSTRUMENT: 1999-0648302