
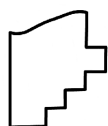


PARENT PARCEL: 06-25-176-104-001 & -037

CHILD PARCEL: 06-25-176-104-042

STARTING POINT: NORTHWEST CORNER OF O.L. 176

21-04346

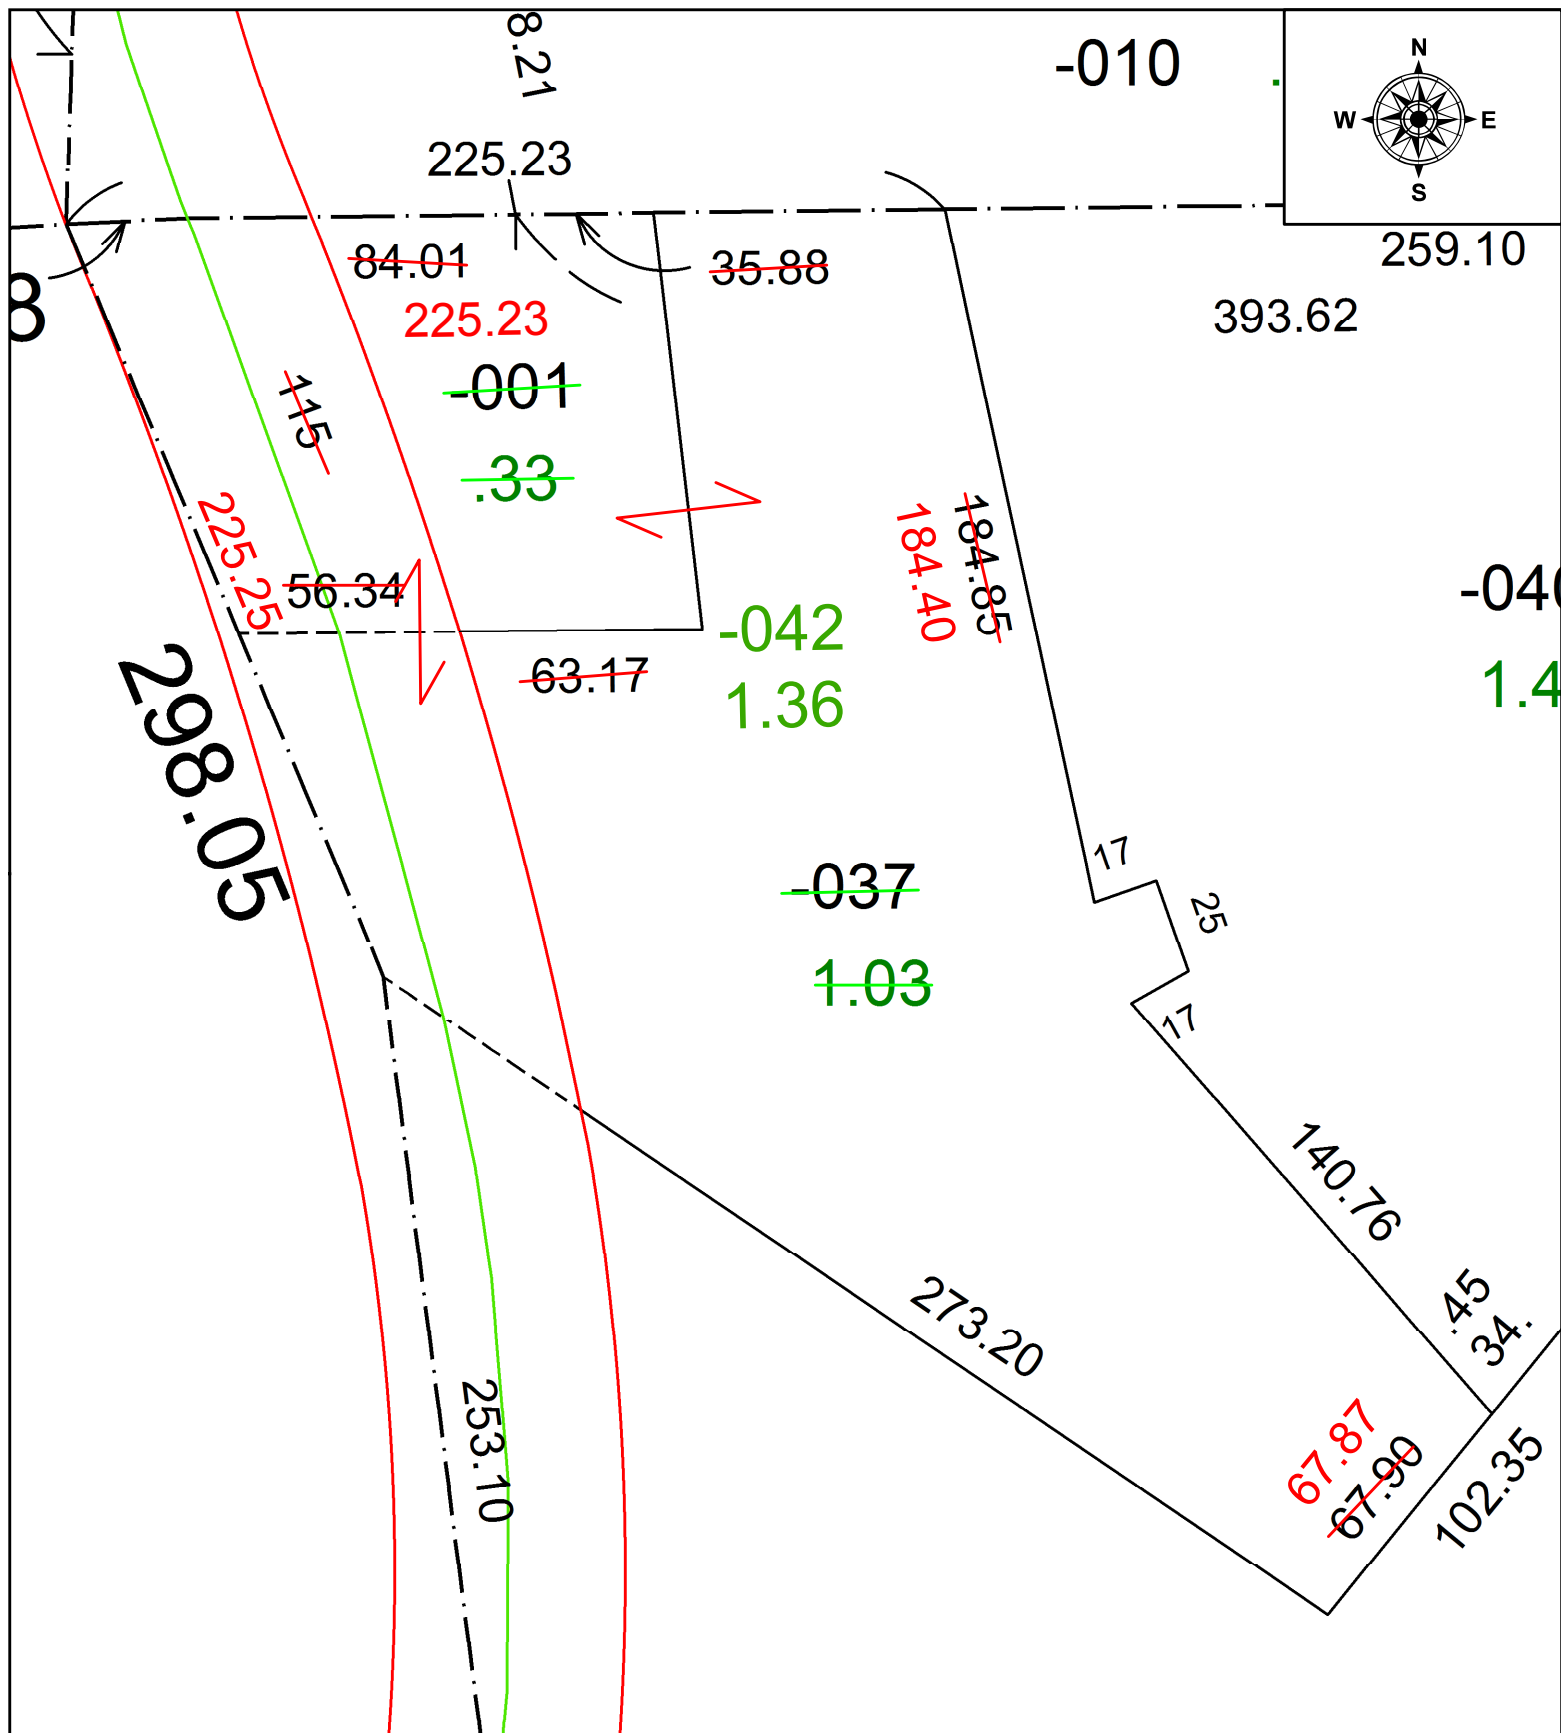

**SPLITS/DEEDS PROCESSED**  
 LORAIN COUNTY TAX MAP DEPARTMENT  
 226 MIDDLE AVE. ELYRIA, OH

SURVEYED BY: GRAHAM EWING  
 CLOSURE: 1: 100,132  
 MAP PAGE(S): 06-25-176  
 APPROVED BY: WRZ DATE: 8/11/2021  
 SCALE: 1" = 50 PRIOR INSTRUMENT: 2013-0475014