


PARENT PARCEL: 03-00-045-102-050, -097

CHILD PARCEL: 03-00-045-102-110

STARTING POINT: COMBINATION

21-04347

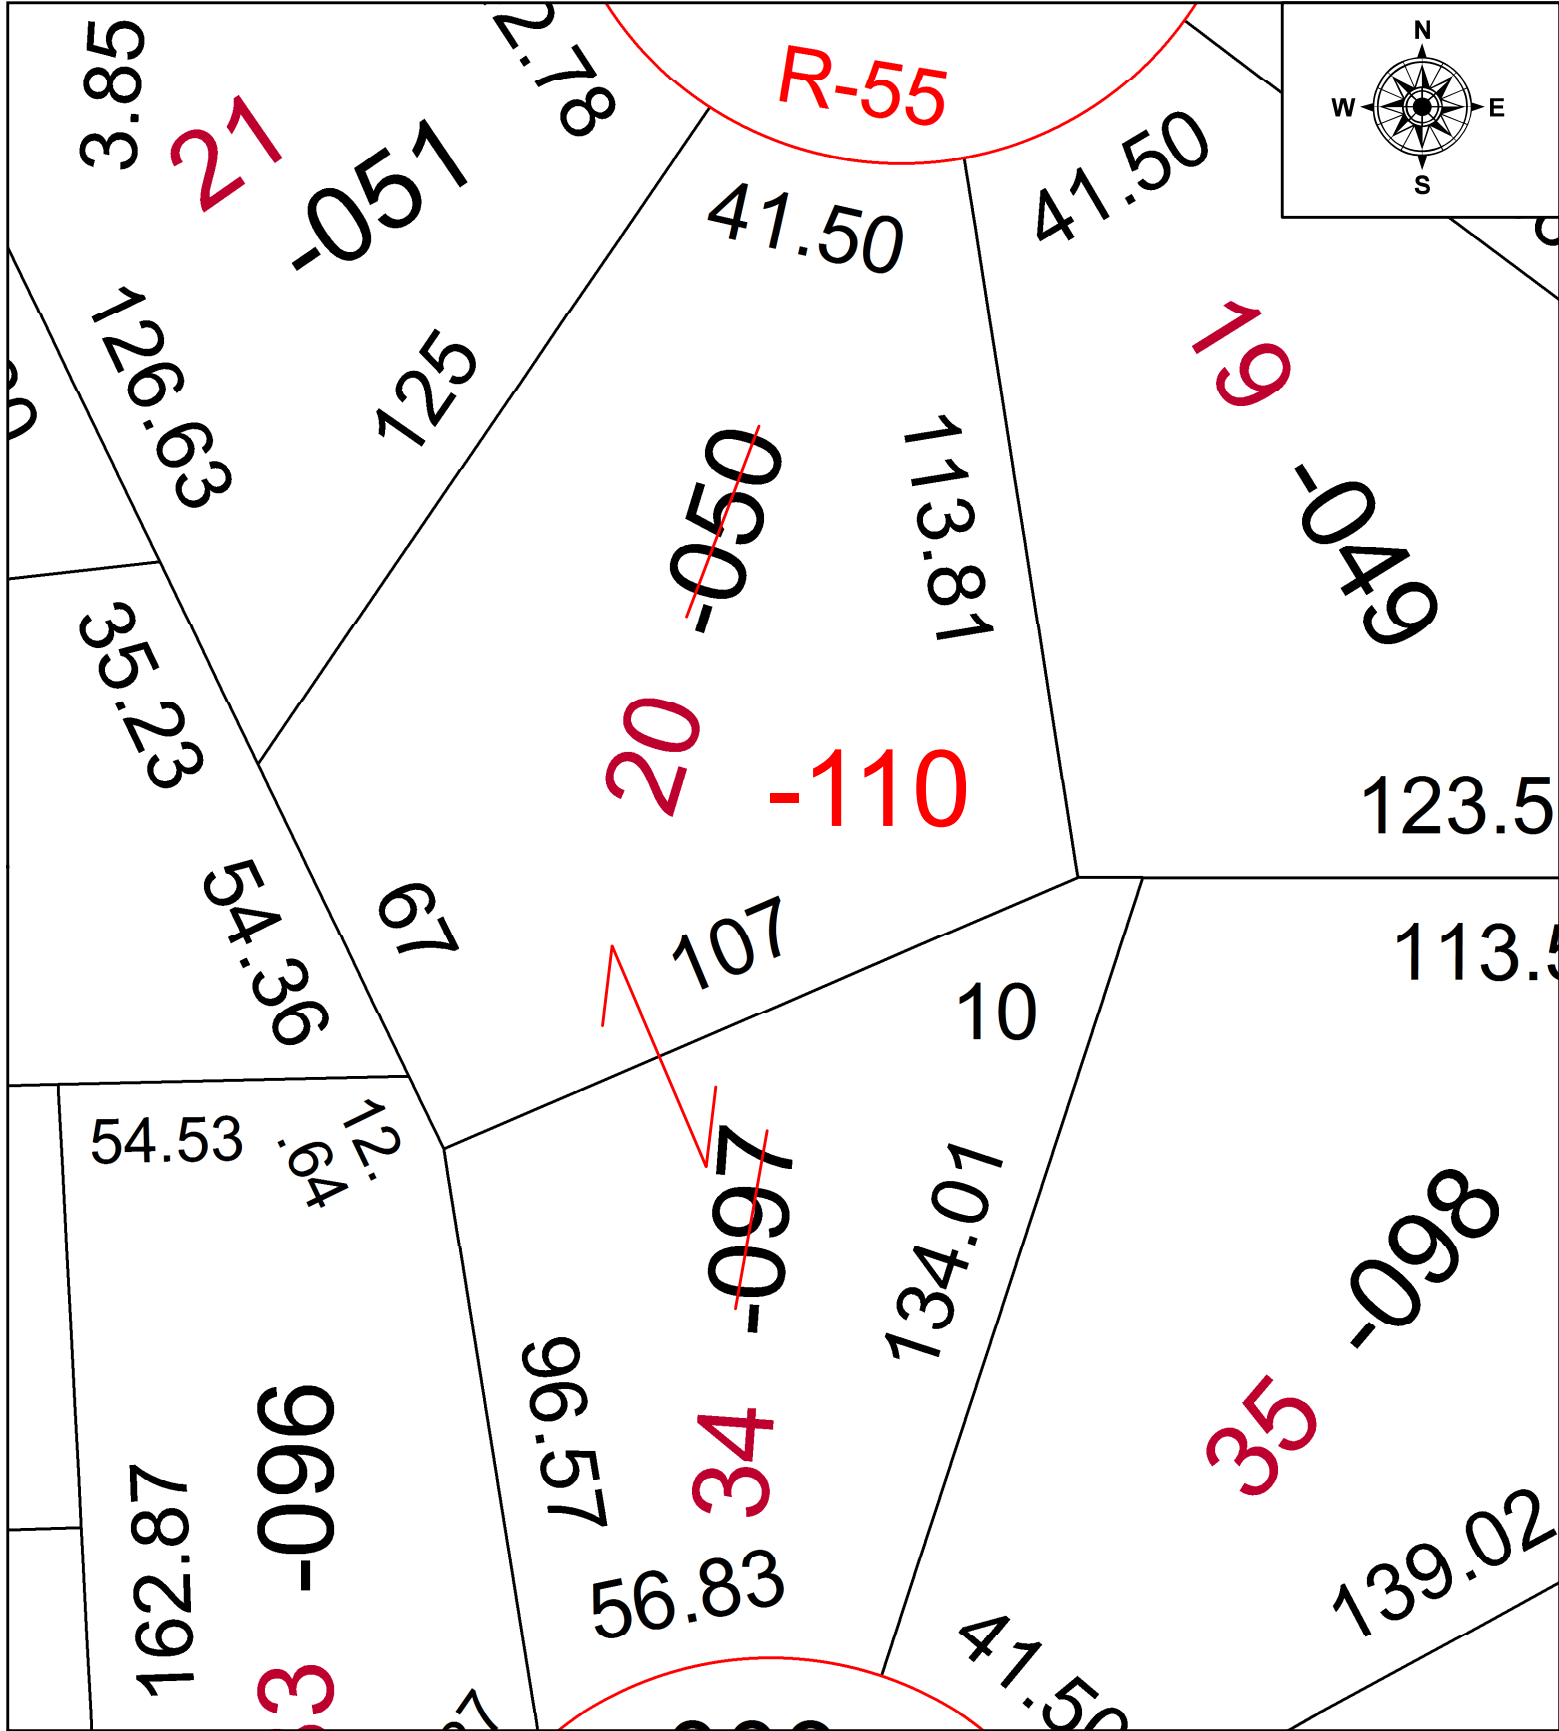

SPLITS/DEEDS PROCESSED
 LORAIN COUNTY TAX MAP DEPARTMENT
 226 MIDDLE AVE. ELYRIA, OH

SURVEYED BY: _____ N/A
 CLOSURE: _____ N/A
 MAP PAGE(S): _____ 03-00-045
 APPROVED BY: _____ AC DATE: _____ 8/17/2021
 SCALE: _____ 1" = 30 PRIOR INSTRUMENT: _____ 2020- 0784744