
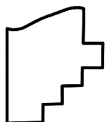


PARENT PARCEL: 01-00-021-000-059 & -062

CHILD PARCEL: 01-00-021-000-066 THRU -070

STARTING POINT: CL OF SUNNYSIDE RD & BROWNHLEM STATION RD.

21-04348

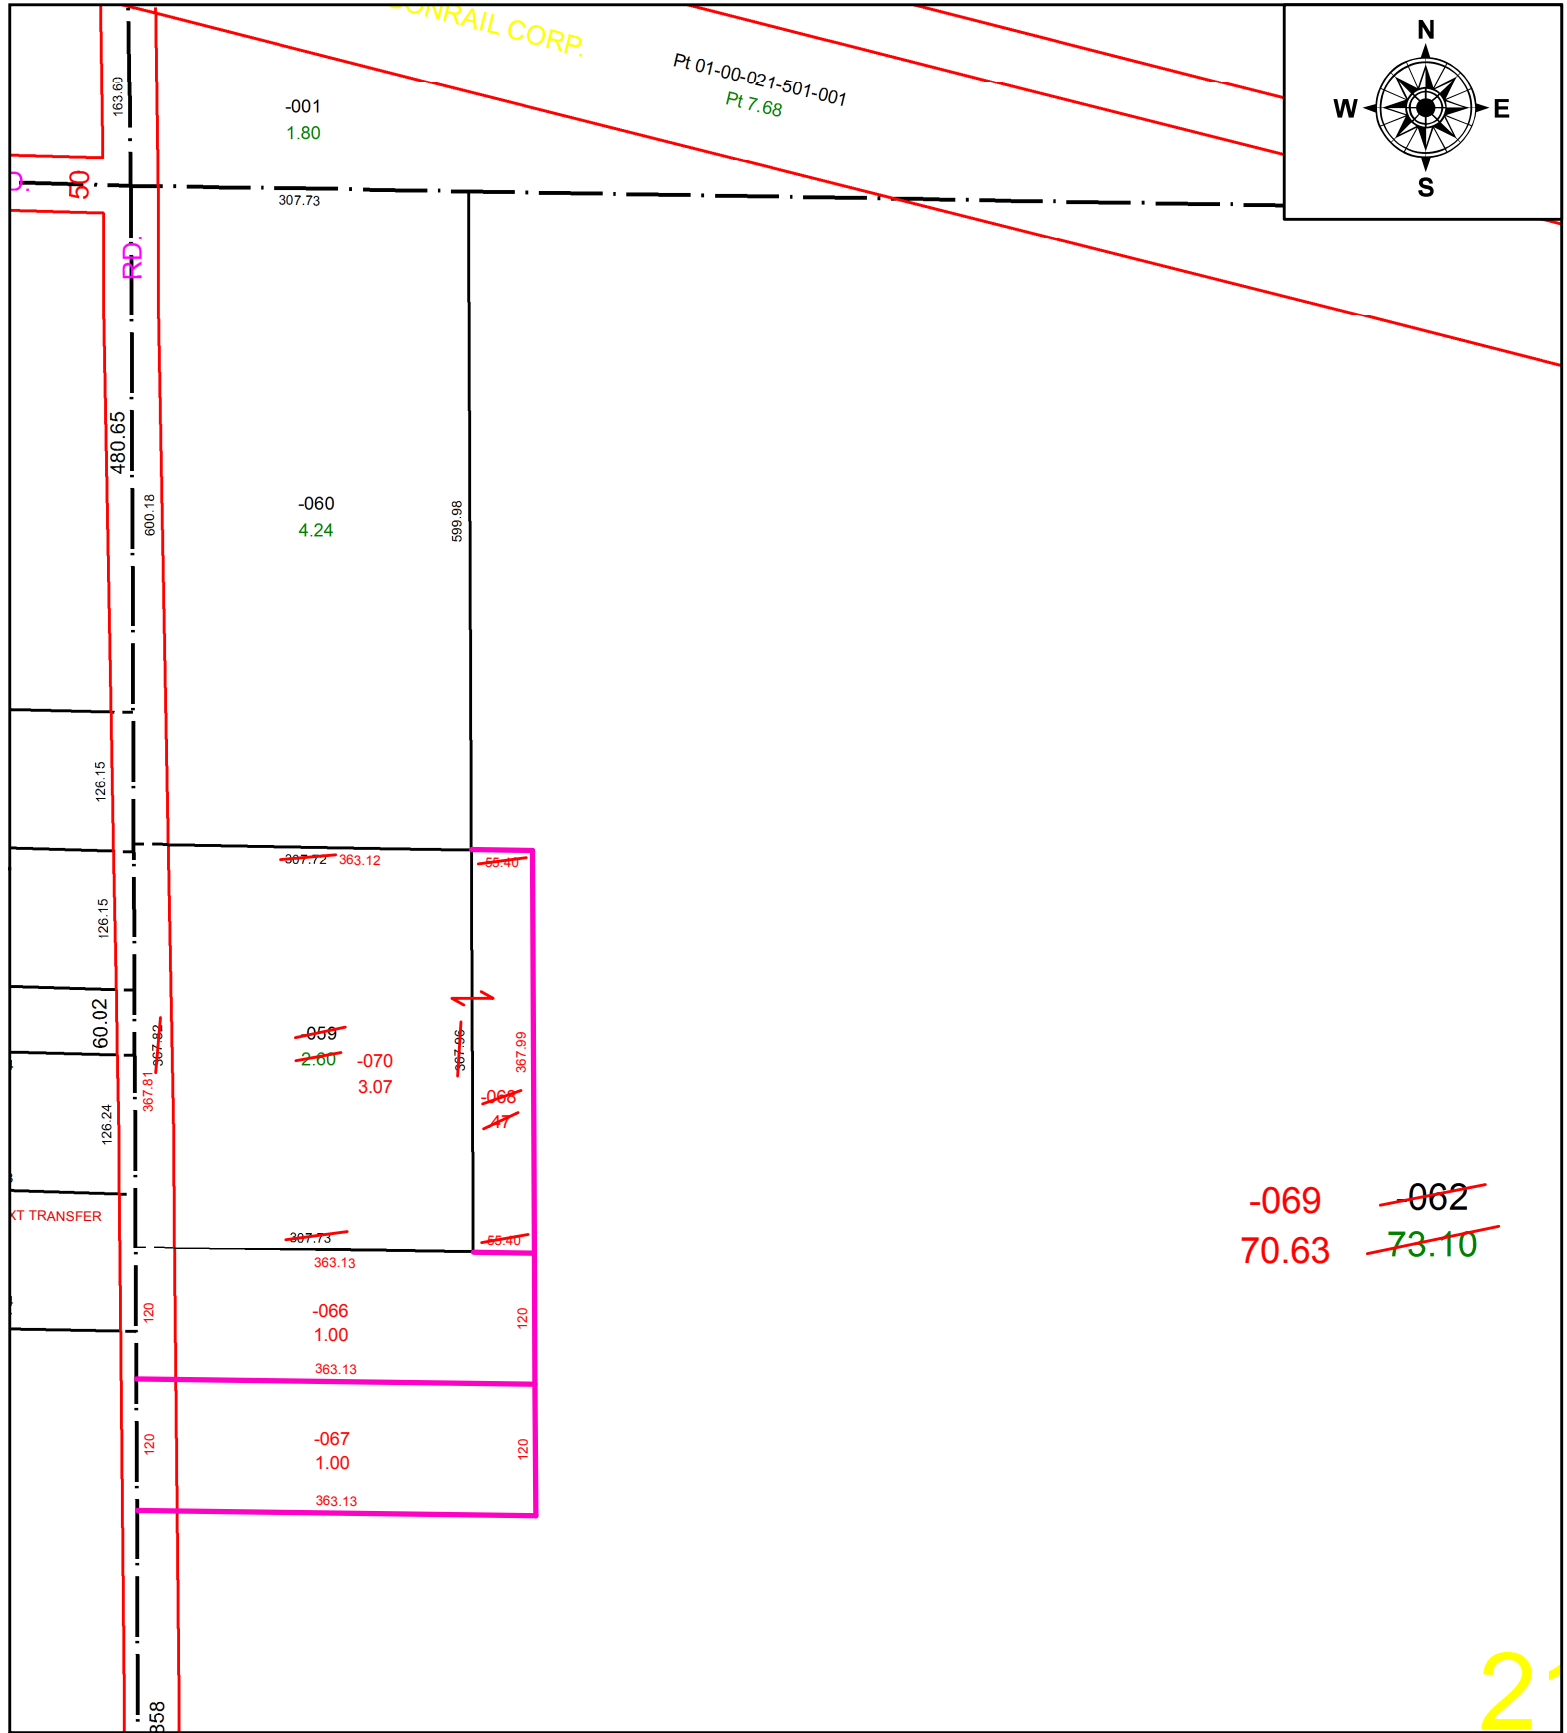

SPLITS/DEEDS PROCESSED
 LORAIN COUNTY TAX MAP DEPARTMENT
 226 MIDDLE AVE. ELYRIA, OH

SURVEYED BY: PATRICK MCGANNON

CLOSURE: 1: -2147483648

MAP PAGE(S): 01-00-021

APPROVED BY: DMA **DATE:** 8/18/2021

SCALE: 1" = 175' **PRIOR INSTRUMENT:** 20200792973