
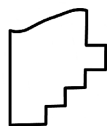
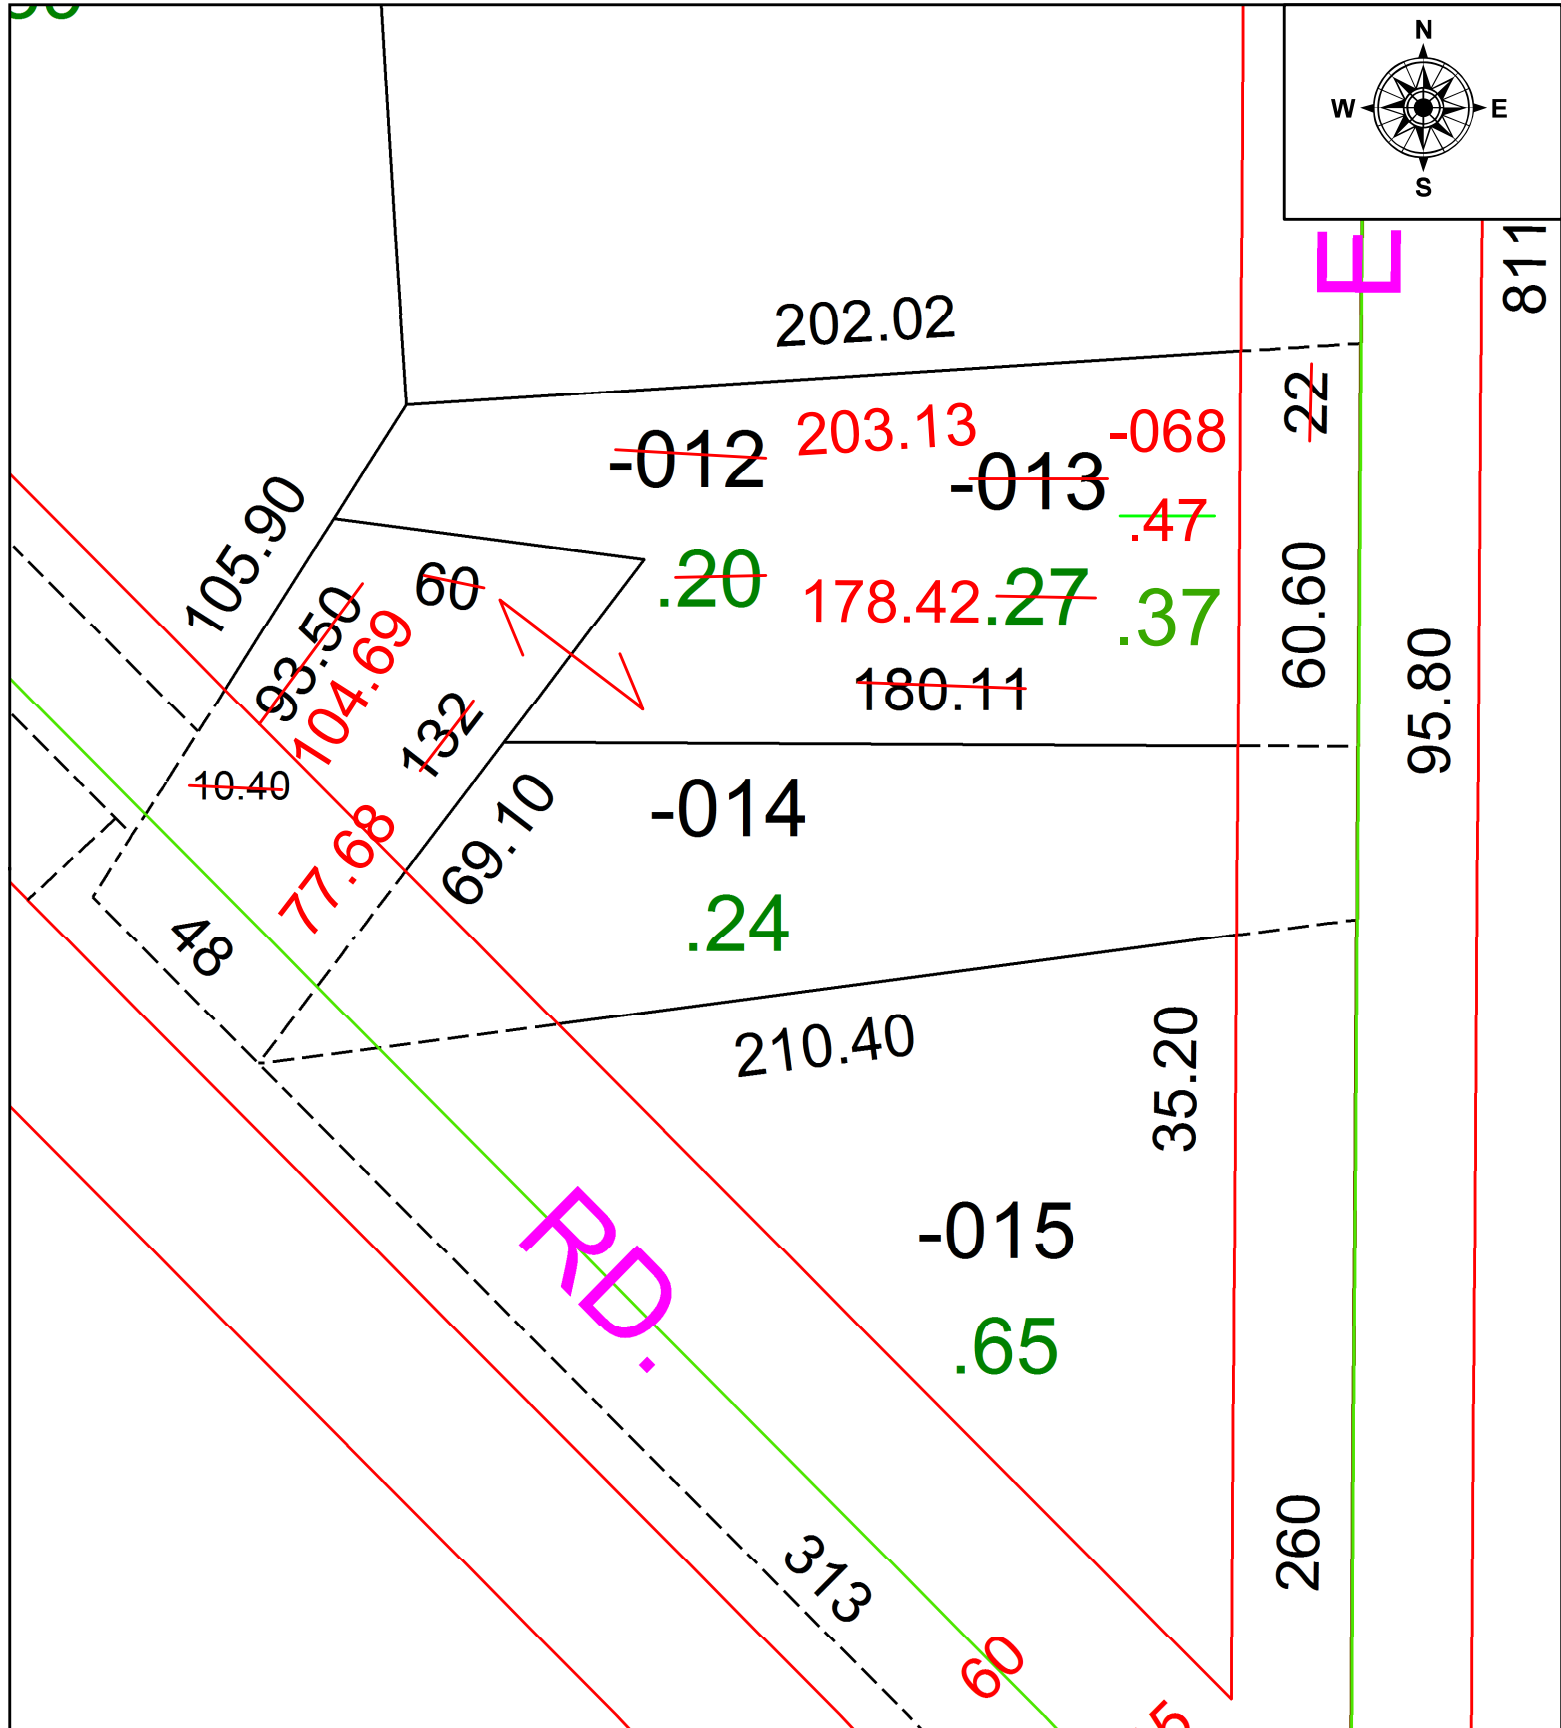


PARENT PARCEL: 16-00-091-000-012, -013

CHILD PARCEL: 16-00-091-000-068

STARTING POINT: AC CORR PER SURV BY TIMOTHY HOZALSKI

21-04349

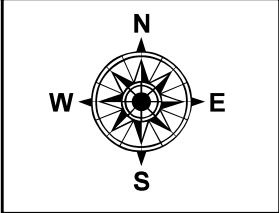

SPLITS/DEEDS PROCESSED
 LORAIN COUNTY TAX MAP DEPARTMENT
 226 MIDDLE AVE. ELYRIA, OH

SURVEYED BY: TIMOTHY D. HOZALSKI
 CLOSURE: 1: 76605
 MAP PAGE(S): 16-00-091
 APPROVED BY: AC DATE: 8/19/2021
 SCALE: 1" = 40 PRIOR INSTRUMENT: 2019- 0738619