
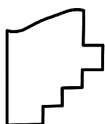


PARENT PARCEL: 12-00-064-102-003

CHILD PARCEL:

STARTING POINT: NORTHEAST CORNER OF O.L.64

20-04351-A

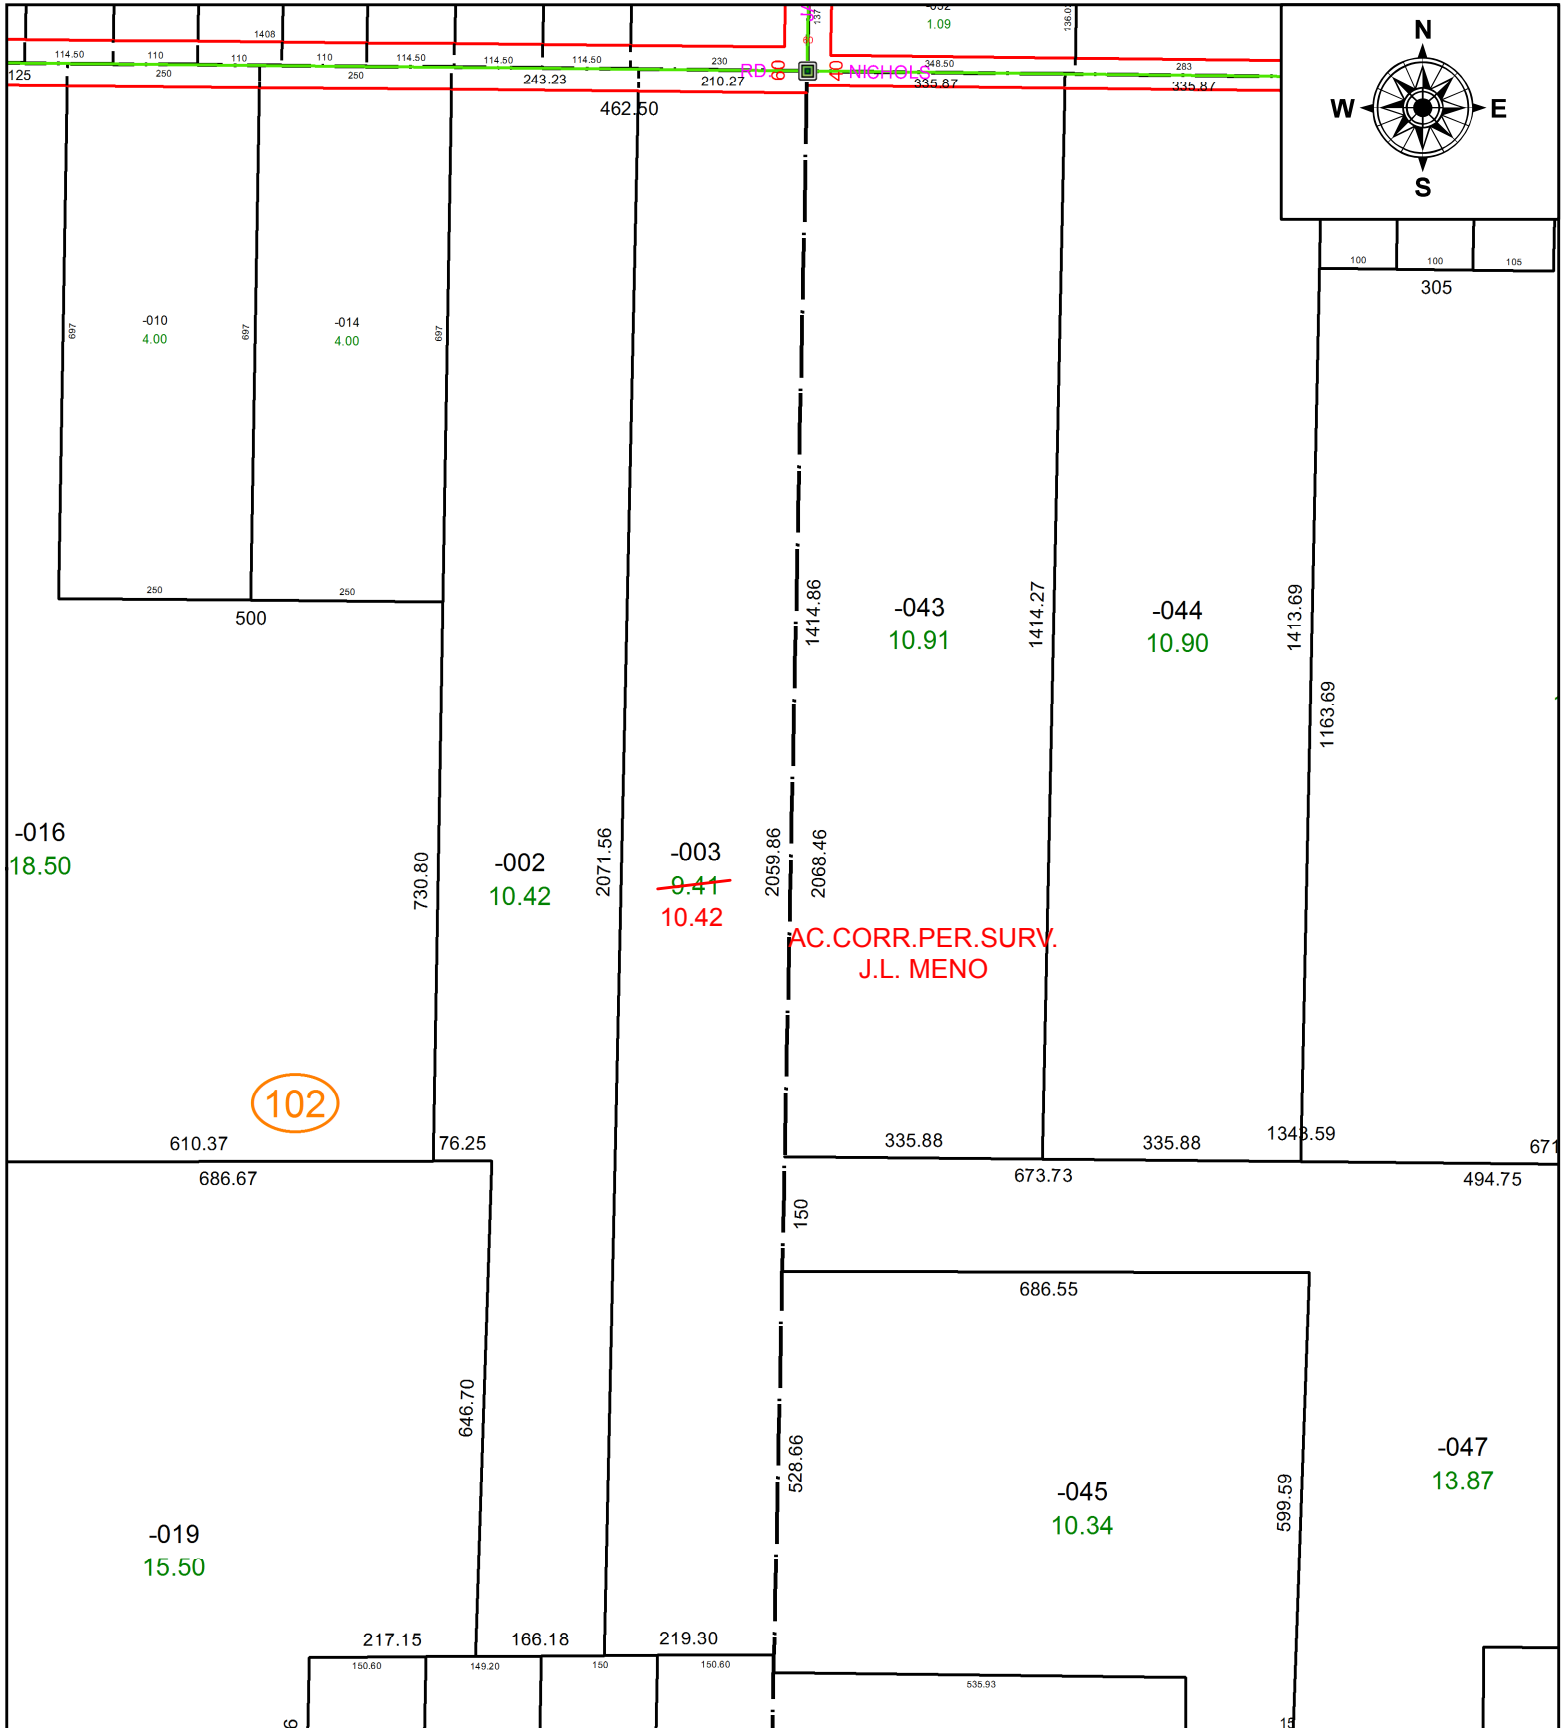

SPLITS/DEEDS PROCESSED
 LORAIN COUNTY TAX MAP DEPARTMENT
 226 MIDDLE AVE. ELYRIA, OH

SURVEYED BY: J.L.MENO
 CLOSURE: 1:48,305
 MAP PAGE(S): 12-00-064
 APPROVED BY: RRM DATE: 10-30-20
 SCALE: 1" = 250 PRIOR INSTRUMENT: 20200764398