


PARENT PARCEL: 14-00-153-000-018, 14-00-154-000-004, 14-00-155-000-001, -002

CHILD PARCEL: 14-00-153-000-018, 14-00-154-000-004, 14-00-155-000-011

21-04352

STARTING POINT: C/L OF PITTS AND MERRIAM ROAD AC CORR PER SURV BY T. SIMON

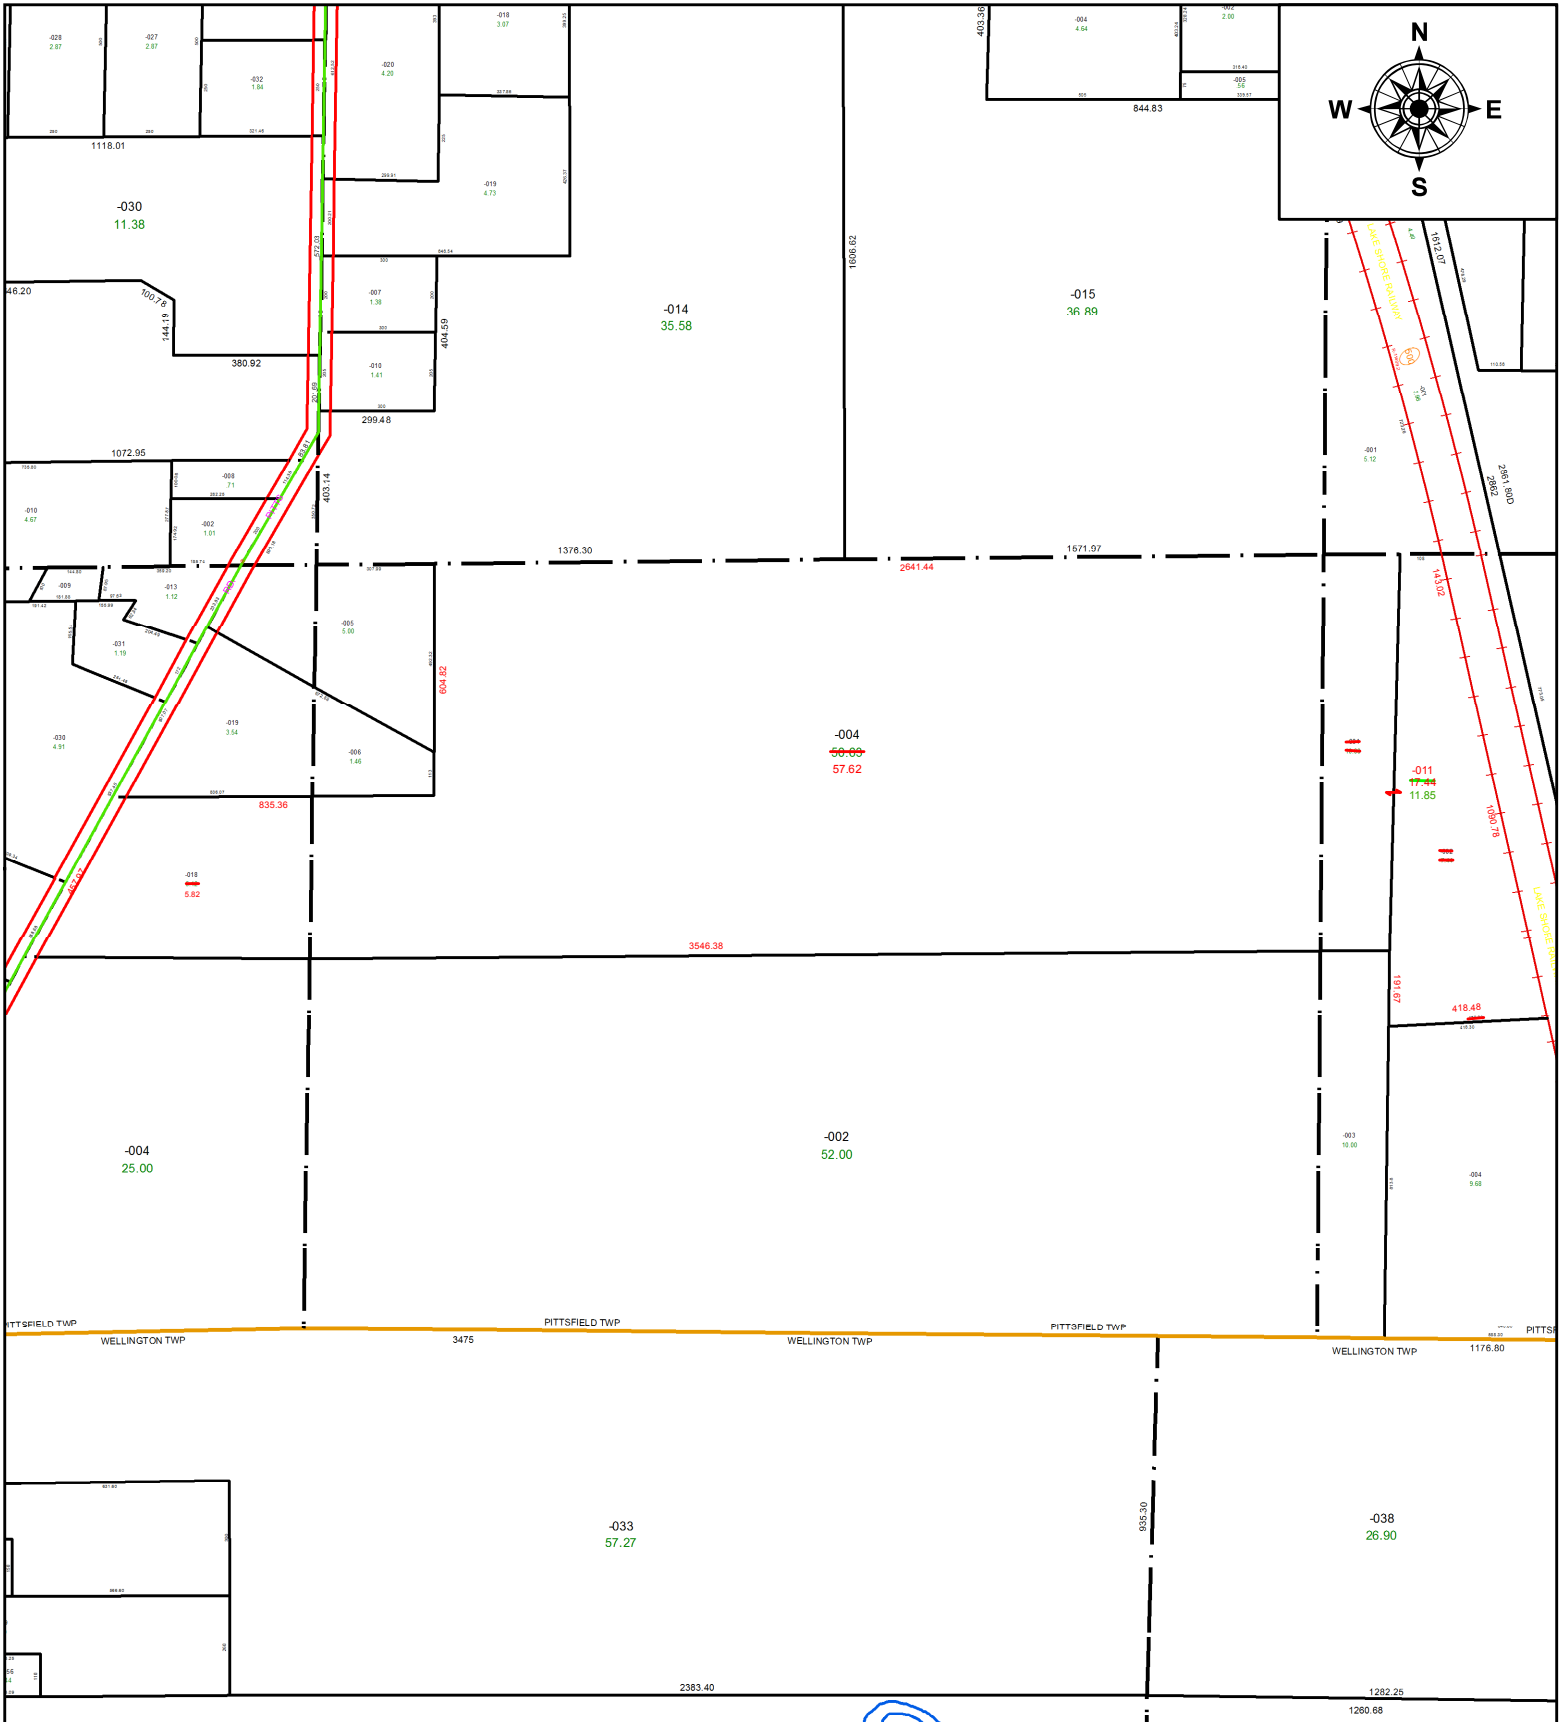

SPLITS/DEEDS PROCESSED
 LORAIN COUNTY TAX MAP DEPARTMENT
 226 MIDDLE AVE. ELYRIA, OH

SURVEYED BY: THOMAS A. SIMON
CLOSURE: 1: 1665601
MAP PAGE(S): 14-00-153-B
APPROVED BY: AC **DATE:** 8/25/2021
SCALE: 1" = 500 **PRIOR INSTRUMENT:** 2008- 0254676