


PARENT PARCEL: 10-00-005-107-386, -387, -454

CHILD PARCEL: 10-00-005-107-723 THRU -725

21-04354

STARTING POINT: INTERSECTION OF C/LS OF PEMBERTON DR & CHESTNUT RIDGE RD

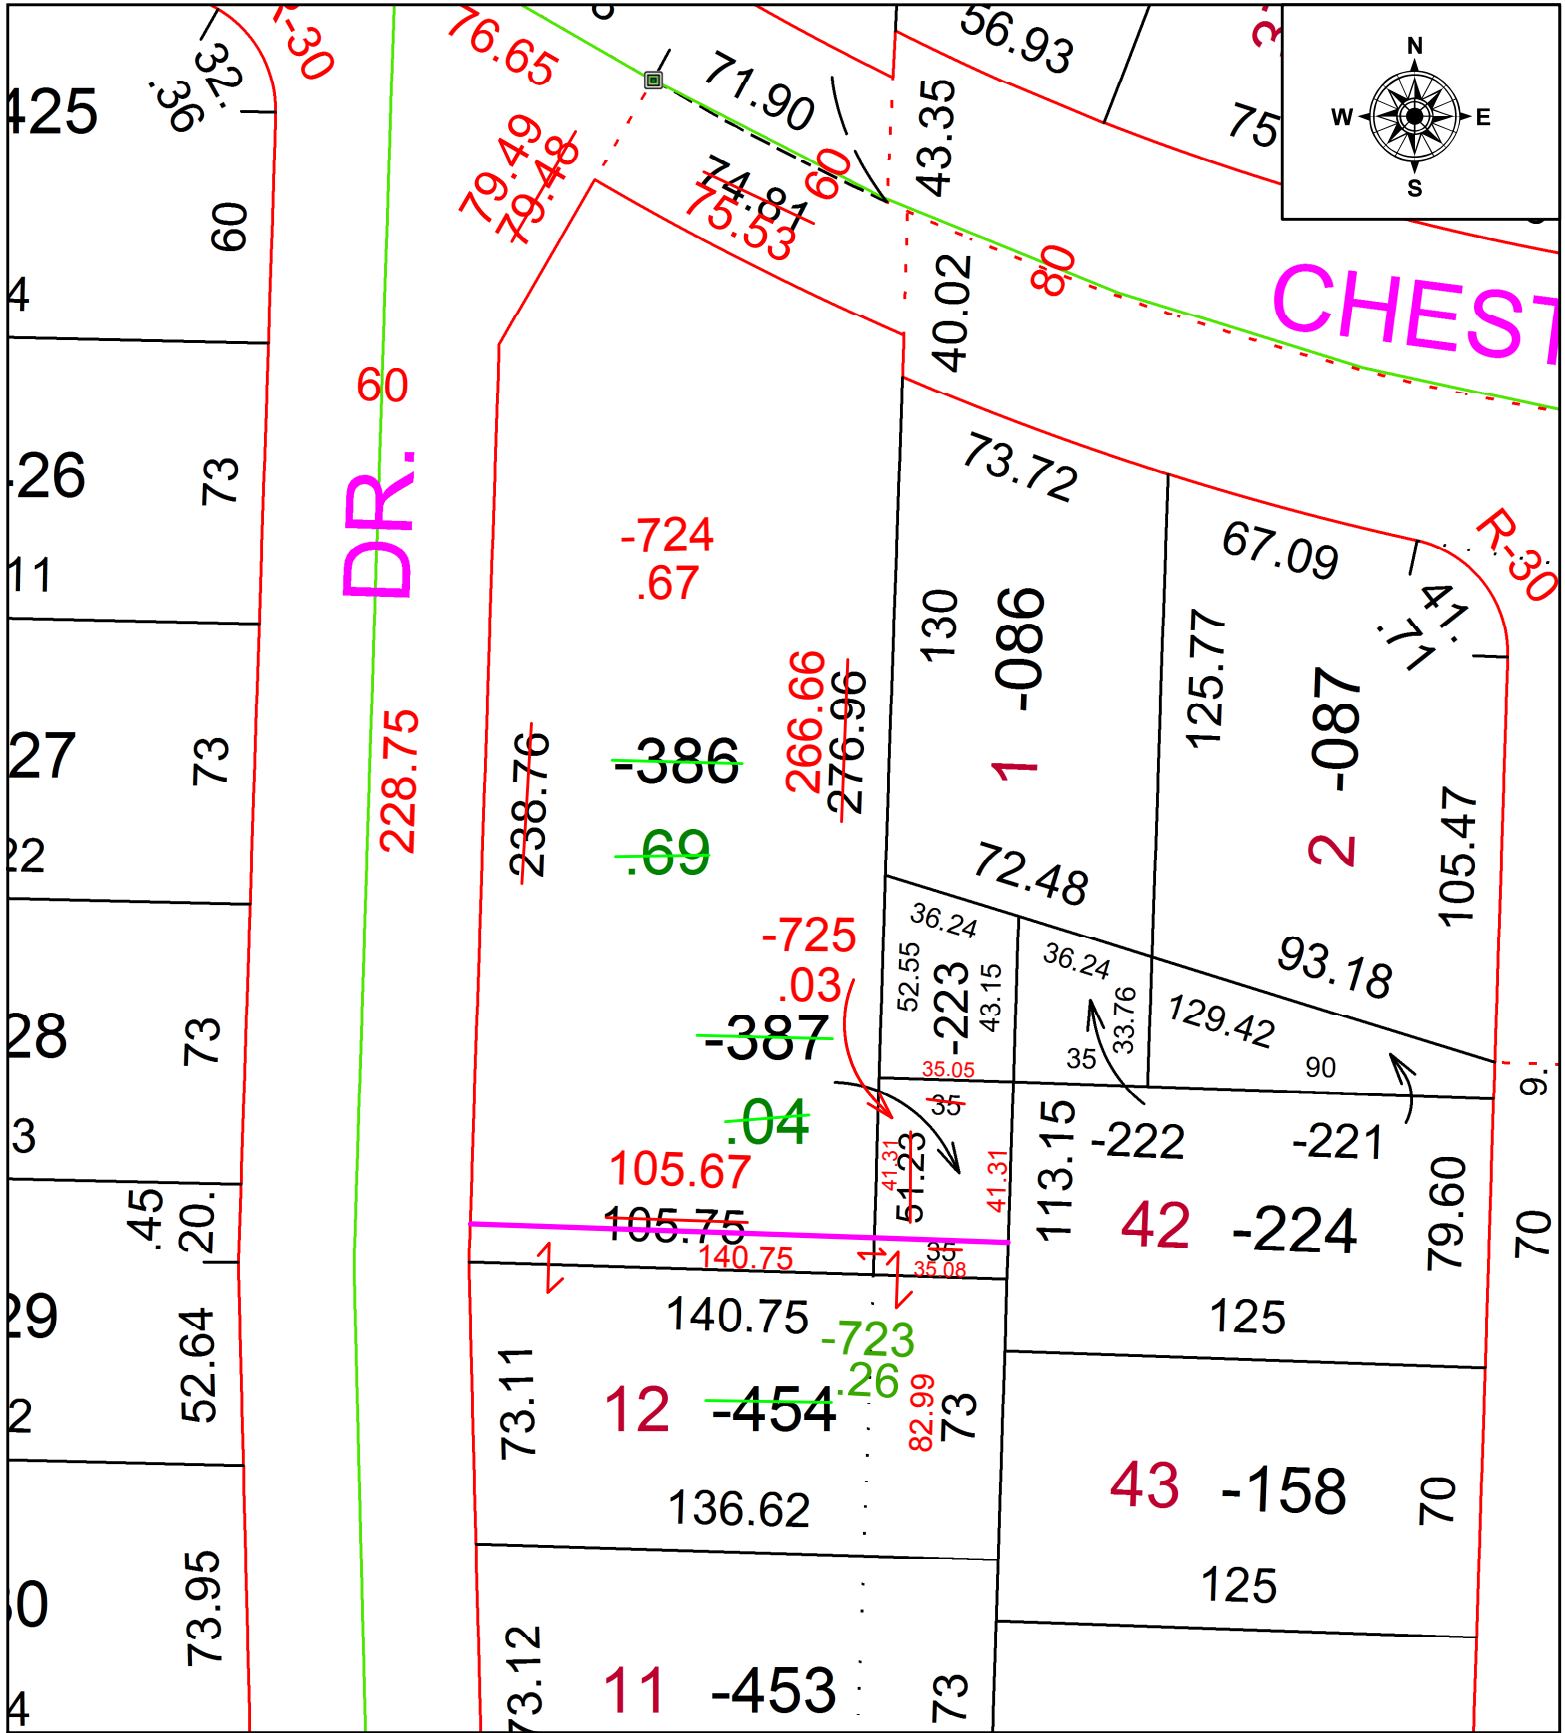

SPLITS/DEEDS PROCESSED
 LORAIN COUNTY TAX MAP DEPARTMENT
 226 MIDDLE AVE. ELYRIA, OH

SURVEYED BY: THOMAS SIMON
 CLOSURE: 1: 116,237
 MAP PAGE(S): 10-00-005
 APPROVED BY: WRZ DATE: 8/27/2021
 SCALE: 1" = 50 PRIOR INSTRUMENT: 2007-0230972