



PARENT PARCEL: 05-00-023-110-051, -057, -059

CHILD PARCEL: 05-00-023-110-066, -067

STARTING POINT: NW CORNER OF SUBLOT 12

21-04357

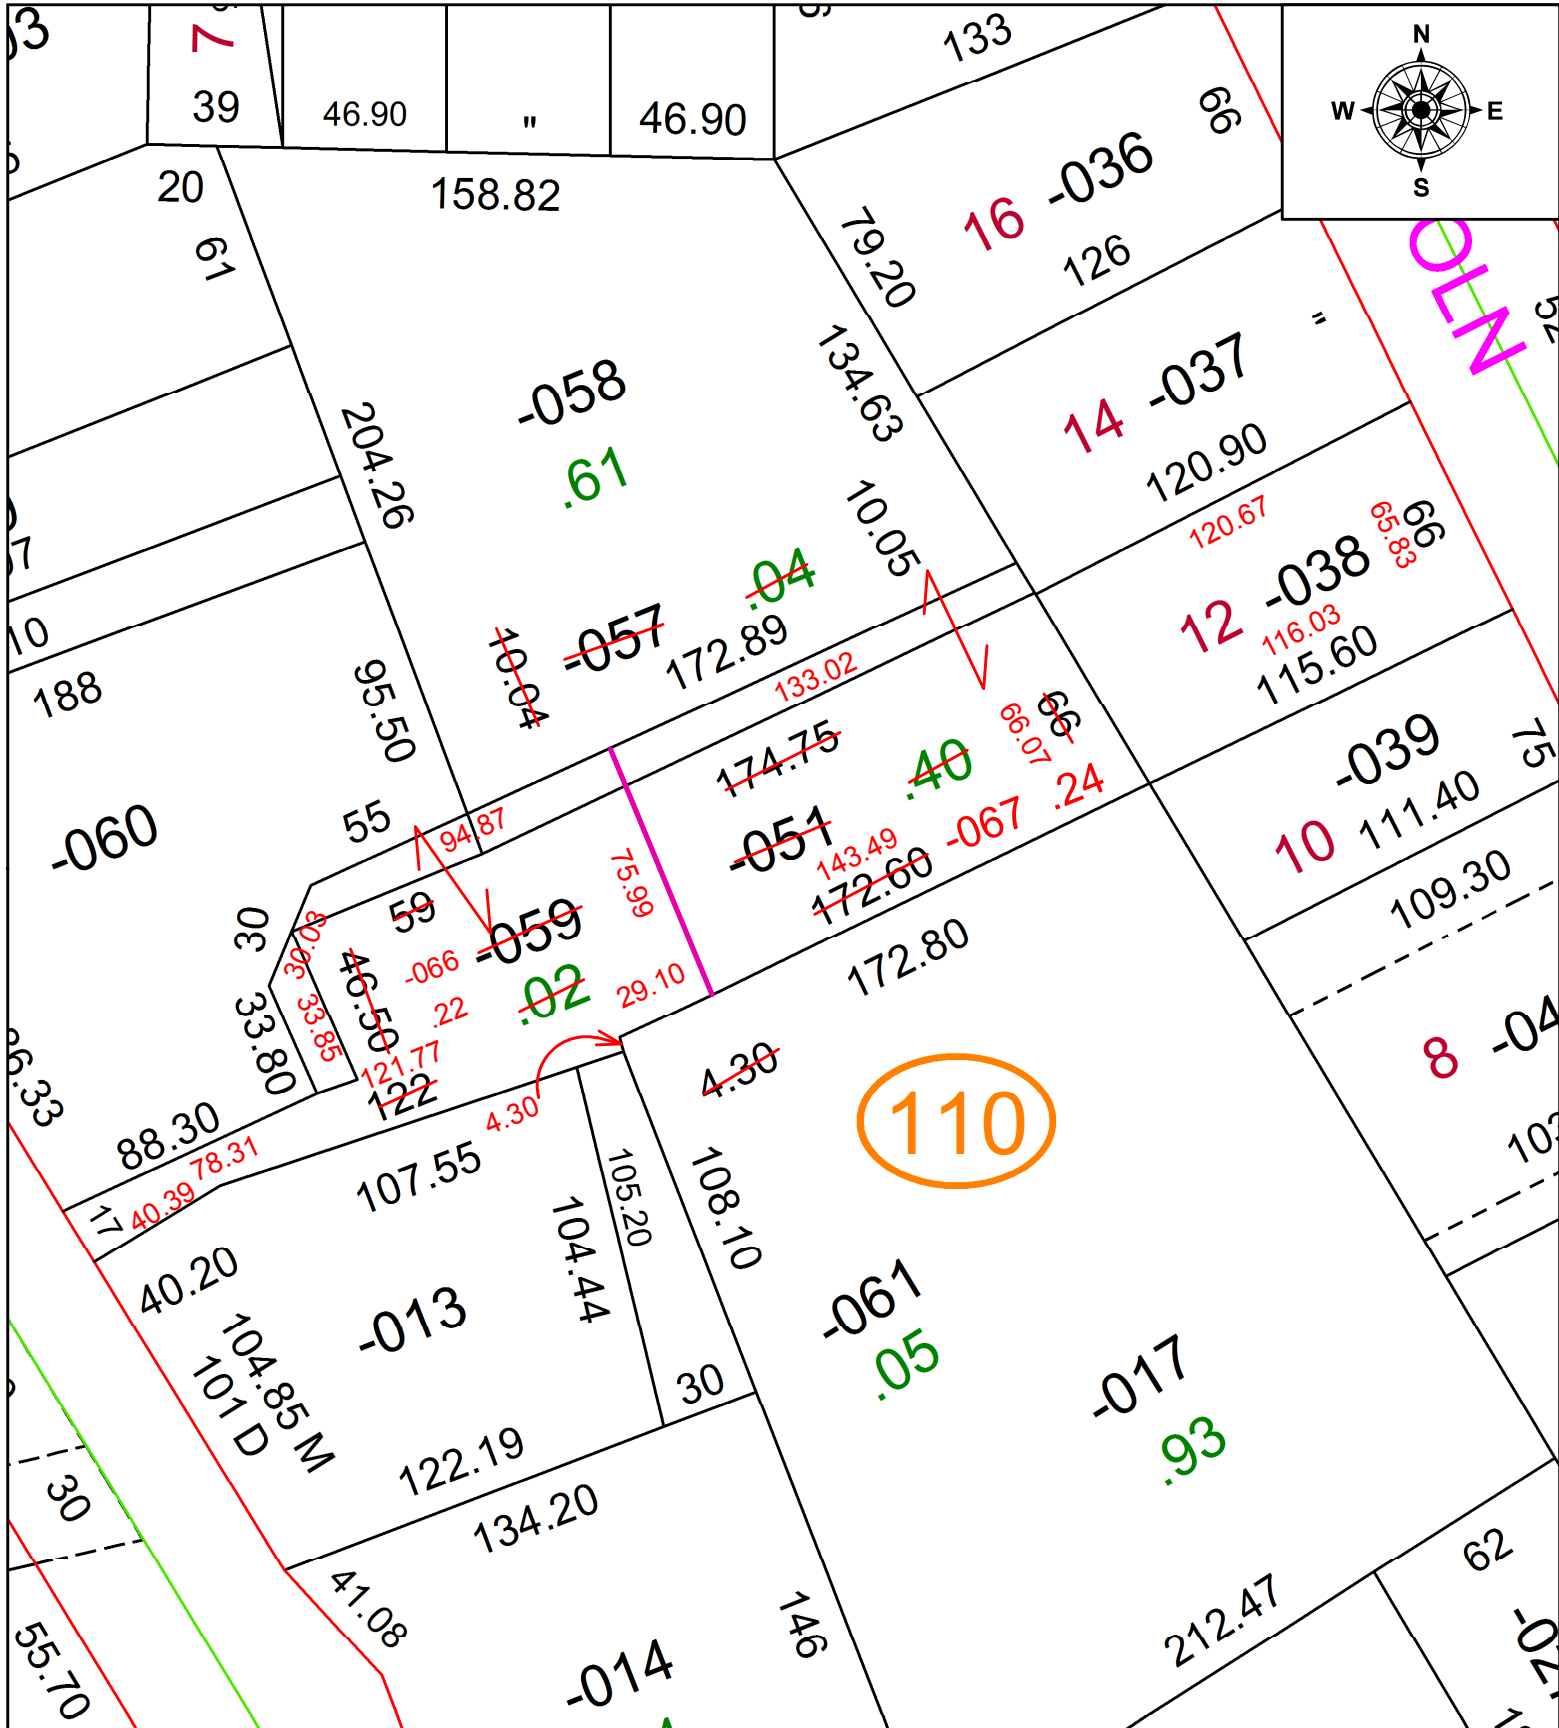

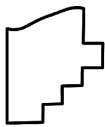 **SPLITS/DEEDS PROCESSED**
 LORAIN COUNTY TAX MAP DEPARTMENT
 226 MIDDLE AVE. ELYRIA, OH

SURVEYED BY: PATRICK A. MCGANNON
CLOSURE: 1: 54462
MAP PAGE(S): 05-00-023
APPROVED BY: AC **DATE:** 9/2/2021
SCALE: 1" = 50 **PRIOR INSTRUMENT:** 2019- 0721993