
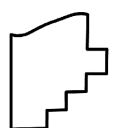


PARENT PARCEL: 15-00-058-000-018 & -038

CHILD PARCEL: 15-00-058-000-064 thru -068

STARTING POINT: CL OF WHITEHEAD RD & NORTHERLY ROW OF ELK CRREEK DR.

21-04361

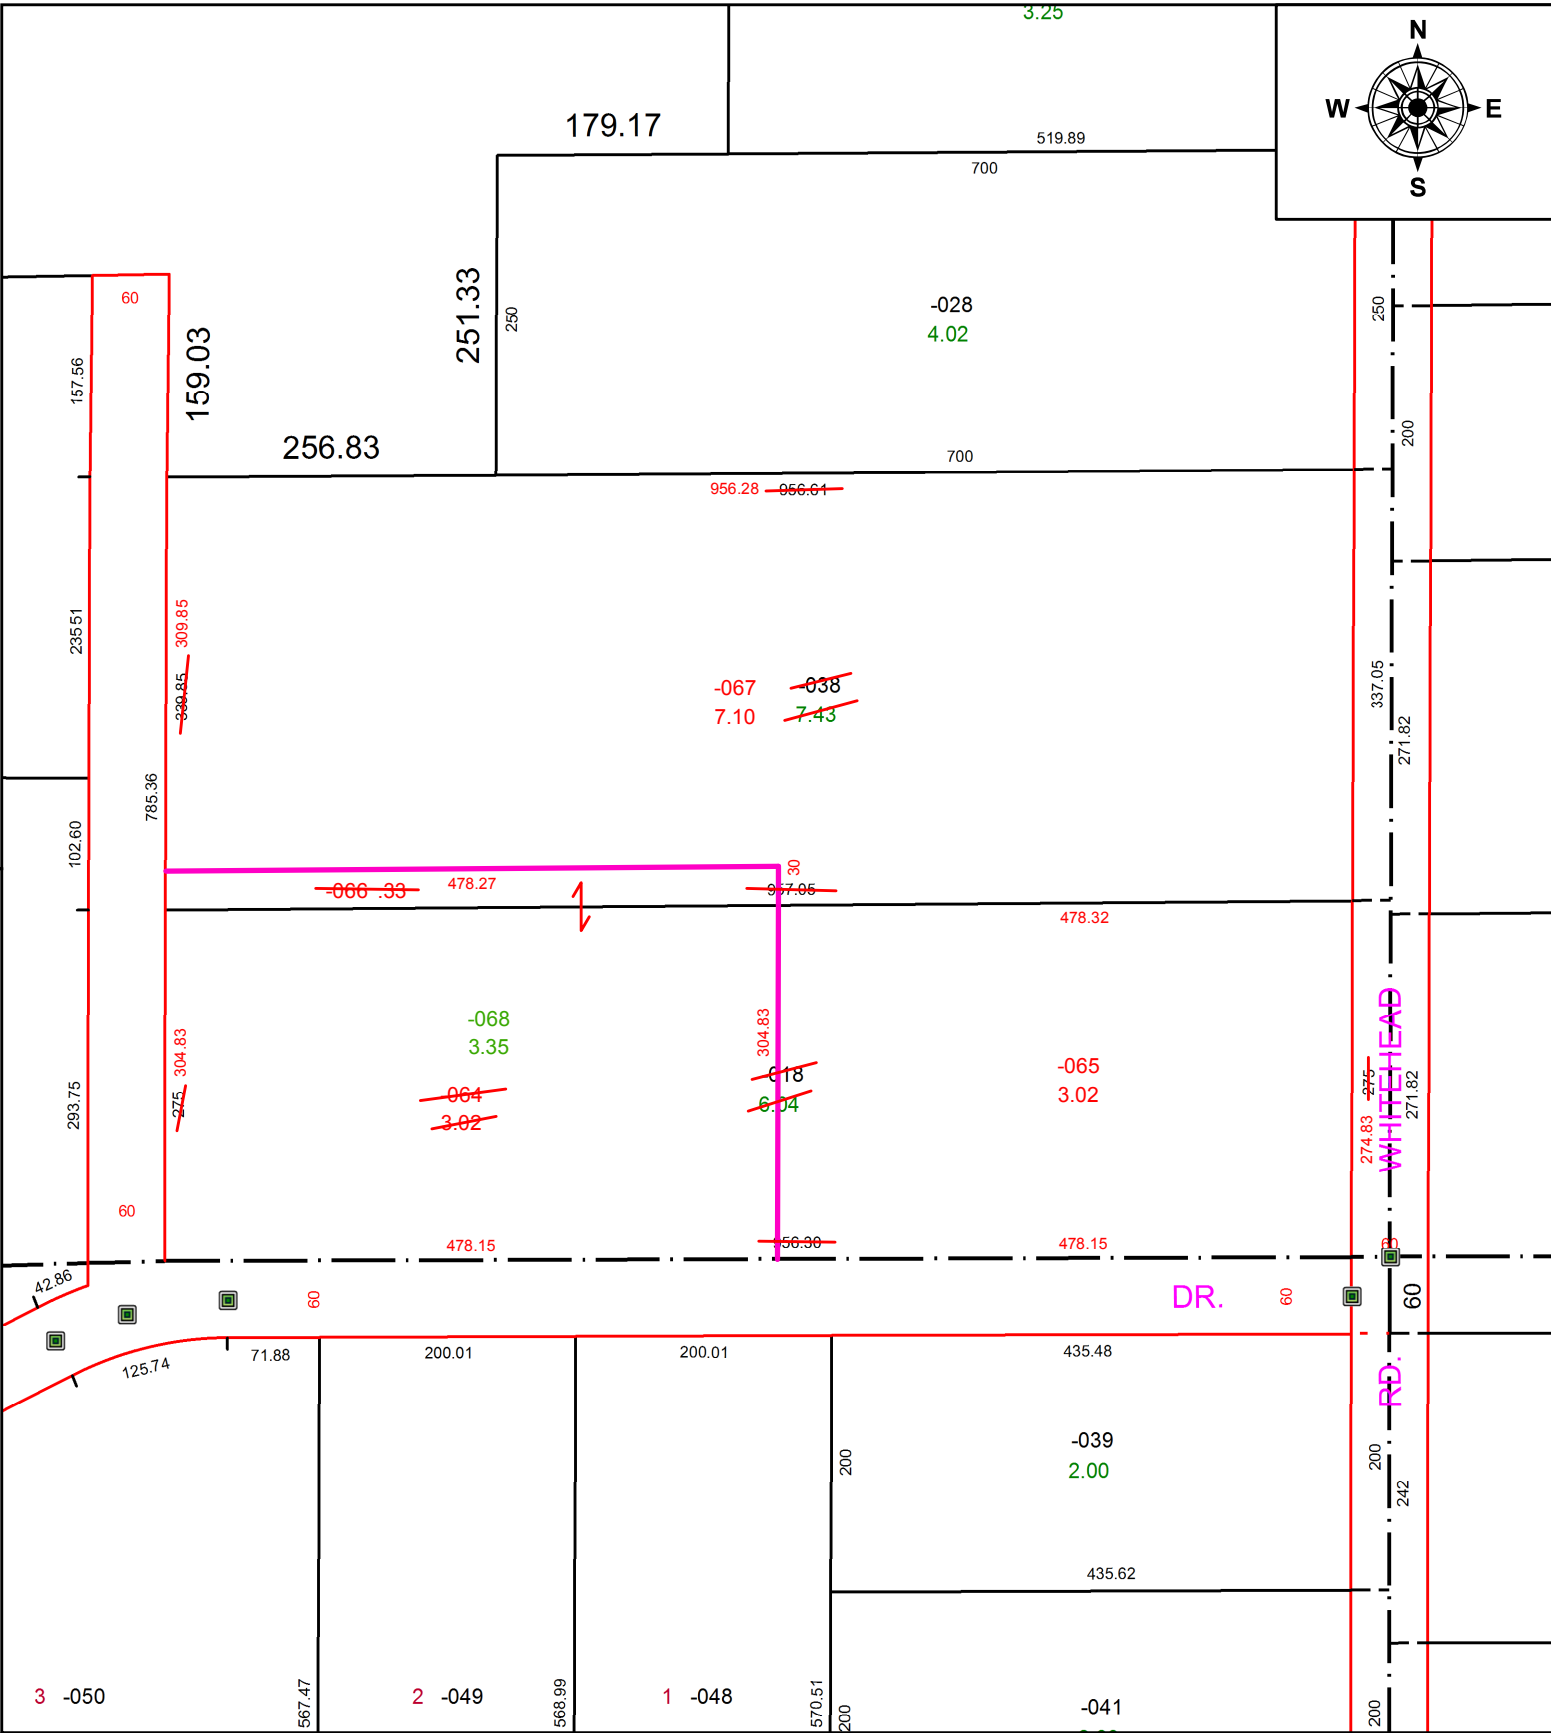

**SPLITS/DEEDS PROCESSED**  
 LORAIN COUNTY TAX MAP DEPARTMENT  
 226 MIDDLE AVE. ELYRIA, OH

SURVEYED BY: AMY KELLY  
 CLOSURE: 1: 158,221  
 MAP PAGE(S): 15-00-058  
 APPROVED BY: DMA DATE: 9/2/2021  
 SCALE: 1" = 150' PRIOR INSTRUMENT: D.V 1199 PG 235