


PARENT PARCEL: 16-00-003-101-015, -016, -032 -063 & 16-00-004-000-002 & -004

CHILD PARCEL: 16-00-003-101-066 & 16-00-004-000-011 Str. Trms. 16-00-003-101-032 & -063

STARTING POINT: CL CUL-DE-SAC OF SANTA FE CT IN CHESAPEAKE CROSSING SUB.

21-04362

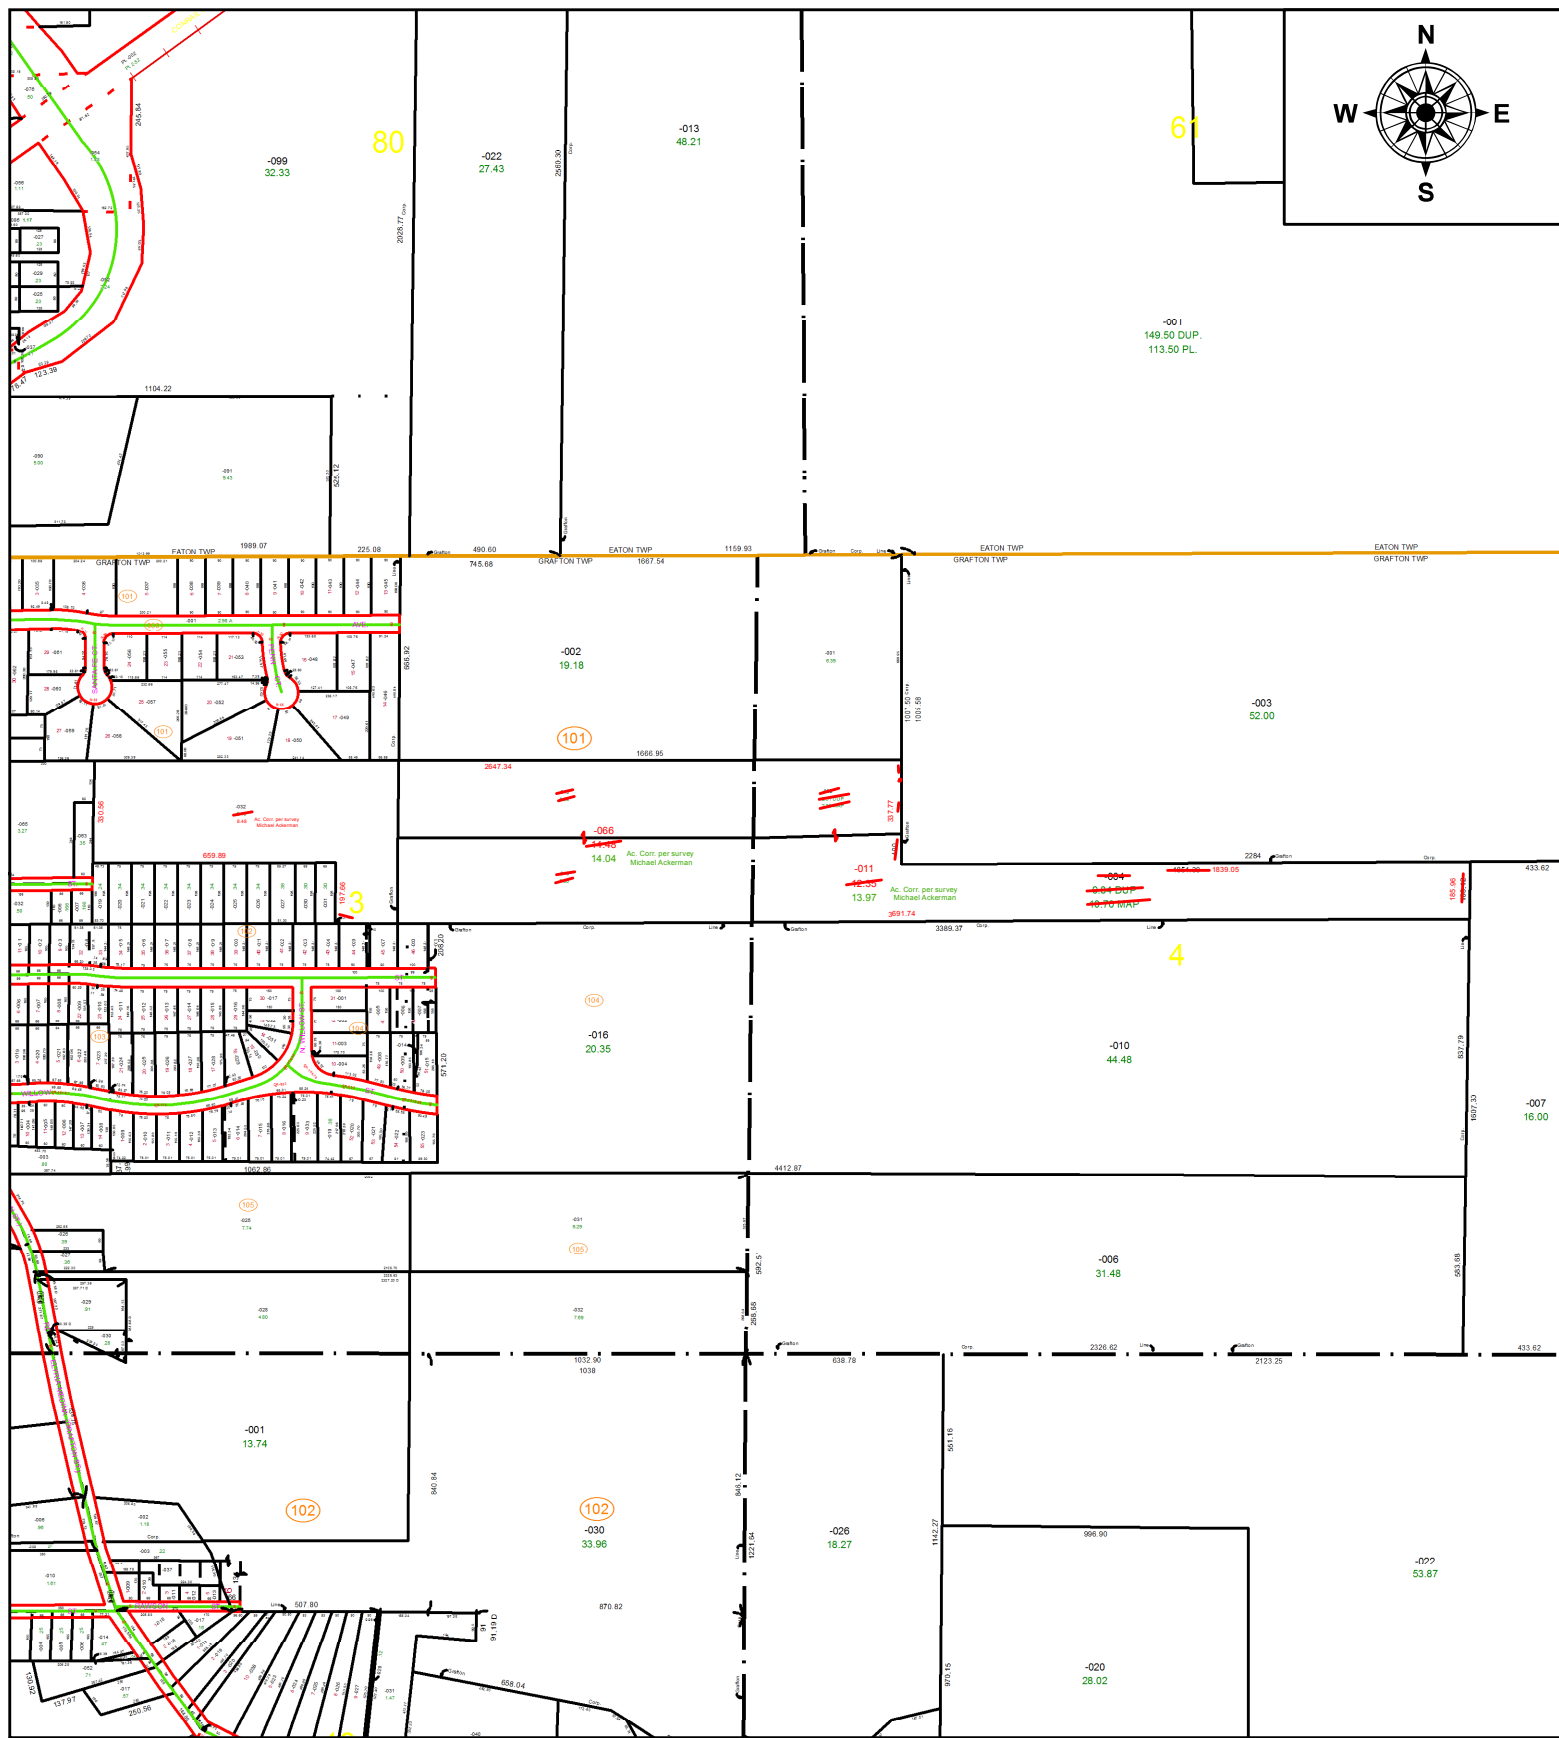

SPLITS/DEEDS PROCESSED
 LORAIN COUNTY TAX MAP DEPARTMENT
 226 MIDDLE AVE. ELYRIA, OH

SURVEYED BY: MICHAEL ACKERMAN
CLOSURE: 1: 1031307
MAP PAGE(S): 16-00-003 & -004
APPROVED BY: DMA **DATE:** 9/2/2021
SCALE: 1" = 625' **PRIOR INSTRUMENT:** D.V 454 PG. 207