


PARENT PARCEL: 01-00-022-104-007, -013

CHILD PARCEL:

STARTING POINT: INTERSECTION OF C/L OF CLAUS RD. AND C/L OF ARNDT ST.

20-04363-A

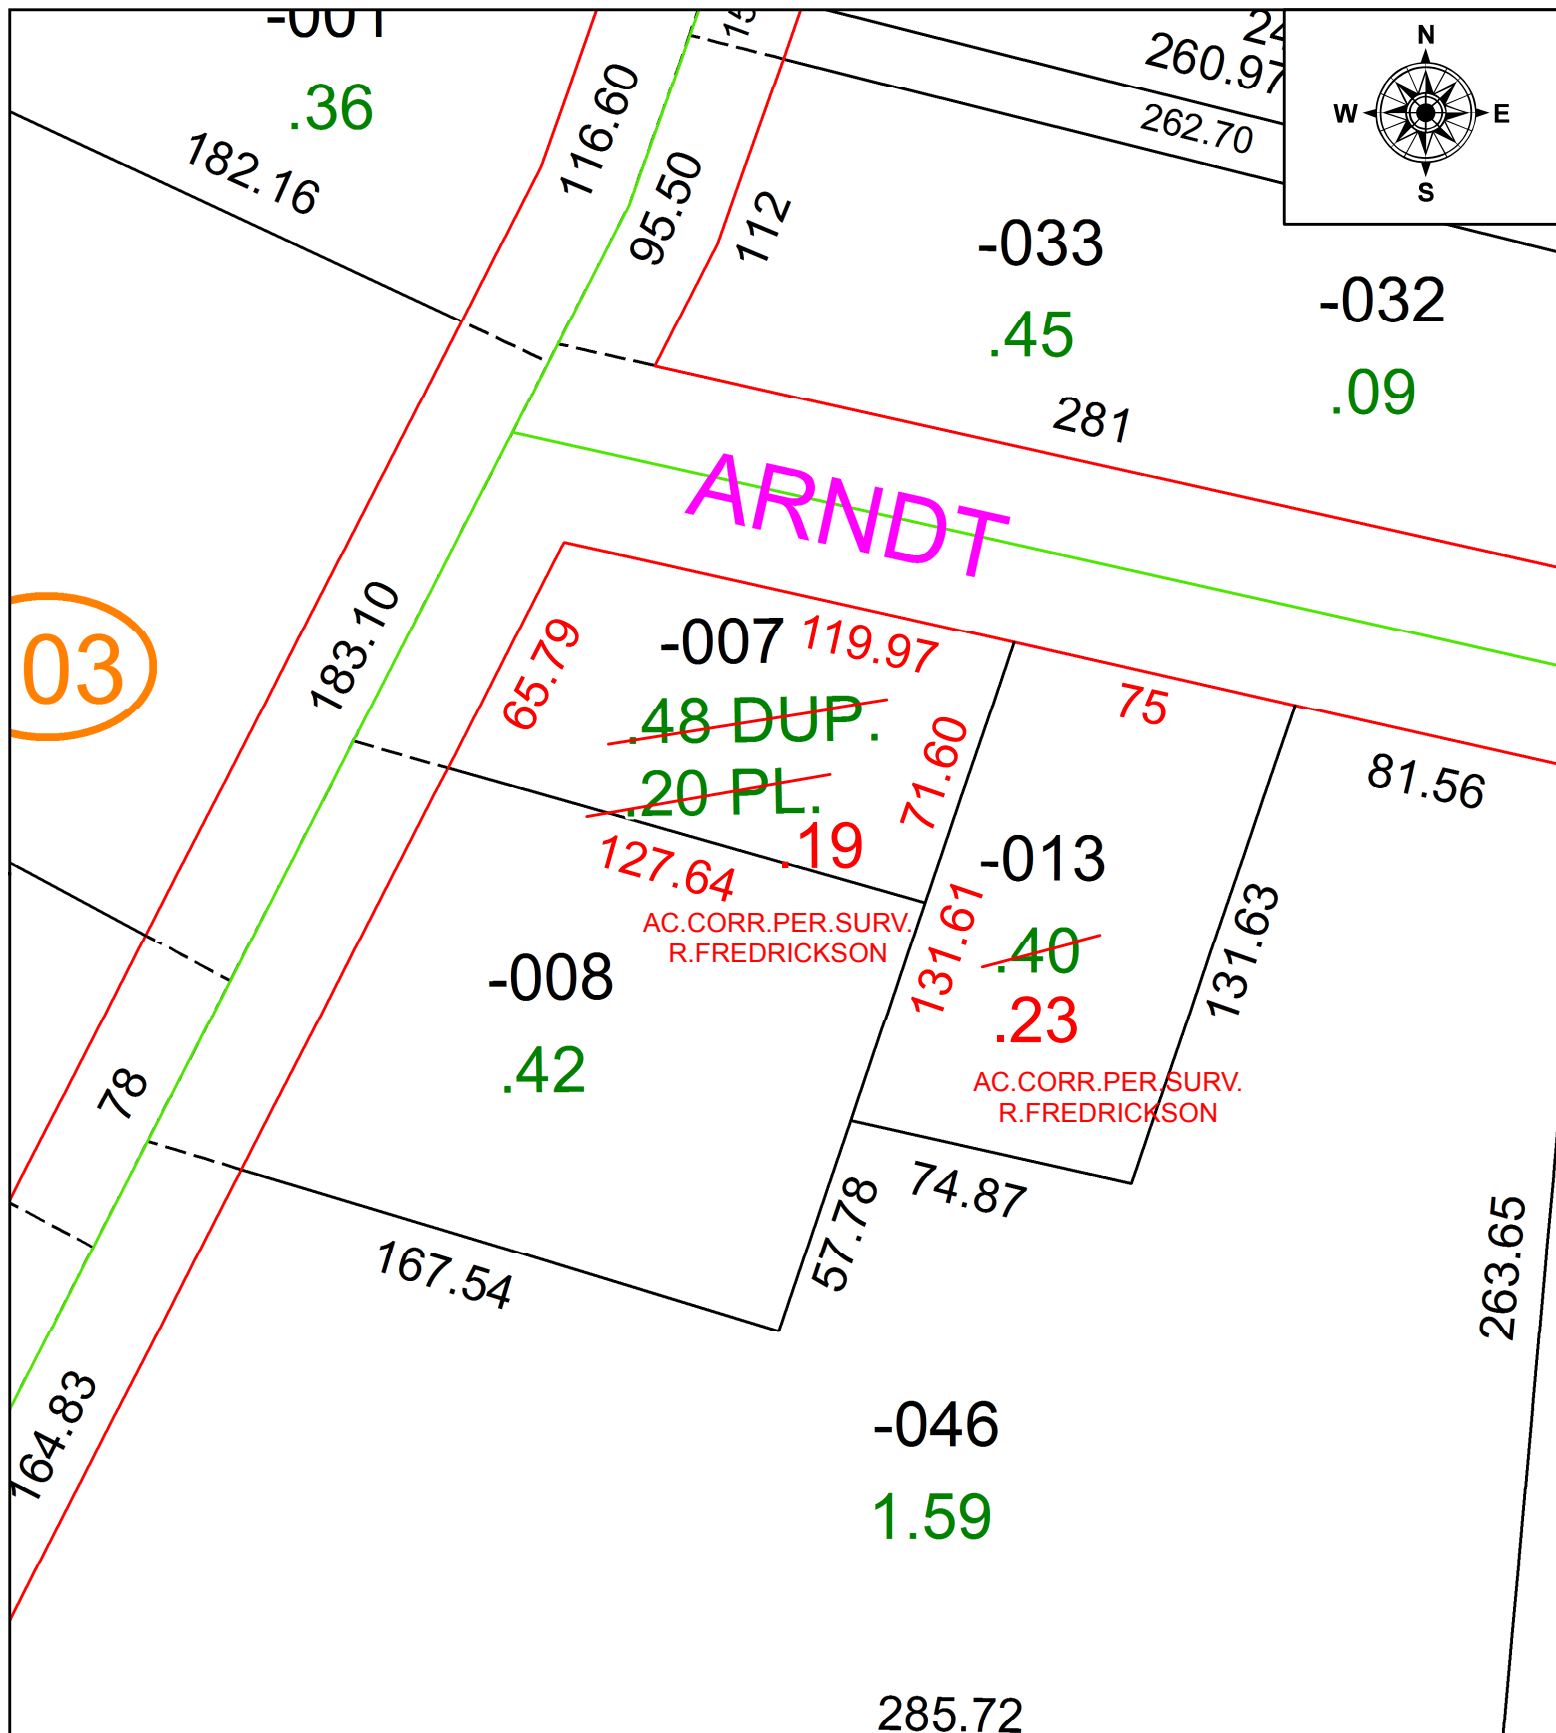

03


ARNDT

~~.48 DUP.~~  
~~.20 PL.~~  
 19

AC.CORR.PER.SURV. R.FREDRICKSON

~~.40~~  
 .23

AC.CORR.PER.SURV. R.FREDRICKSON

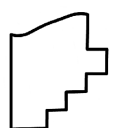

**SPLITS/DEEDS PROCESSED**  
 LORAIN COUNTY TAX MAP DEPARTMENT  
 226 MIDDLE AVE. ELYRIA, OH

SURVEYED BY:	RICHARD A. FREDRICKSON
CLOSURE:	1:62,093
MAP PAGE(S):	1-00-022
APPROVED BY:	RRM DATE: 7-9-20
SCALE:	1" = 50
PRIOR INSTRUMENT:	20070217089