
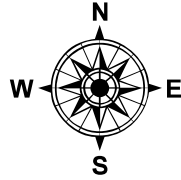


PARENT PARCEL: 03-00-015-000-047, -049, 03-00-016-000-009

CHILD PARCEL: 03-00-016-000-009, 03-00-015-000-061, -062 AC CORR PER SURV BY JOHN DECHANT JR

21-04363

STARTING POINT: INTERSECTION OF ABBE AND FRENCH CREEK RD

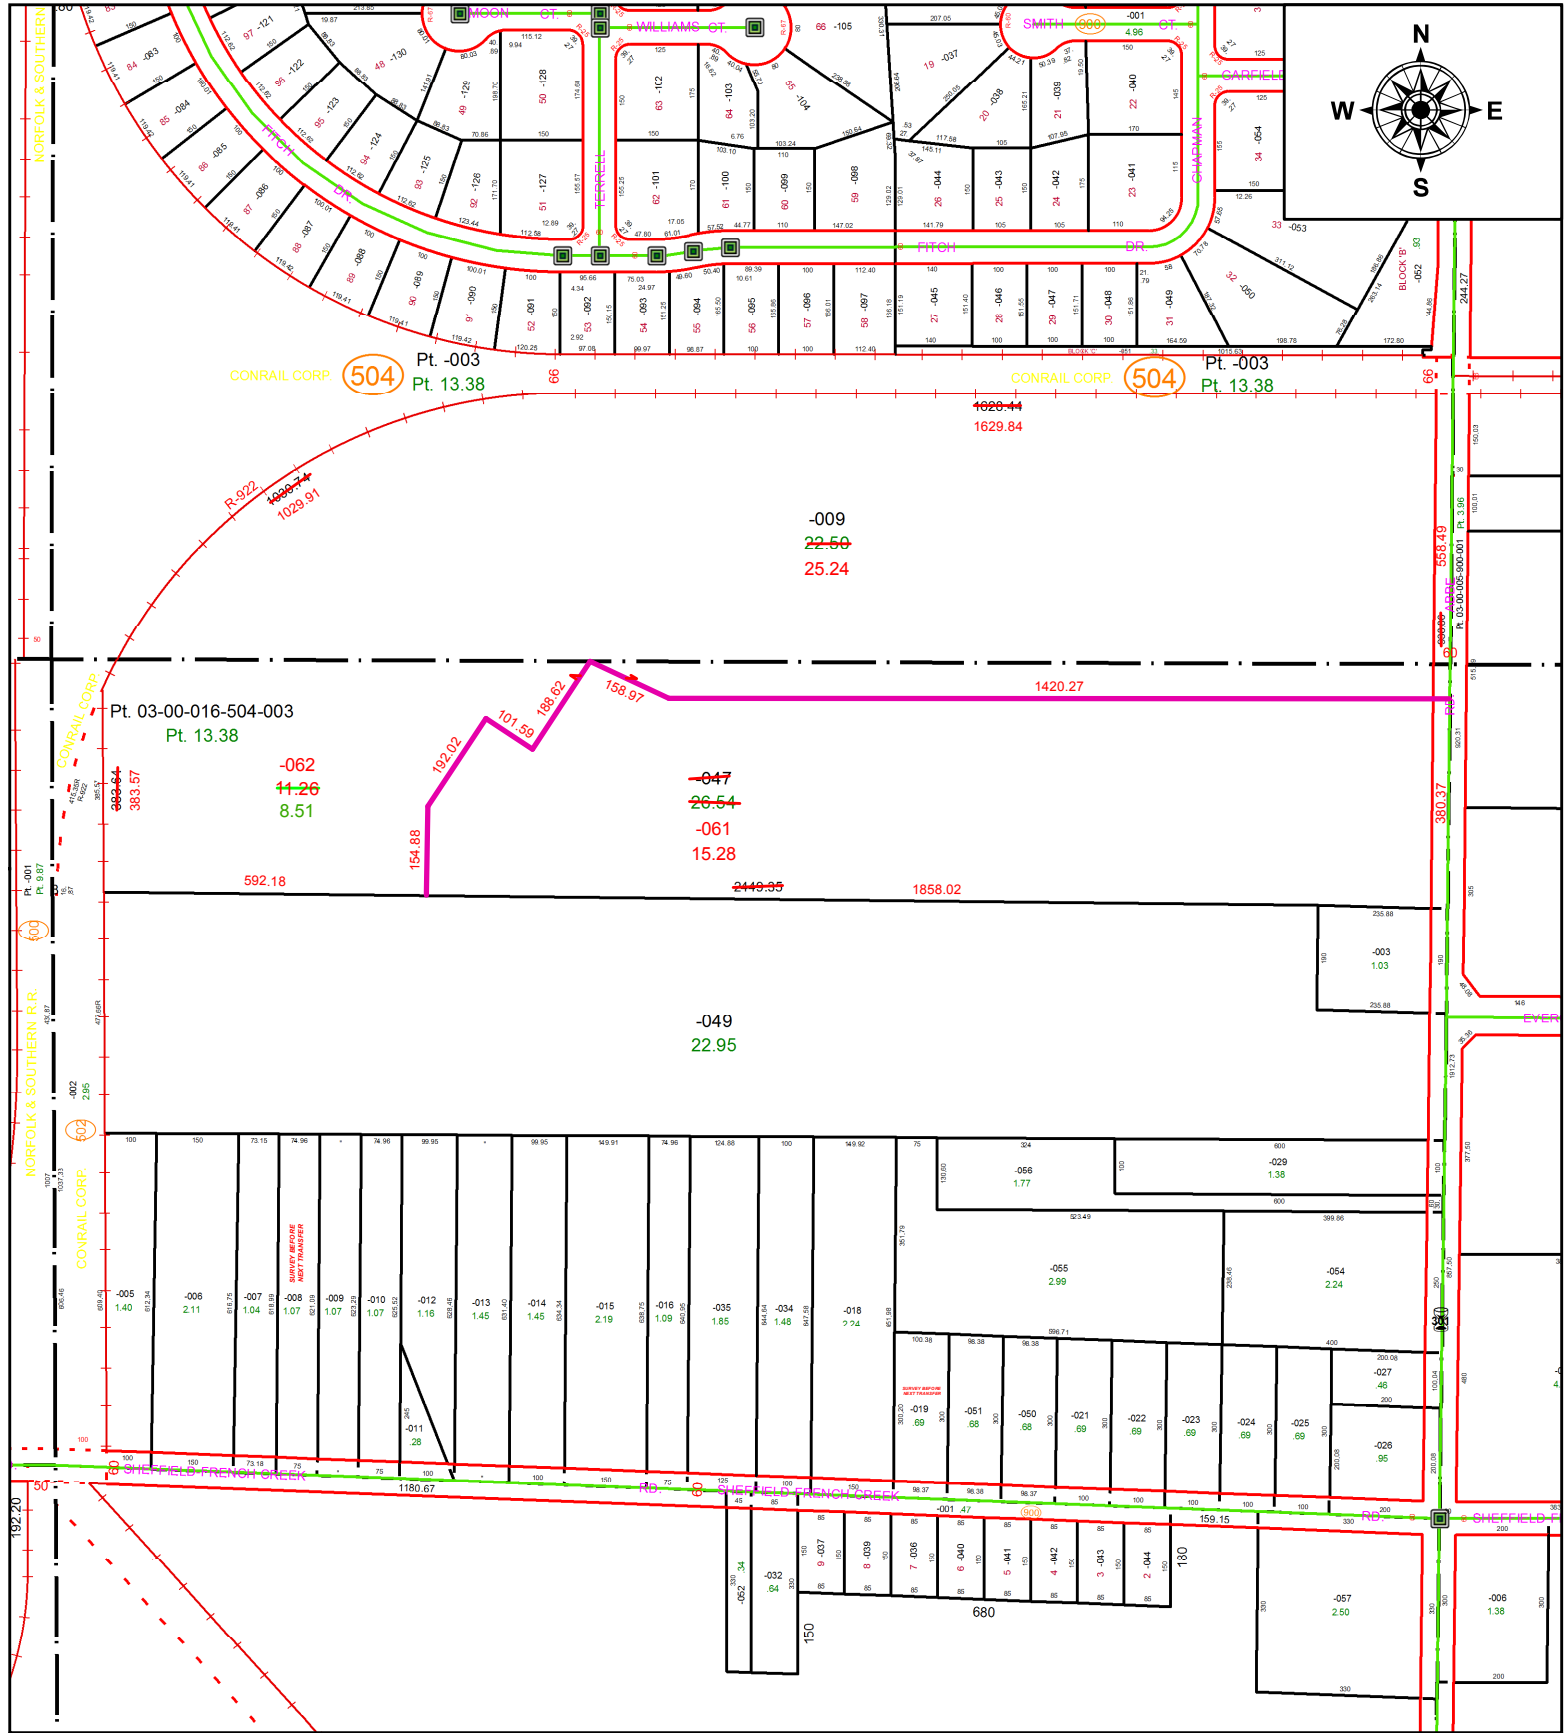

**SPLITS/DEEDS PROCESSED**  
 LORAIN COUNTY TAX MAP DEPARTMENT  
 226 MIDDLE AVE. ELYRIA, OH

**SURVEYED BY:** JOHN A. DECHANT JR.  
**CLOSURE:** 1: 332776  
**MAP PAGE(S):** 03-00-015, 016  
**APPROVED BY:** AC **DATE:** 9/2/2021  
**SCALE:** 1" = 350 **PRIOR INSTRUMENT:** 2011- 0375428