
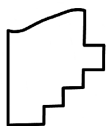


PARENT PARCEL: 06-24-027-106-017, -018

CHILD PARCEL: 06-24-027-106-044

STARTING POINT: SW CORNER OF SL 208 **FRONTAGE & DEPTH TO ACREAGE CORRECTION**

21-04364

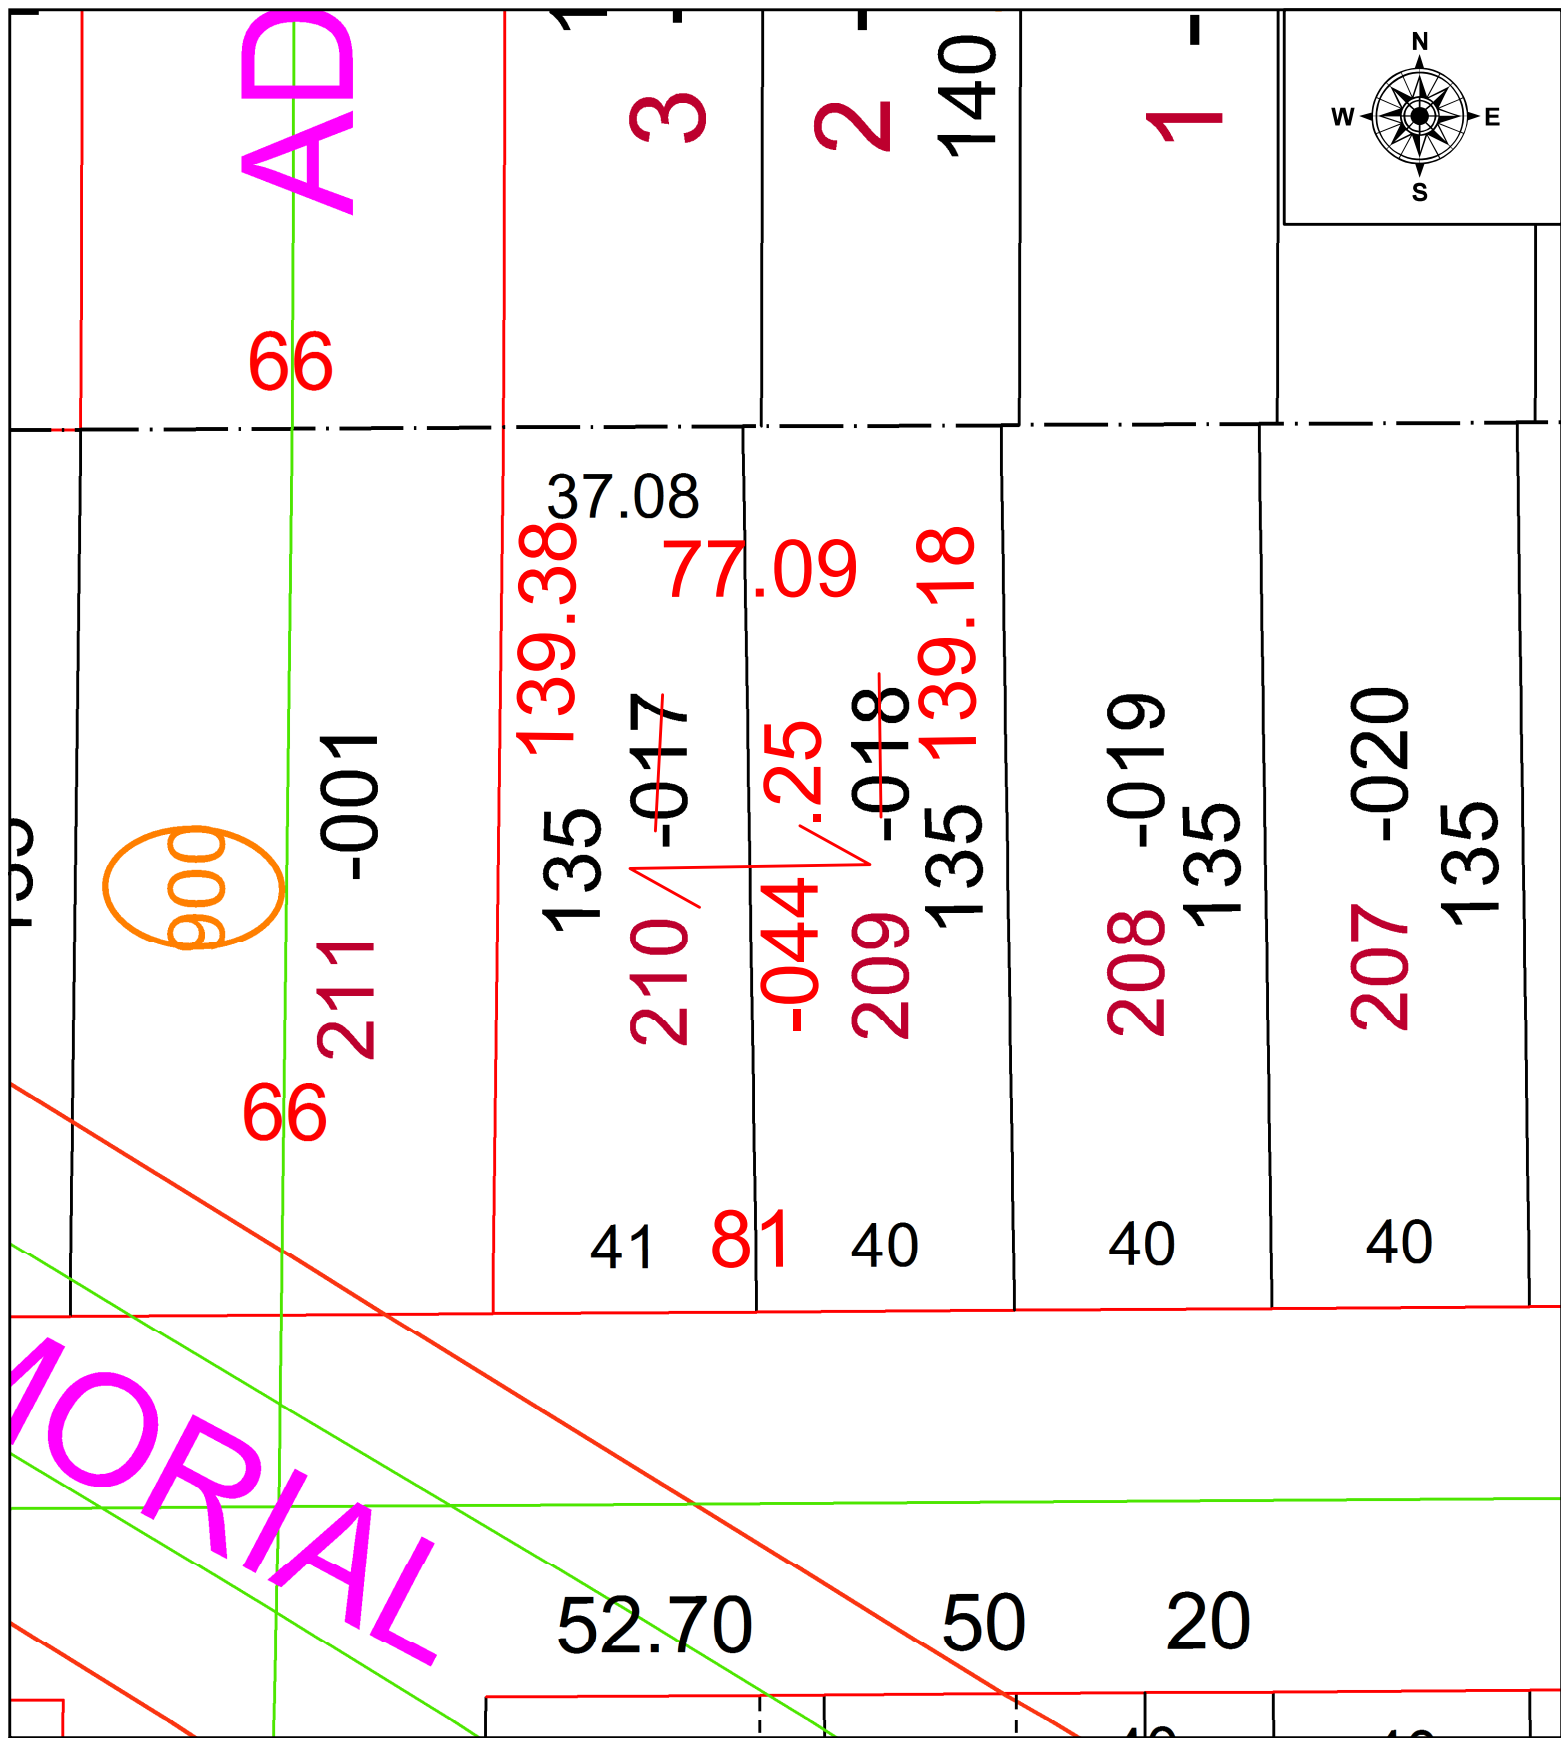

SPLITS/DEEDS PROCESSED
 LORAIN COUNTY TAX MAP DEPARTMENT
 226 MIDDLE AVE. ELYRIA, OH

SURVEYED BY: THOMAS A. SIMON
 CLOSURE: 1: 43384
 MAP PAGE(S): 06-24-027
 APPROVED BY: AC DATE: 9/2/2021
 SCALE: 1" = 30' PRIOR INSTRUMENT: 2020- 0771605