


PARENT PARCEL: 06-23-025-105-058, -061

CHILD PARCEL: 06-23-025-105-068

STARTING POINT: NORTHEAST CORNER OF S/L 28 IN VALLEY BROOKS HILLS SUB.

20-04365-C

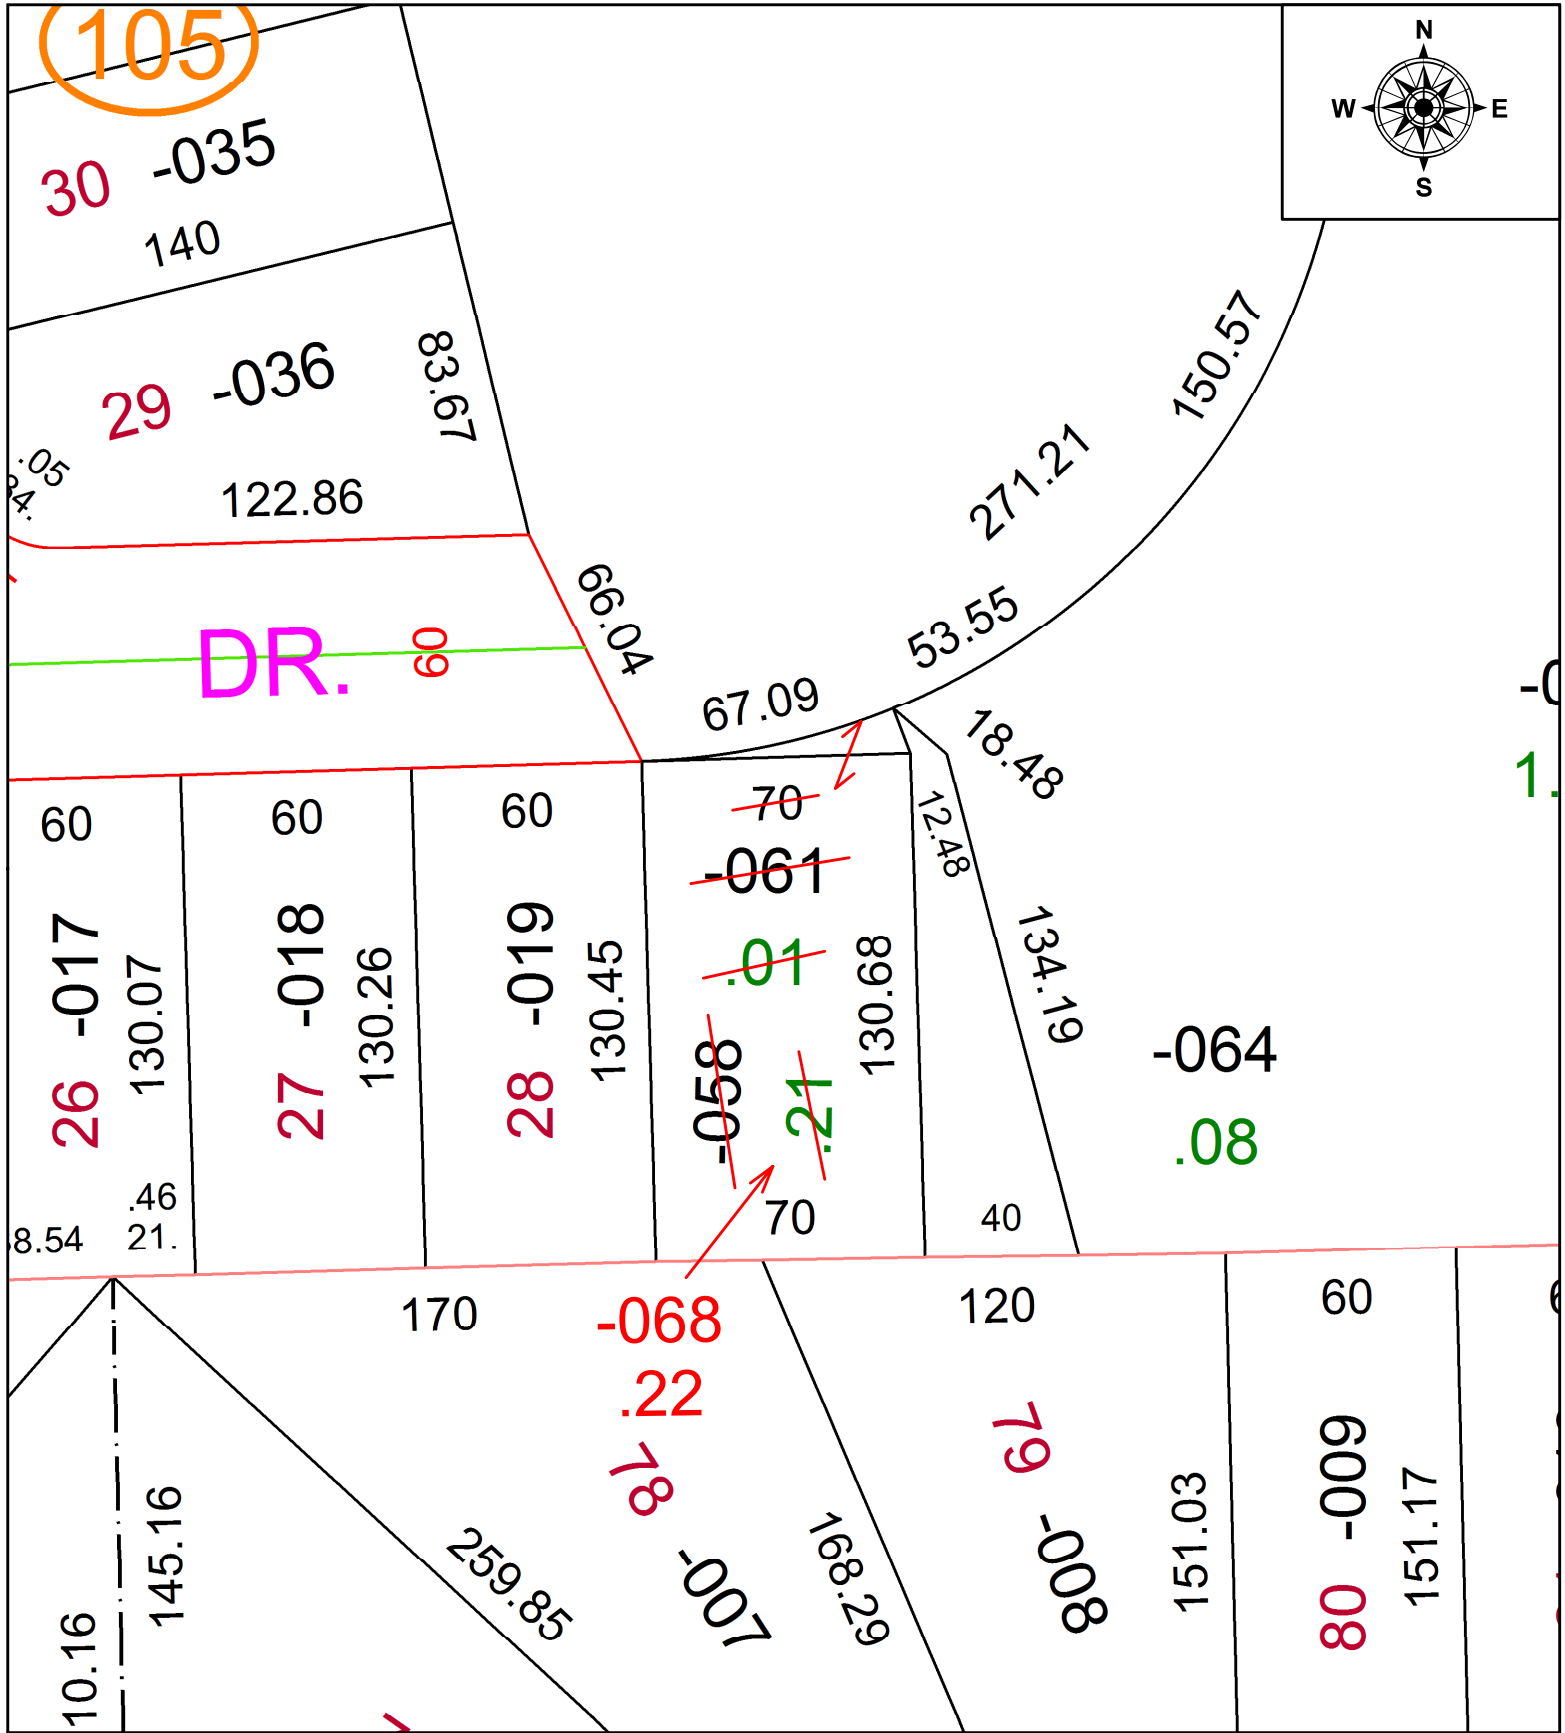

SPLITS/DEEDS PROCESSED
 LORAIN COUNTY TAX MAP DEPARTMENT
 226 MIDDLE AVE. ELYRIA, OH

SURVEYED BY: N/A
 CLOSURE: N/A
 MAP PAGE(S): 6-23-025
 APPROVED BY: RRM DATE: 7-13-20
 SCALE: 1" = 50 PRIOR INSTRUMENT: 20130456441