


PARENT PARCEL: 03-00-041-117-032 THRU -036

CHILD PARCEL: 03-00-041-117-047, -048

STARTING POINT: SE CORNER OF SUBLOT 83 FRONTAGE & DEPTH TO ACREAGE CORR

21-04366

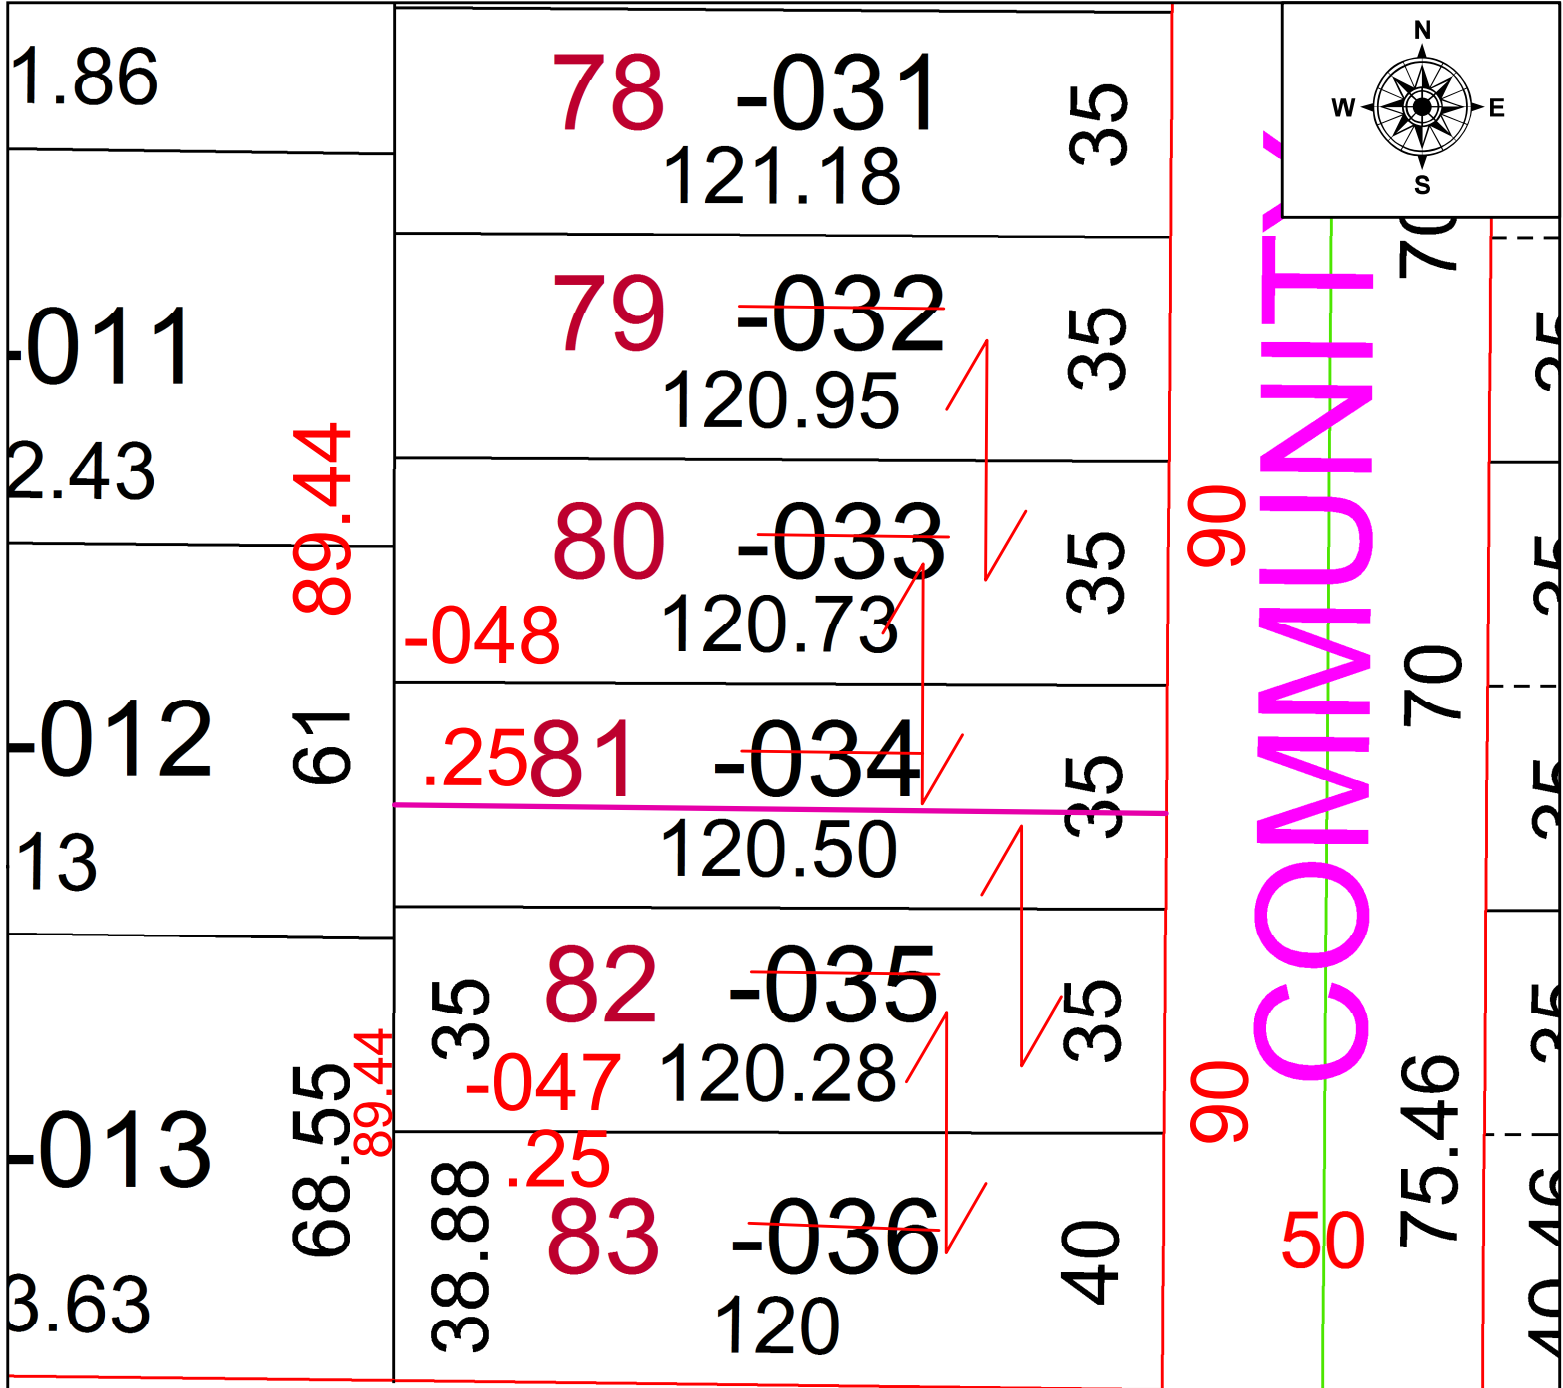

SPLITS/DEEDS PROCESSED
LORAIN COUNTY TAX MAP DEPARTMENT
226 MIDDLE AVE. ELYRIA, OH

SURVEYED BY: RYAN SNEZEK
CLOSURE: 1: 187822
MAP PAGE(S): 03-00-041
APPROVED BY: AC DATE: 9/8/2021
SCALE: 1" = 30 PRIOR INSTRUMENT: 2019- 0739389