


PARENT PARCEL: 14-00-028-000-008, 14-00-033-000-006

CHILD PARCEL: 14-00-028-000-008, 14-00-033-000-009, -010

STARTING POINT: SW CORNER OF O/L 28 AND NW CORNER OF O/L33

21-04368

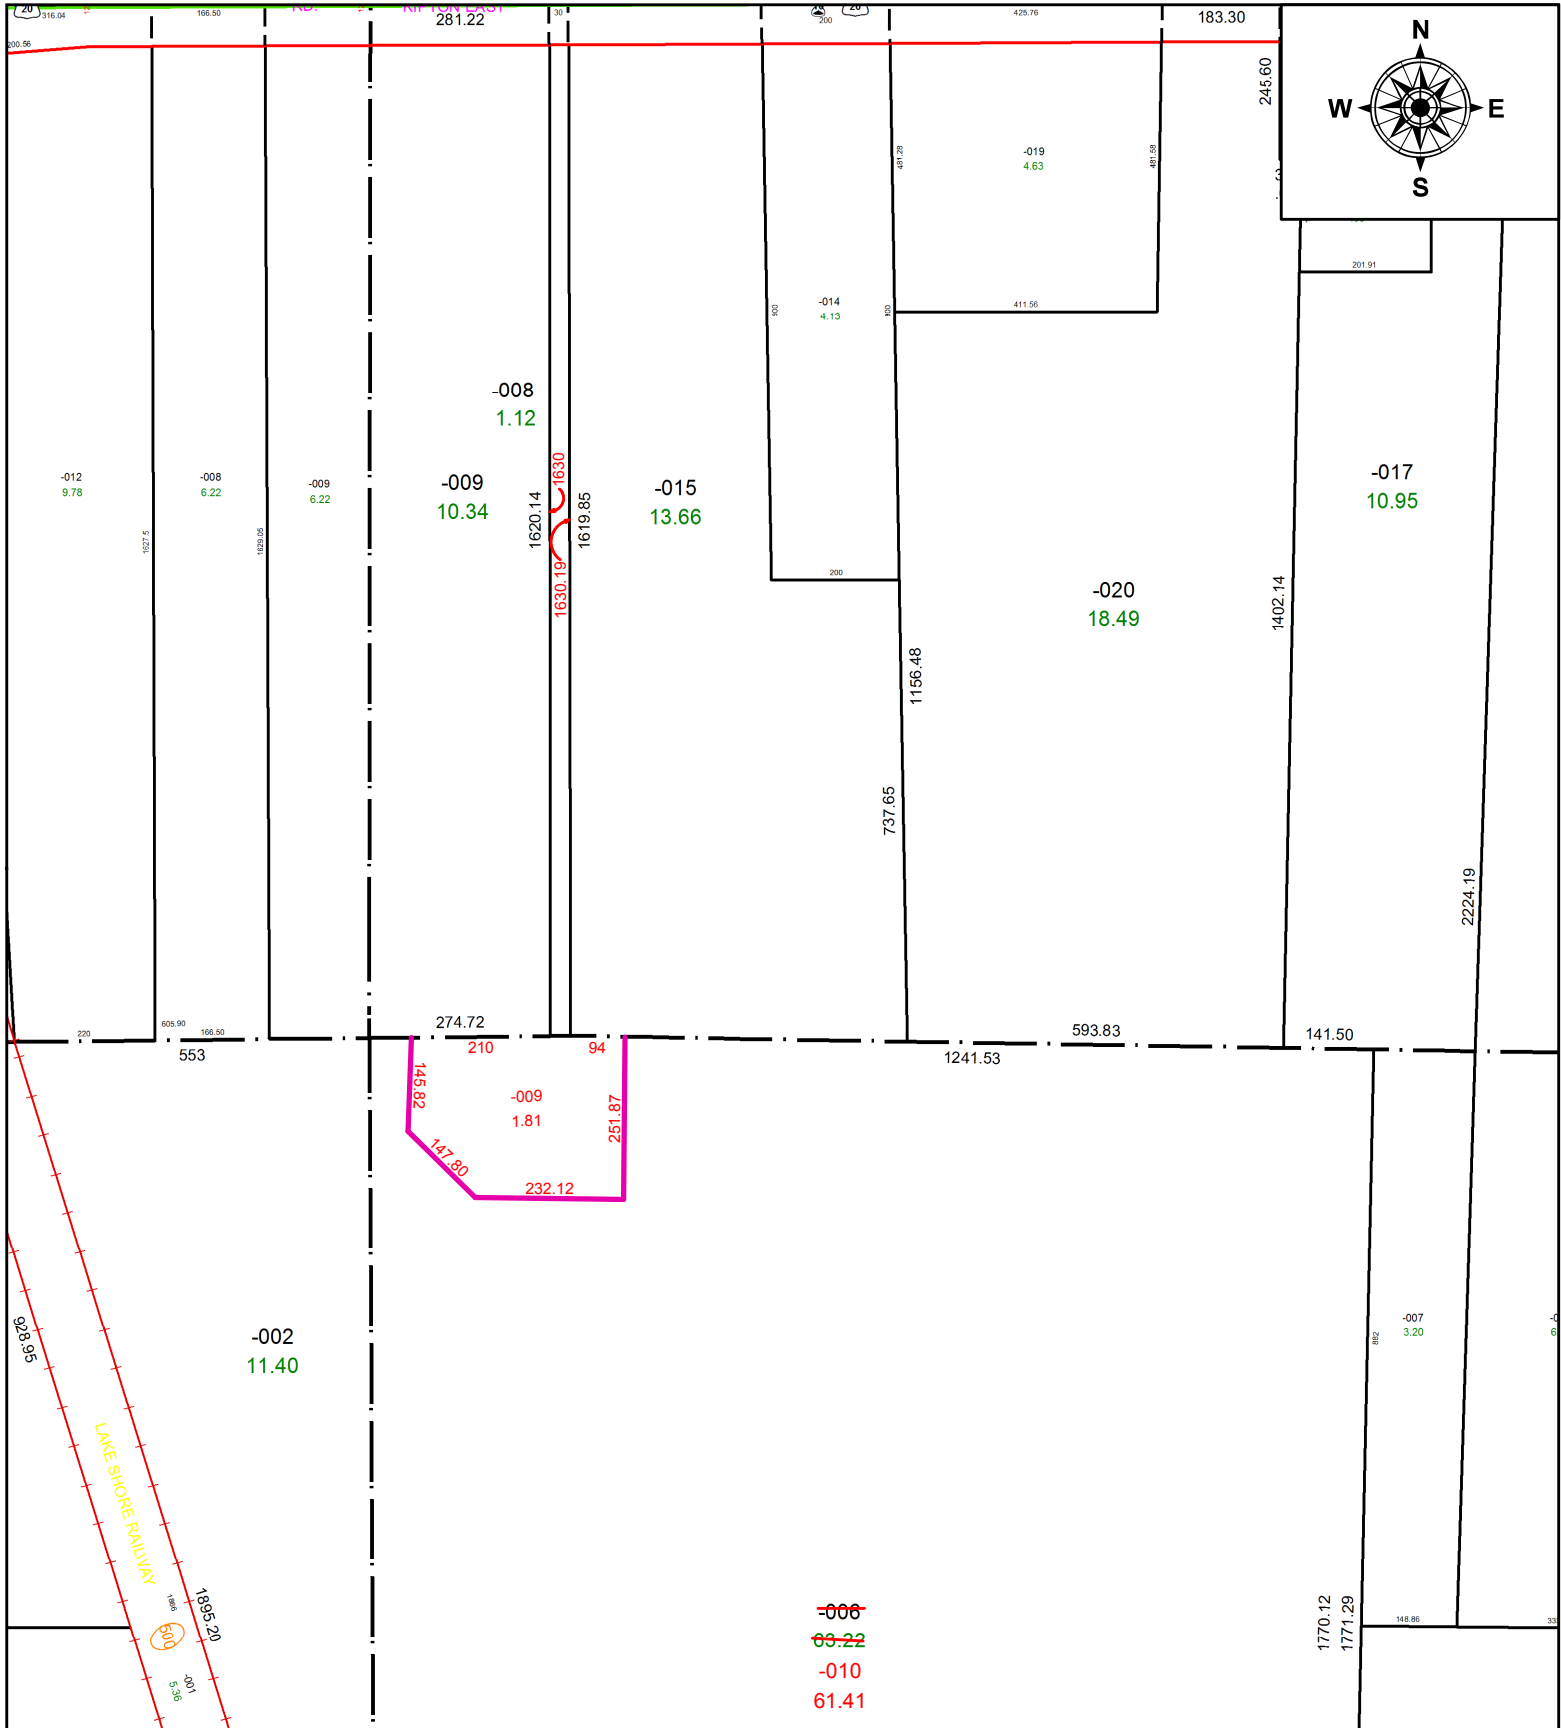

SPLITS/DEEDS PROCESSED
 LORAIN COUNTY TAX MAP DEPARTMENT
 226 MIDDLE AVE. ELYRIA, OH

SURVEYED BY: TIMOTHY D. HOZALSKI

CLOSURE: 1: 1041013

MAP PAGE(S): 14-00-033

APPROVED BY: AC DATE: 9/9/2021

SCALE: 1" = 300 PRIOR INSTRUMENT: 2021- 0801242