
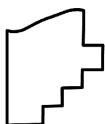


PARENT PARCEL: 11-00-007-000-023, -024

CHILD PARCEL: 11-00-007-000-084 FRONTAGE & DEPTH TO AC CORR PER SURVEY BY G. HOFMANN

STARTING POINT: C/L OF HAWKE AND COOLEY RD

21-04372

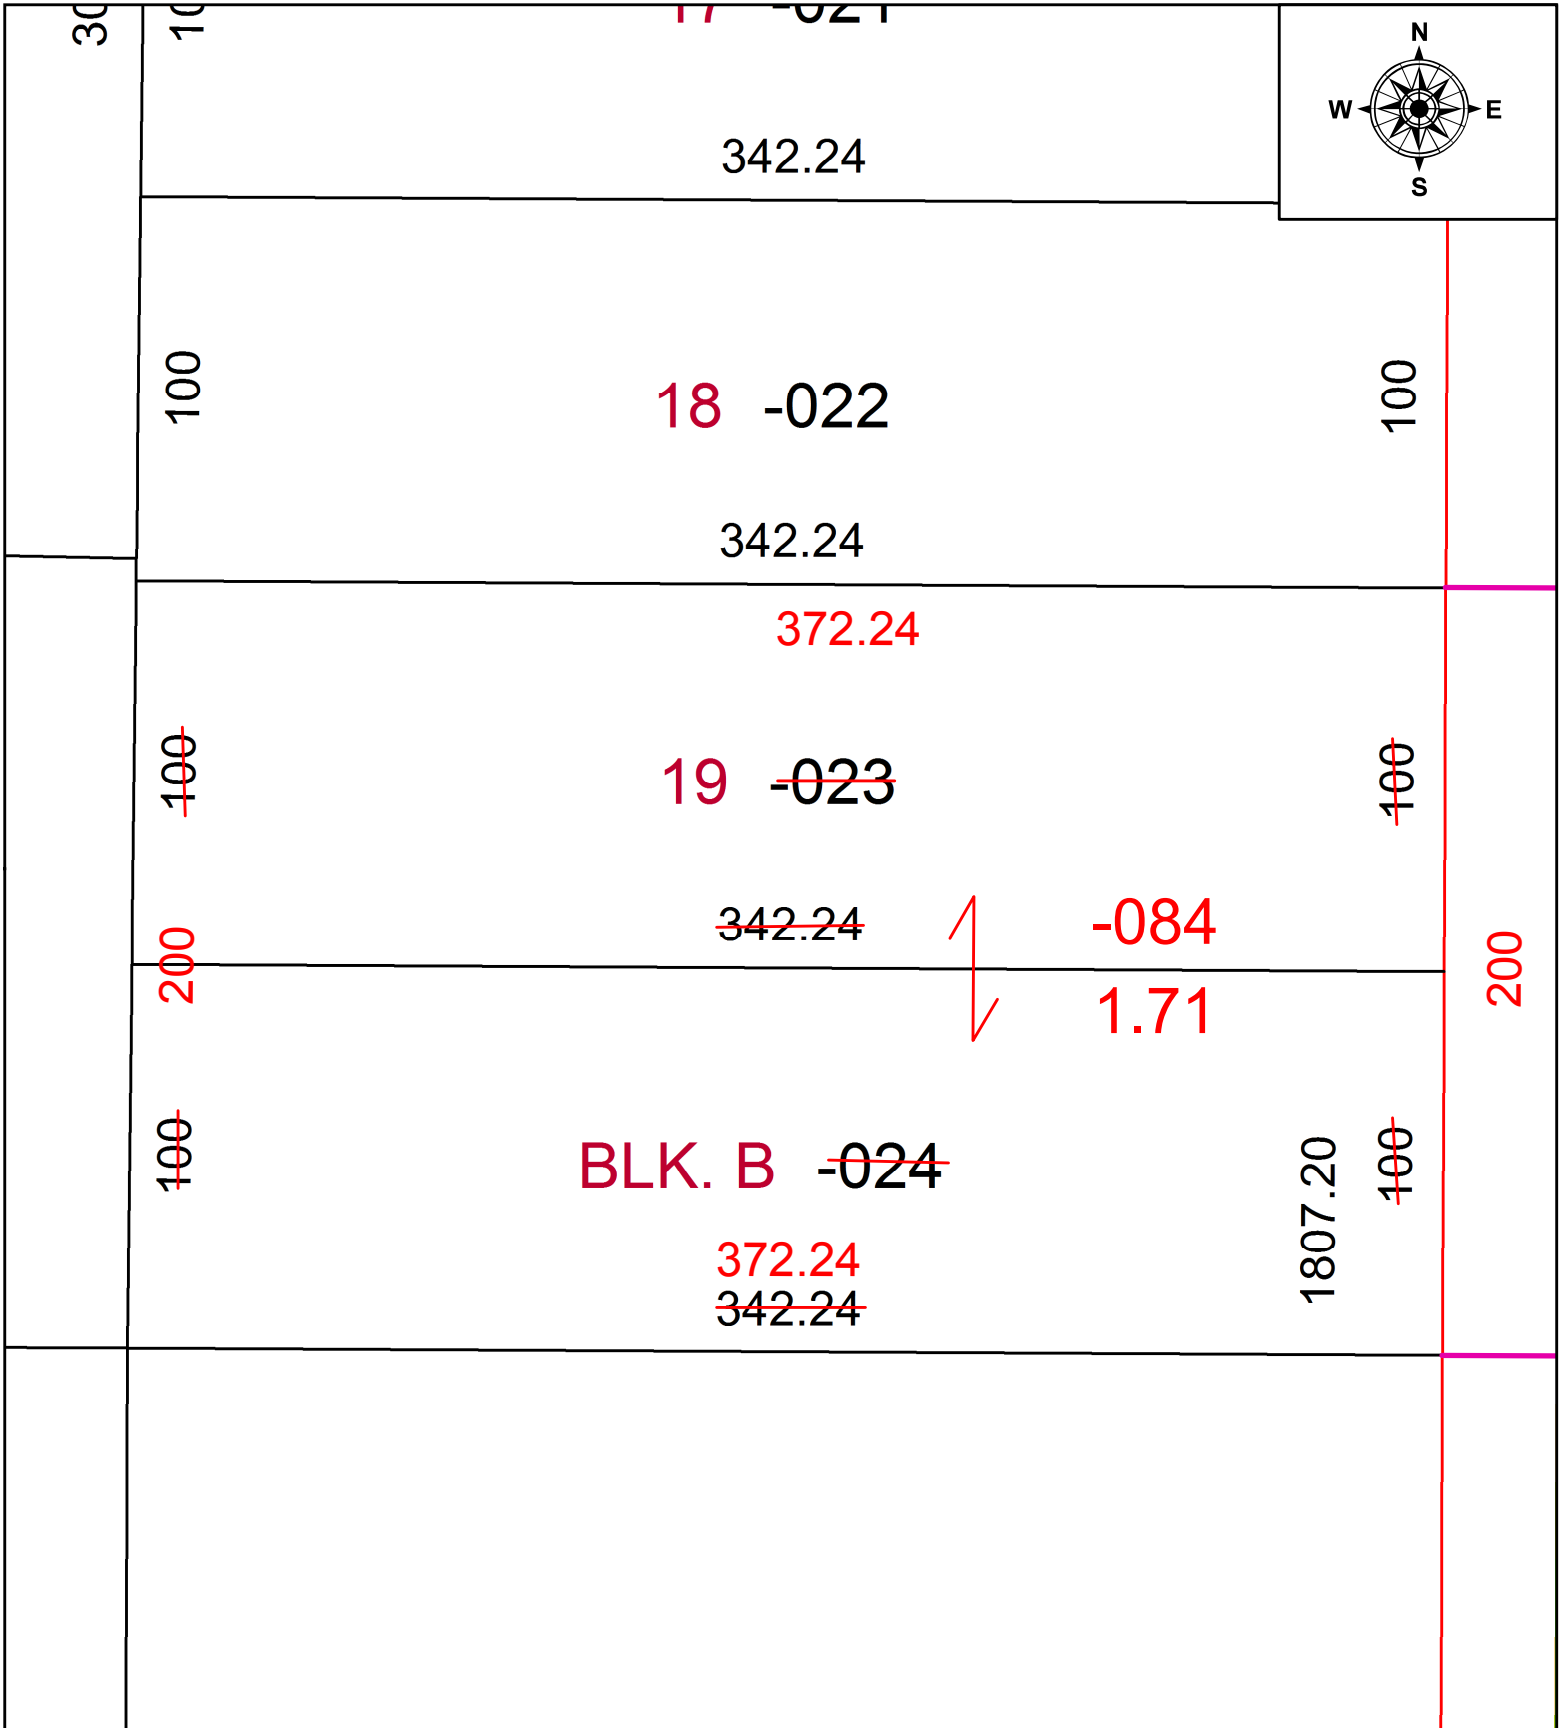

SPLITS/DEEDS PROCESSED
 LORAIN COUNTY TAX MAP DEPARTMENT
 226 MIDDLE AVE. ELYRIA, OH

SURVEYED BY: GEORGE A. HOFMANN

CLOSURE: 1: 2147483648

MAP PAGE(S): 11-00-007

APPROVED BY: AC DATE: 9/14/2021

SCALE: 1" = 50 PRIOR INSTRUMENT: 2015- 0546740