


PARENT PARCEL: 21-02-016-000-004 & -005


CHILD PARCEL: 21-02-016-000-006 THRU -008

STARTING POINT: CL OF BAKER RD. & NEW LONDON EASTERN RD.

21-04373

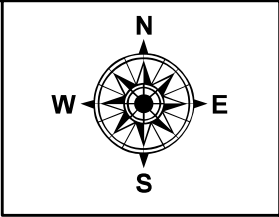


~~-007~~ ~~-005~~
48.25 49.21

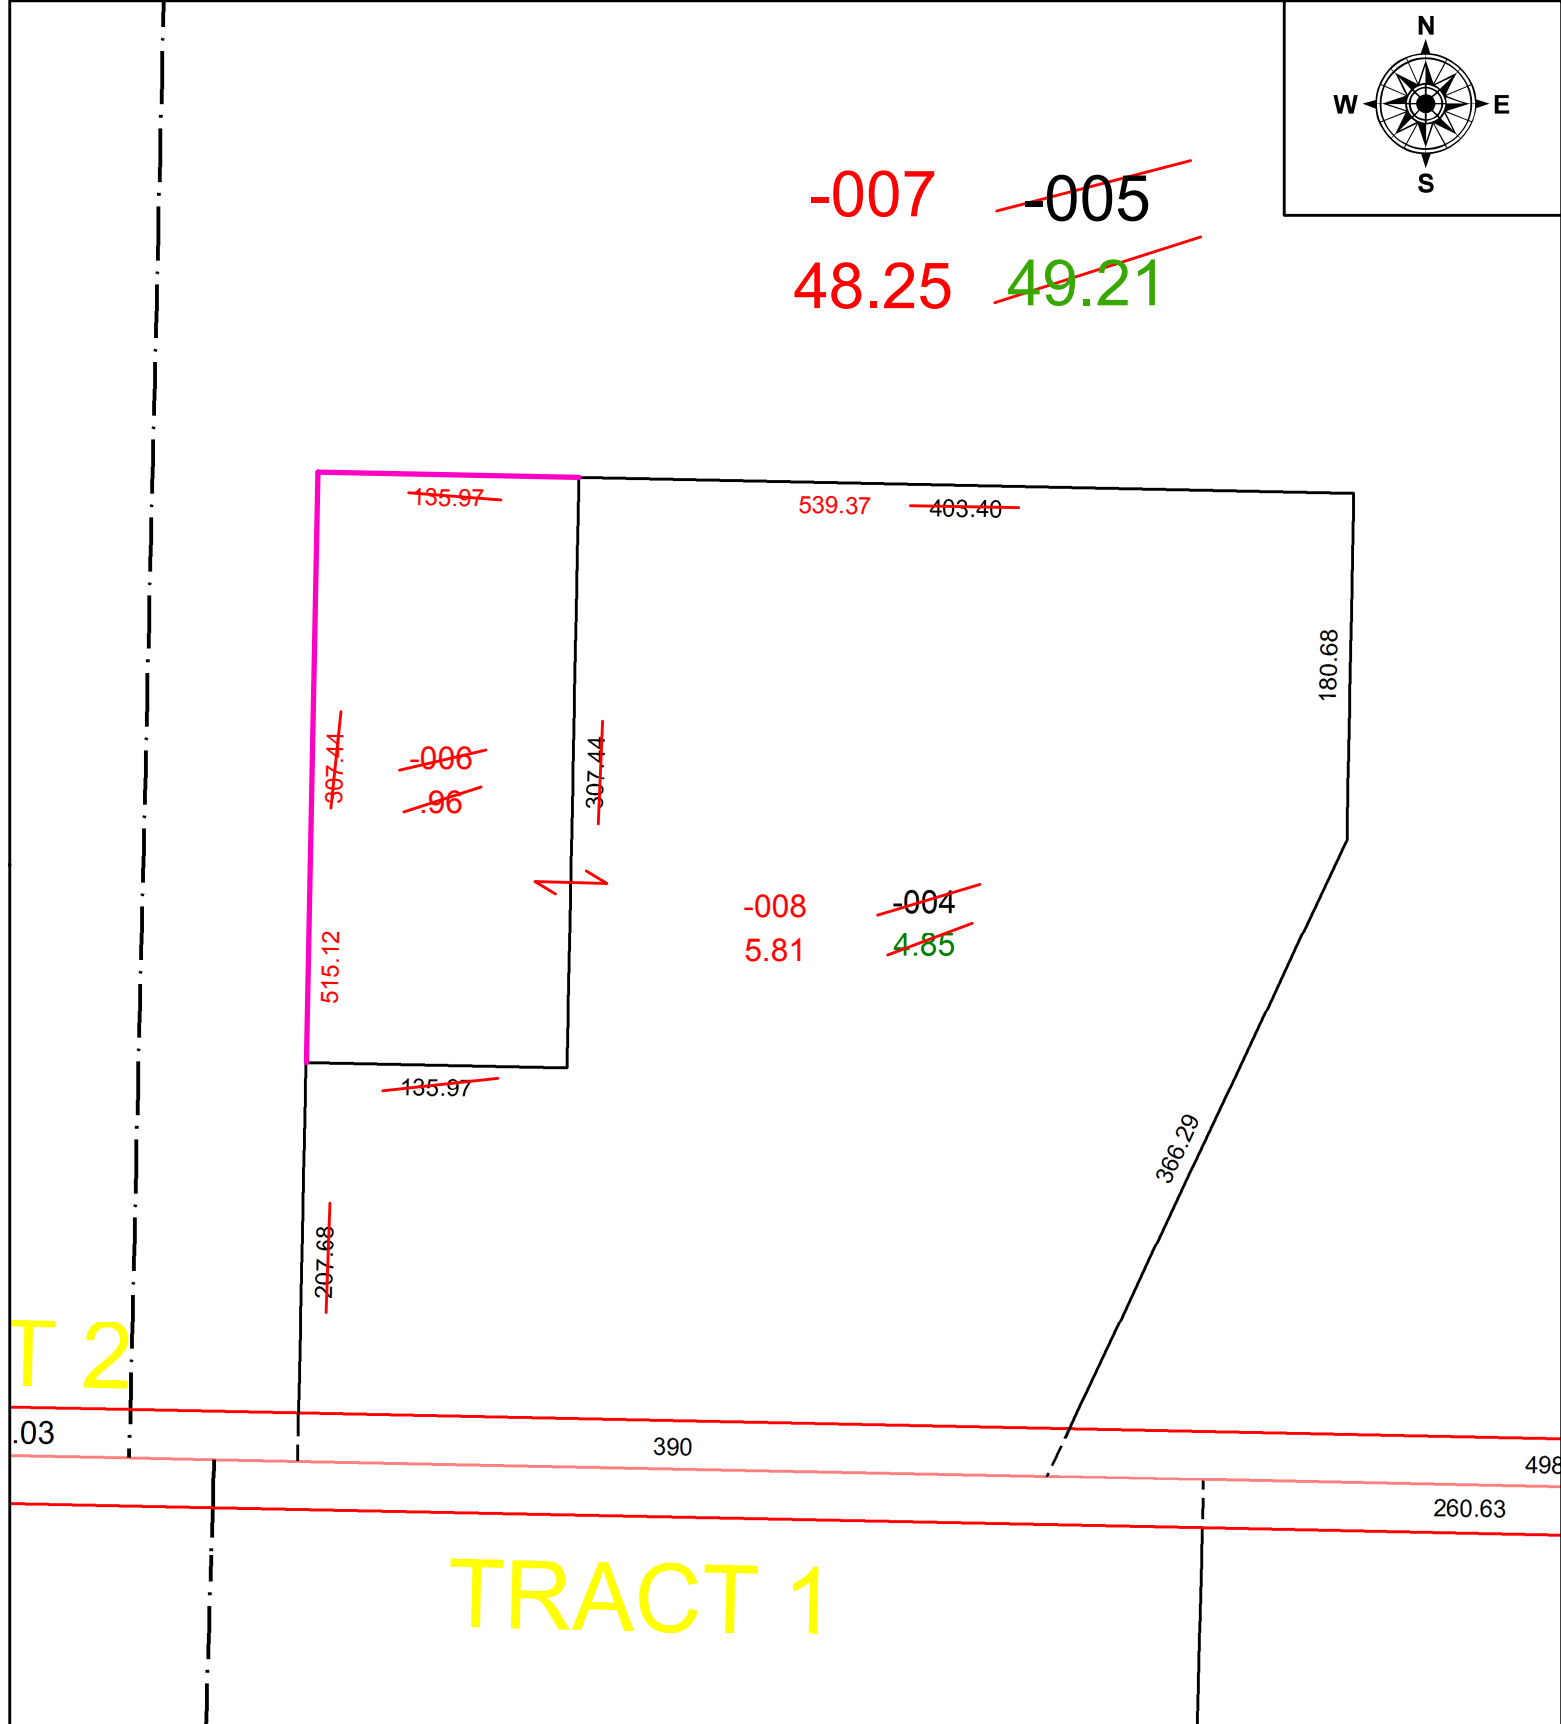

T 2

TRACT 1

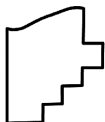

SPLITS/DEEDS PROCESSED
LORAIN COUNTY TAX MAP DEPARTMENT
226 MIDDLE AVE. ELYRIA, OH

SURVEYED BY: THOMAS SIMON
CLOSURE: 1: 2147483648
MAP PAGE(S): 21-02-016
APPROVED BY: DMA DATE: 9/14/2021
SCALE: 1" = 100' PRIOR INSTRUMENT: 20110363358