
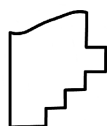
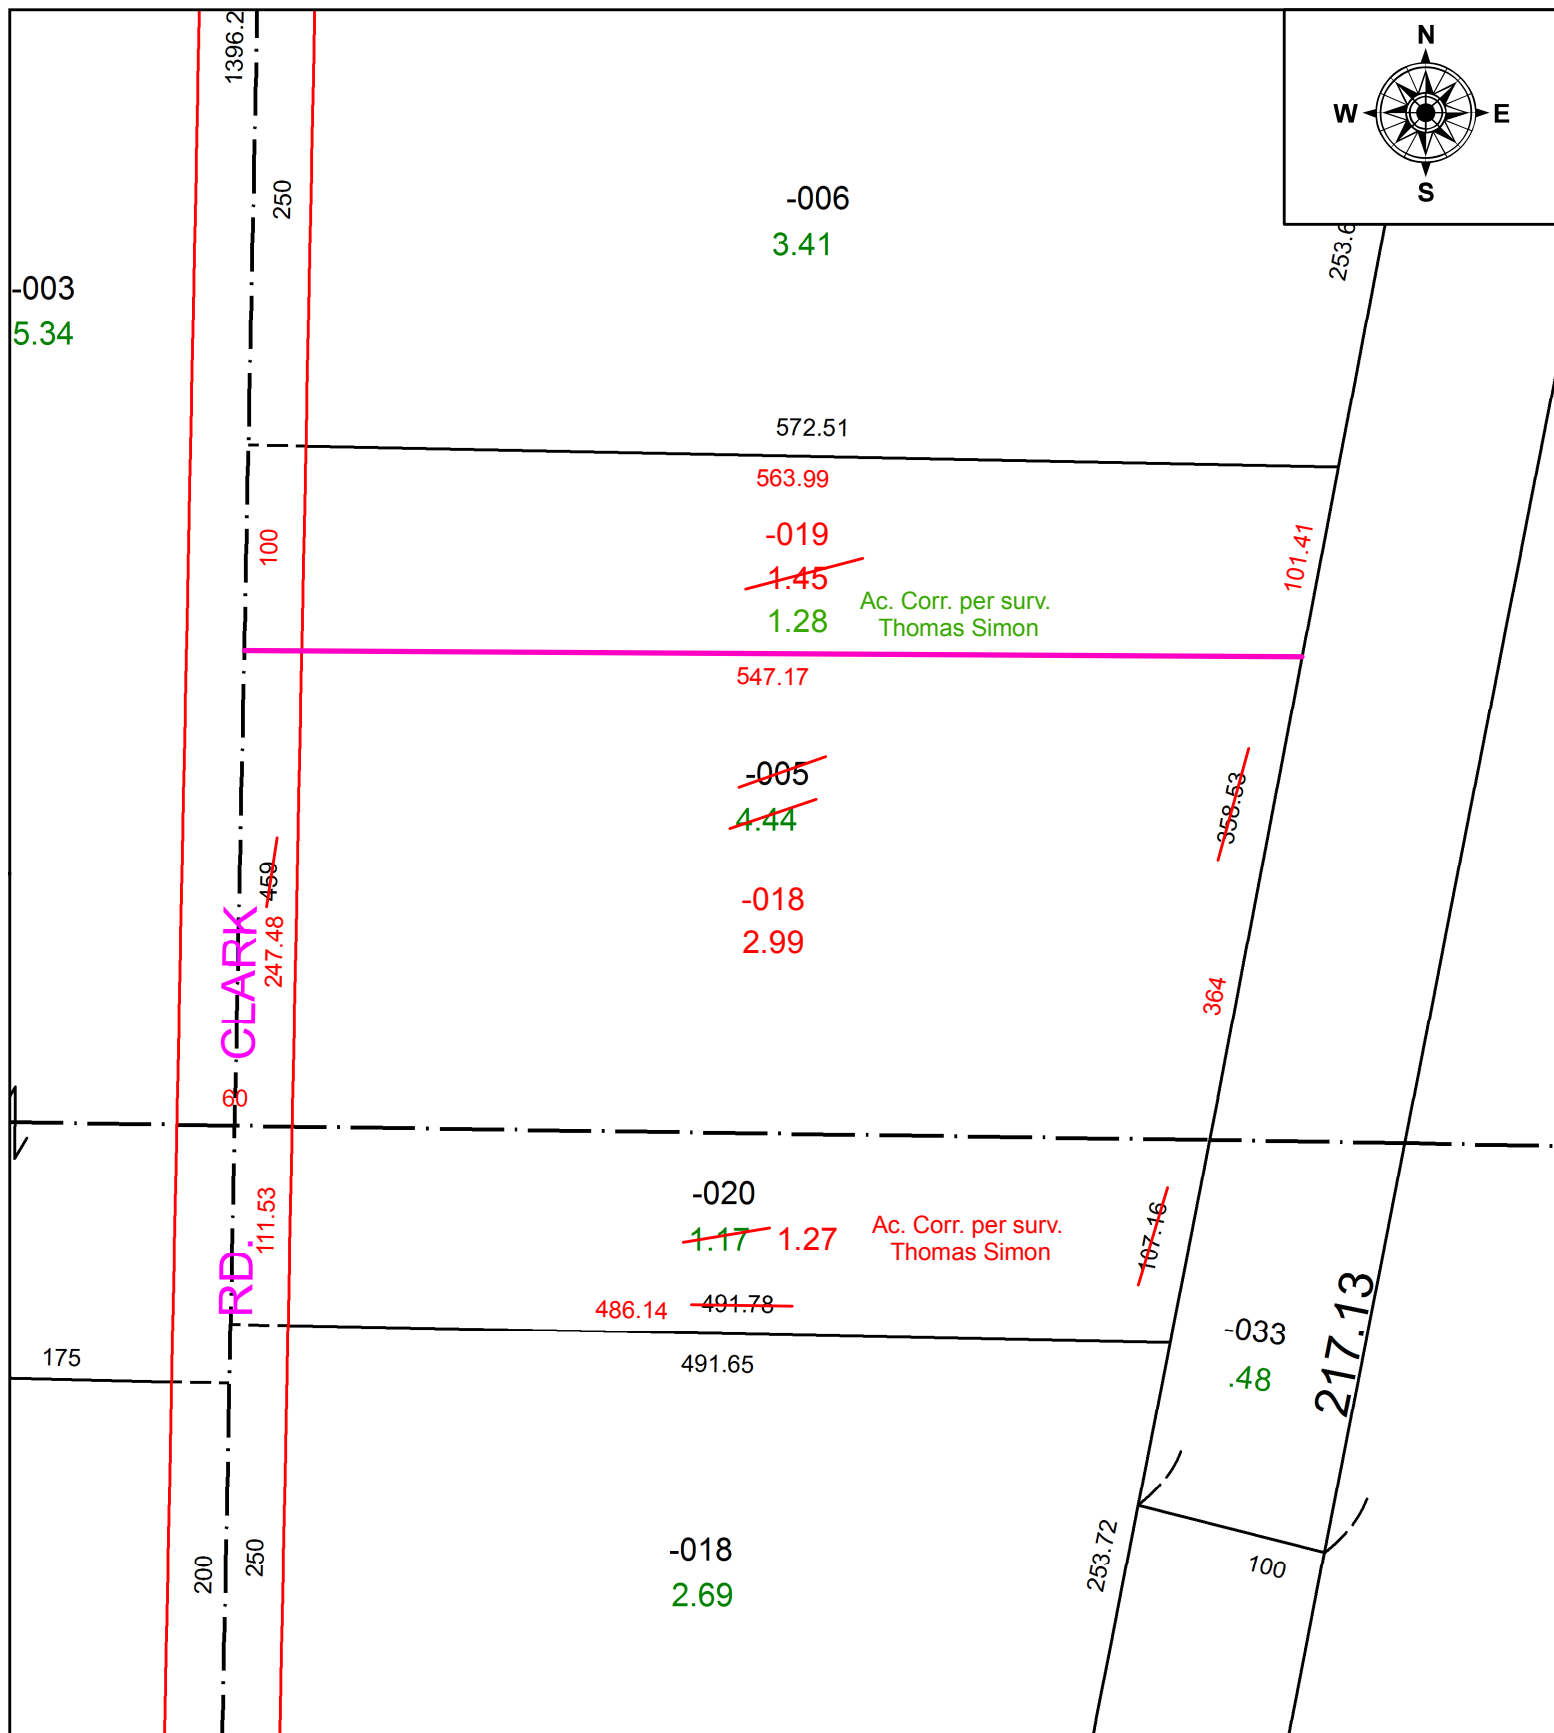


PARENT PARCEL: 21-05-012-000-020 & 21-05-013-000-005

CHILD PARCEL: 21-05-013-000-018 & -019 21-05-012-000-020 Str. Trns.

STARTING POINT: CL OF BURSLEY RD. & CLARK RD.

21-04375

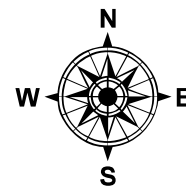

**SPLITS/DEEDS PROCESSED**  
 LORAIN COUNTY TAX MAP DEPARTMENT  
 226 MIDDLE AVE. ELYRIA, OH

SURVEYED BY: THOMAS SIMON  
 CLOSURE: 1: 746498  
 MAP PAGE(S): 21-05-012 & 21-05-013  
 APPROVED BY: DMA DATE: 9/15/2021  
 SCALE: 1" = 100' PRIOR INSTRUMENT: 20110362177