
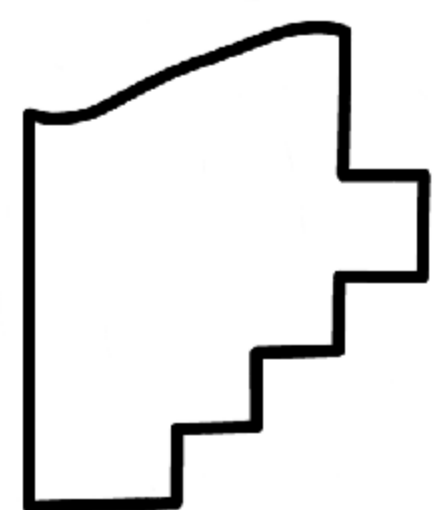


PARENT PARCEL: 05-00-044-000-096

CHILD PARCEL: 05-00-044-000-106, -107, -108

STARTING POINT: MONUMENT BOX AT CENTER OF CUL-DE-SAC OF RICE INDUSTRIAL PARKWAY

21-04376

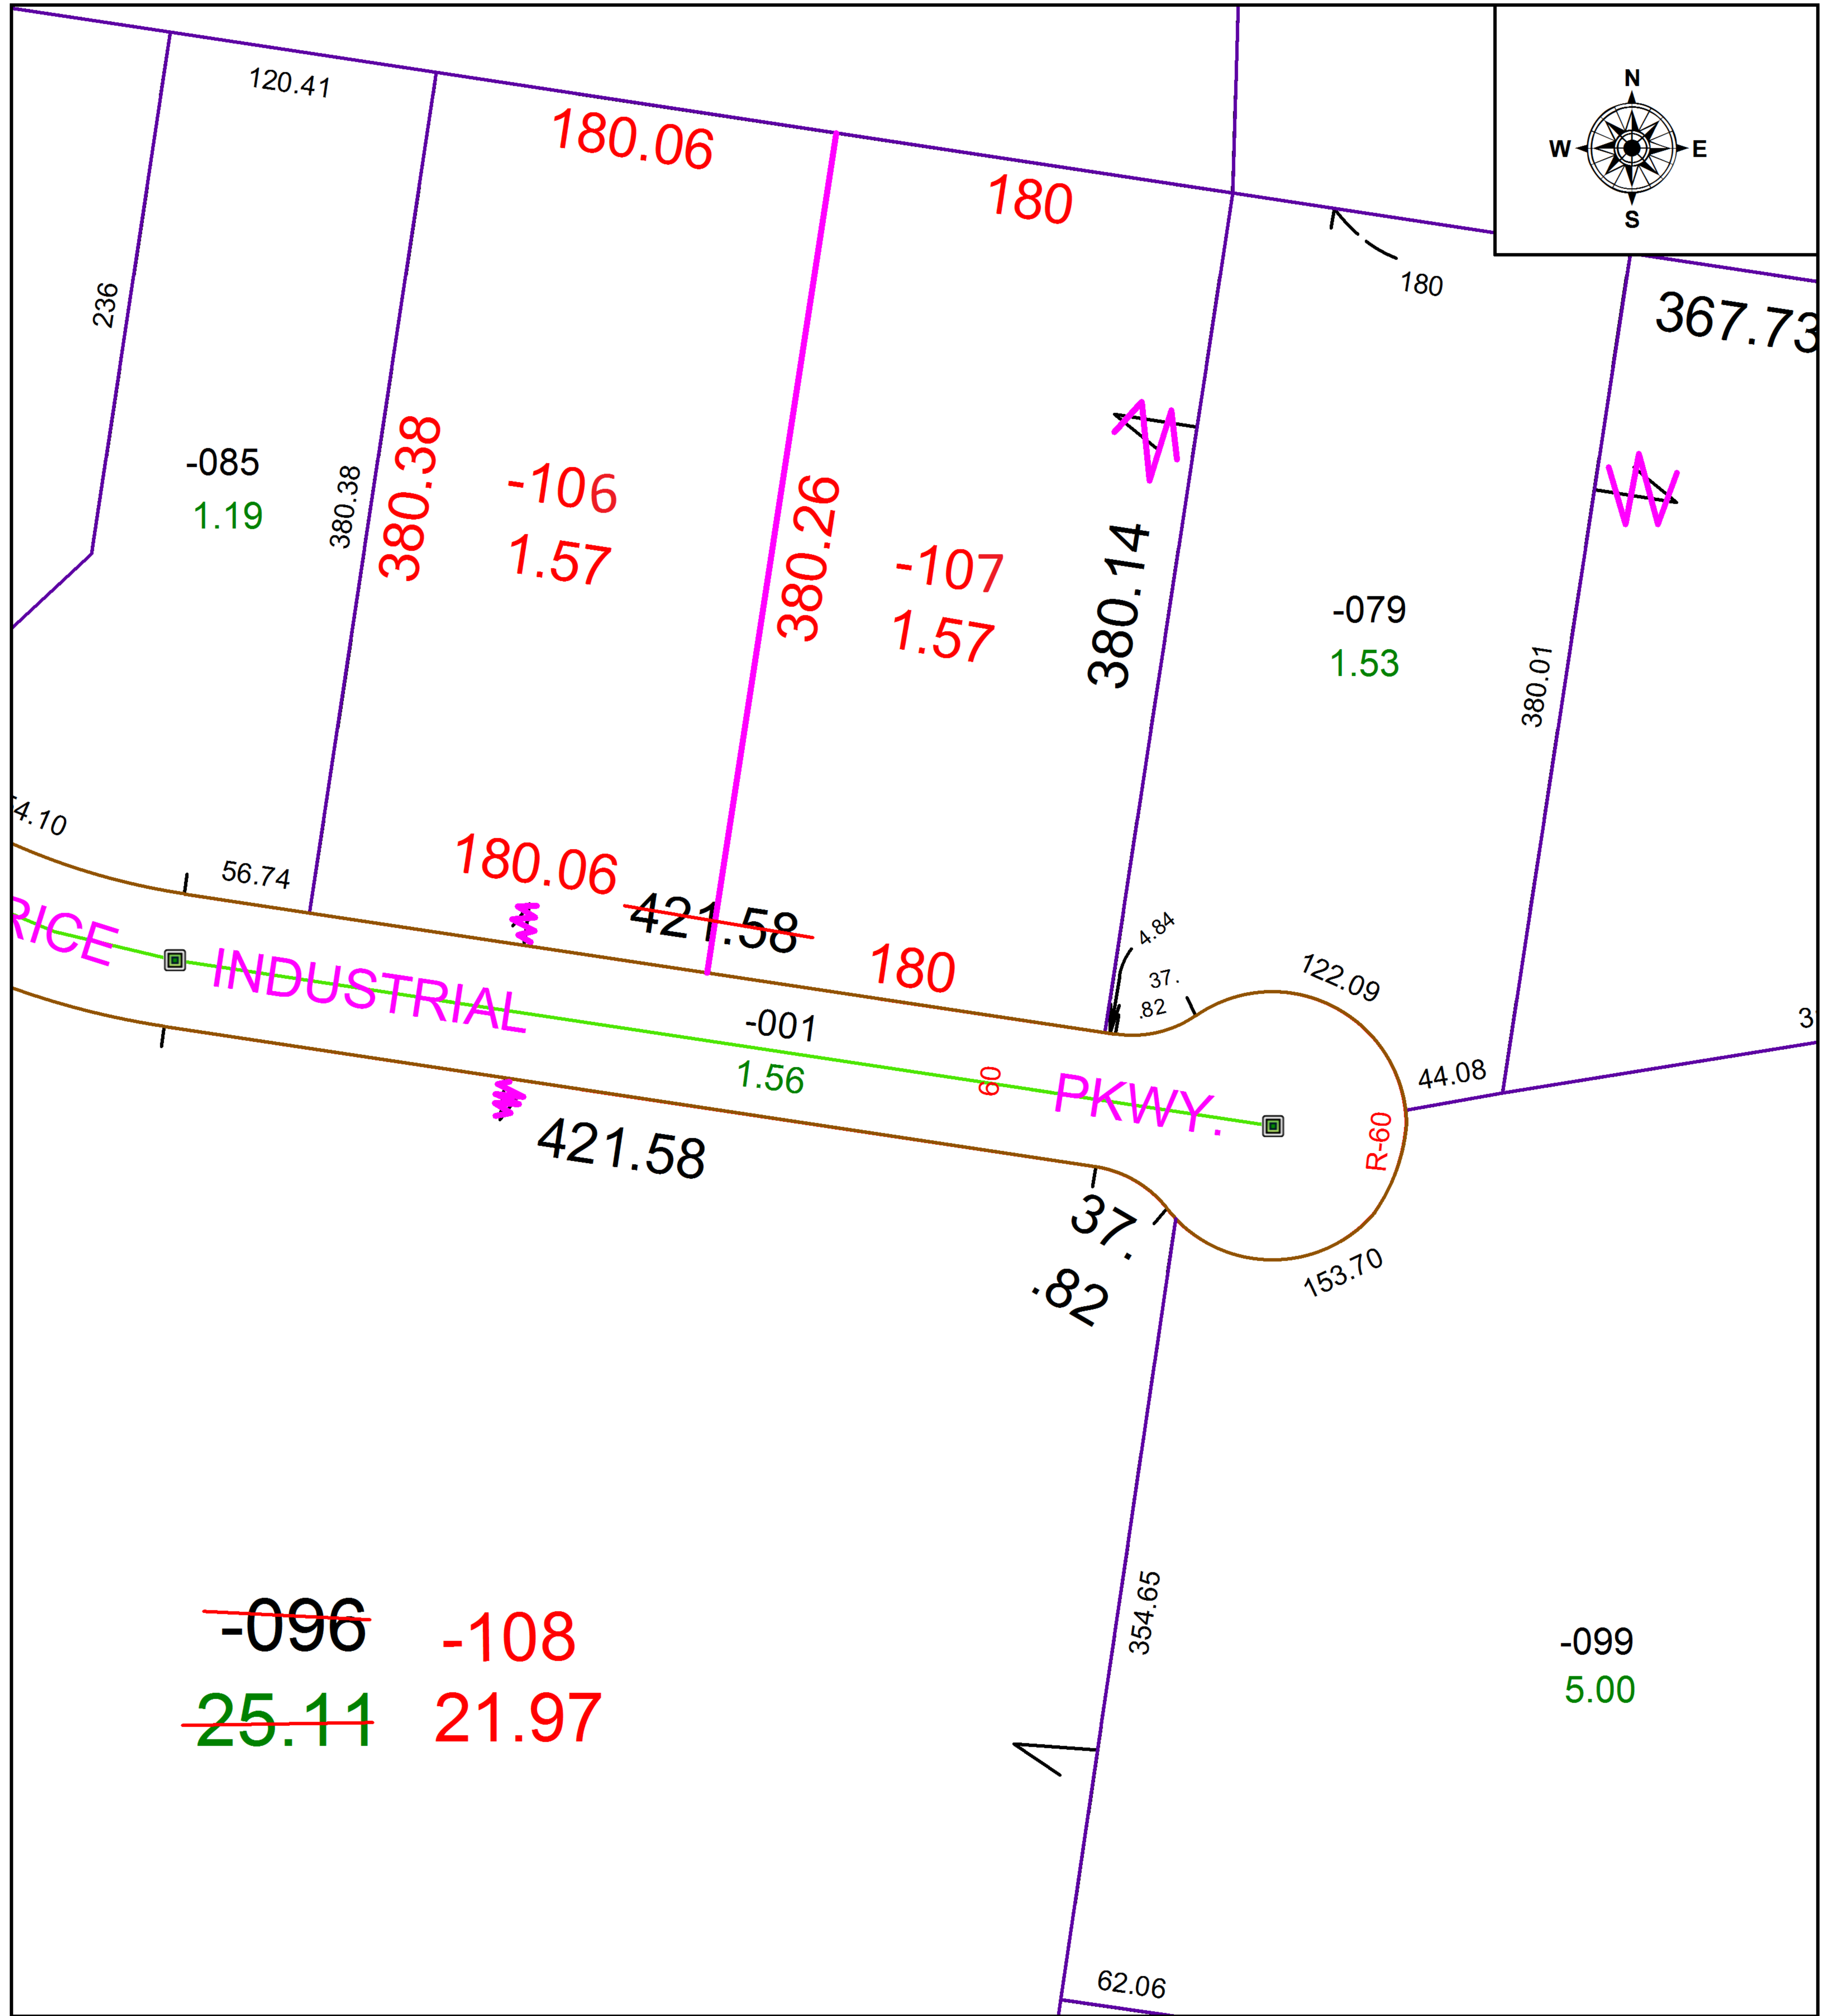

SPLITS/DEEDS PROCESSED
 LORAIN COUNTY TAX MAP DEPARTMENT
 226 MIDDLE AVE. ELYRIA, OH

SURVEYED BY: ANDREW G. PLANET
 CLOSURE: 1: 285,918
 MAP PAGE(S): 05-00-044
 APPROVED BY: WRZ DATE: 9/22/2021
 SCALE: 1" = 100 PRIOR INSTRUMENT: 2002-0845119