
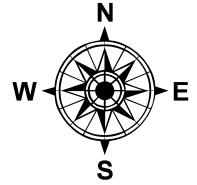


PARENT PARCEL: 05-00-018-104-047


CHILD PARCEL: 05-00-018-104-072, -073

STARTING POINT: NORTHWEST CORNER OF S/L 513 IN ASCHENBACH'S ADD.

20-04379-U

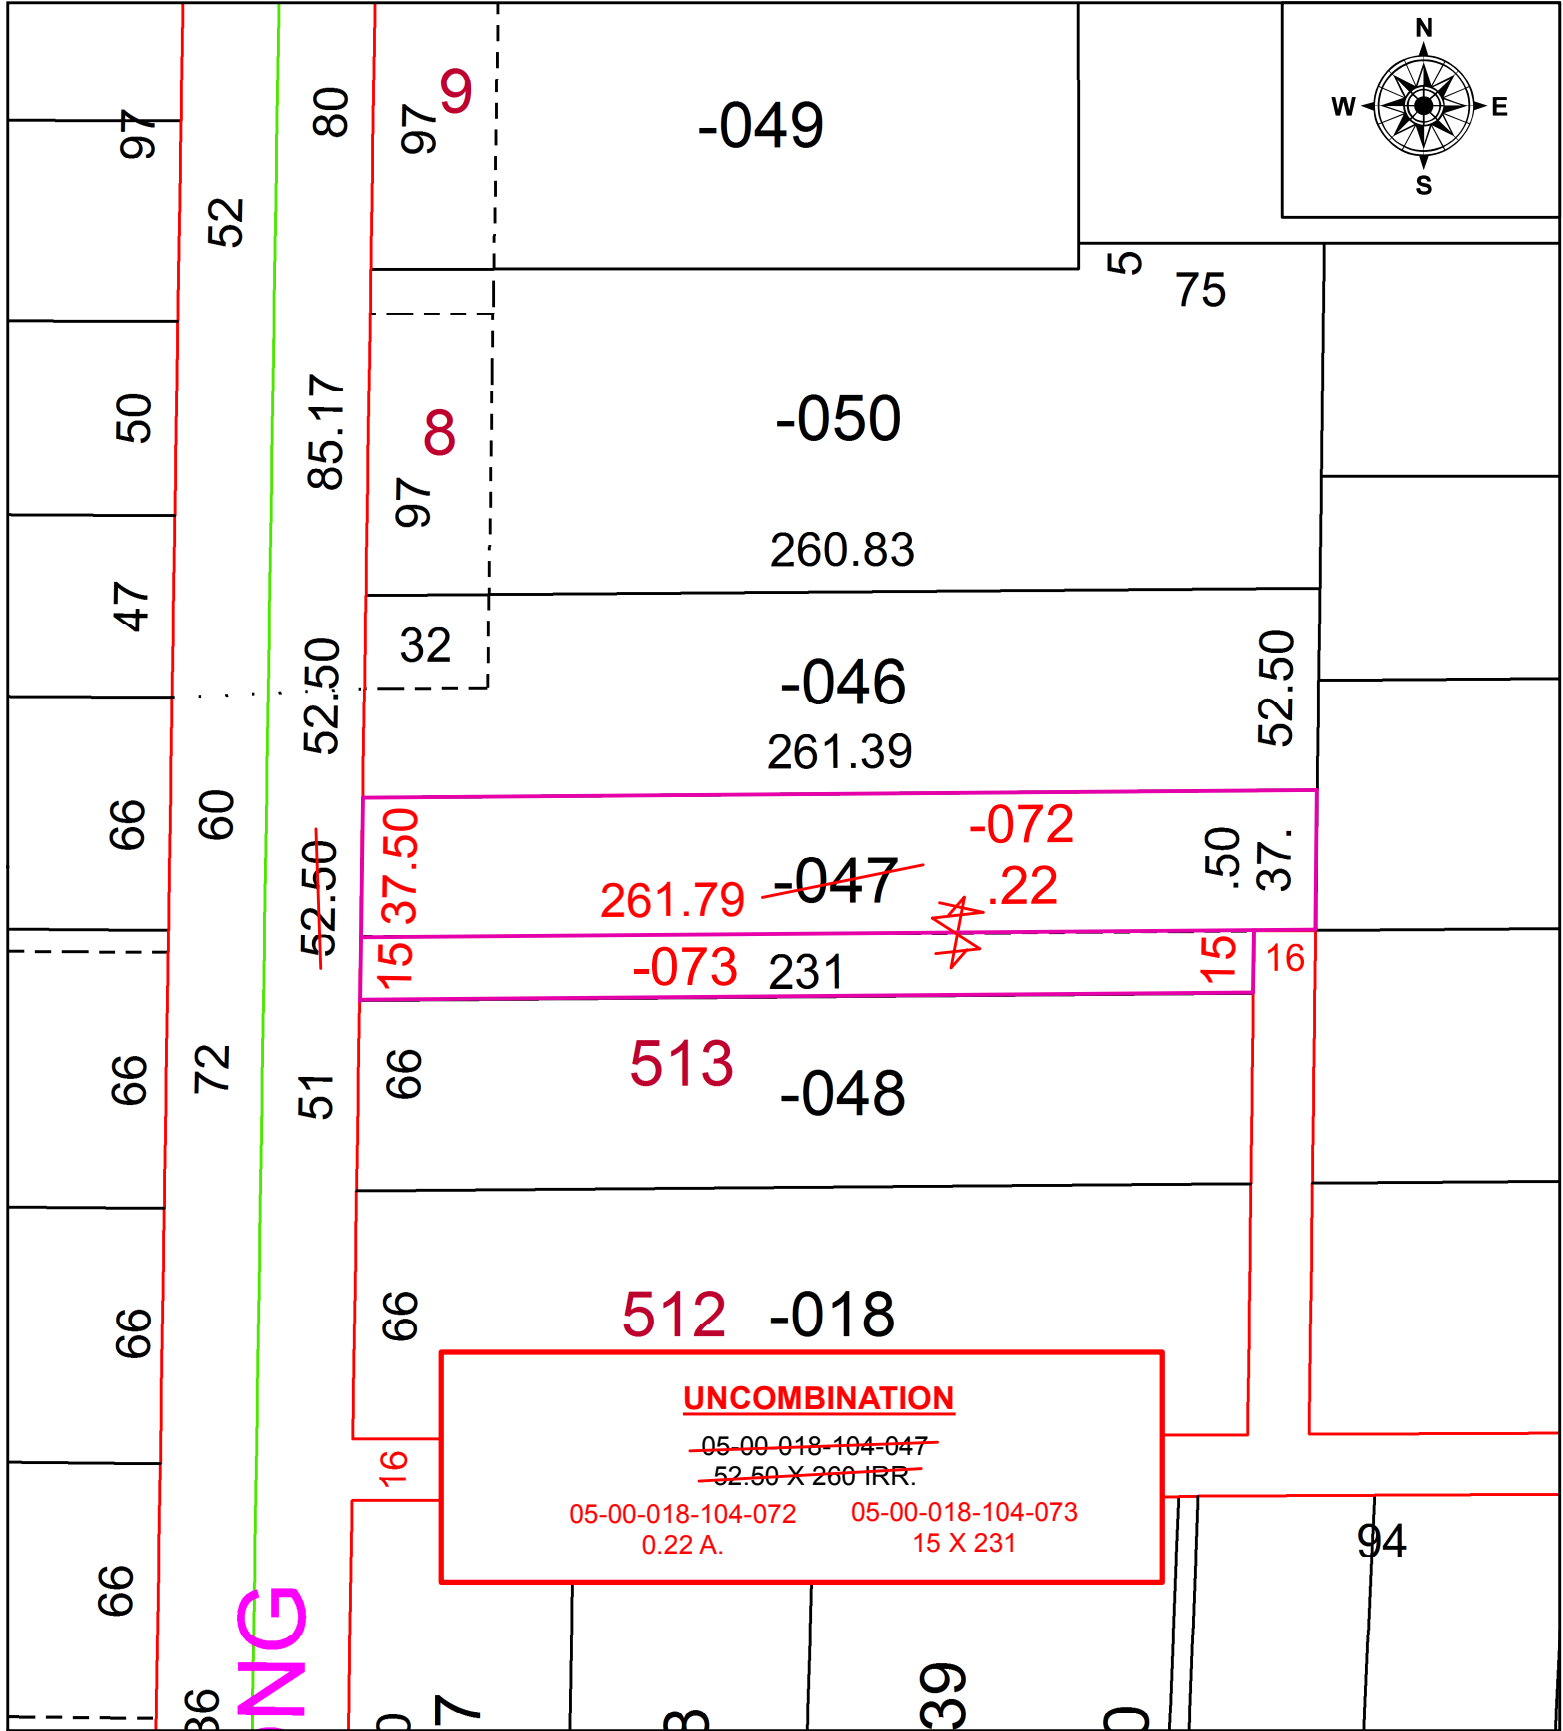

UNCOMBINATION
~~05-00-018-104-047~~
~~52.50 X 260 IRR.~~
 05-00-018-104-072 05-00-018-104-073
 0.22 A. 15 X 231

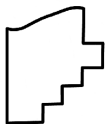

SPLITS/DEEDS PROCESSED
 LORAIN COUNTY TAX MAP DEPARTMENT
 226 MIDDLE AVE. ELYRIA, OH

SURVEYED BY: _____ N/A
 CLOSURE: _____ N/A
 MAP PAGE(S): _____ 5-00-018
 APPROVED BY: _____ RRM DATE: _____ 8-7-20
 SCALE: _____ 1" = 50 PRIOR INSTRUMENT: _____ 20020847930