
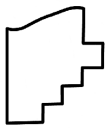


PARENT PARCEL: 12-00-045-000-003 & -004

CHILD PARCEL: 12-00-045-000-044 THRU -046

STARTING POINT: MONUMENT BOX AT THE NORTHWESTERLY CORNER OF O.L. 45 IN THE C/L OF WEST RIVER RD

21-04379

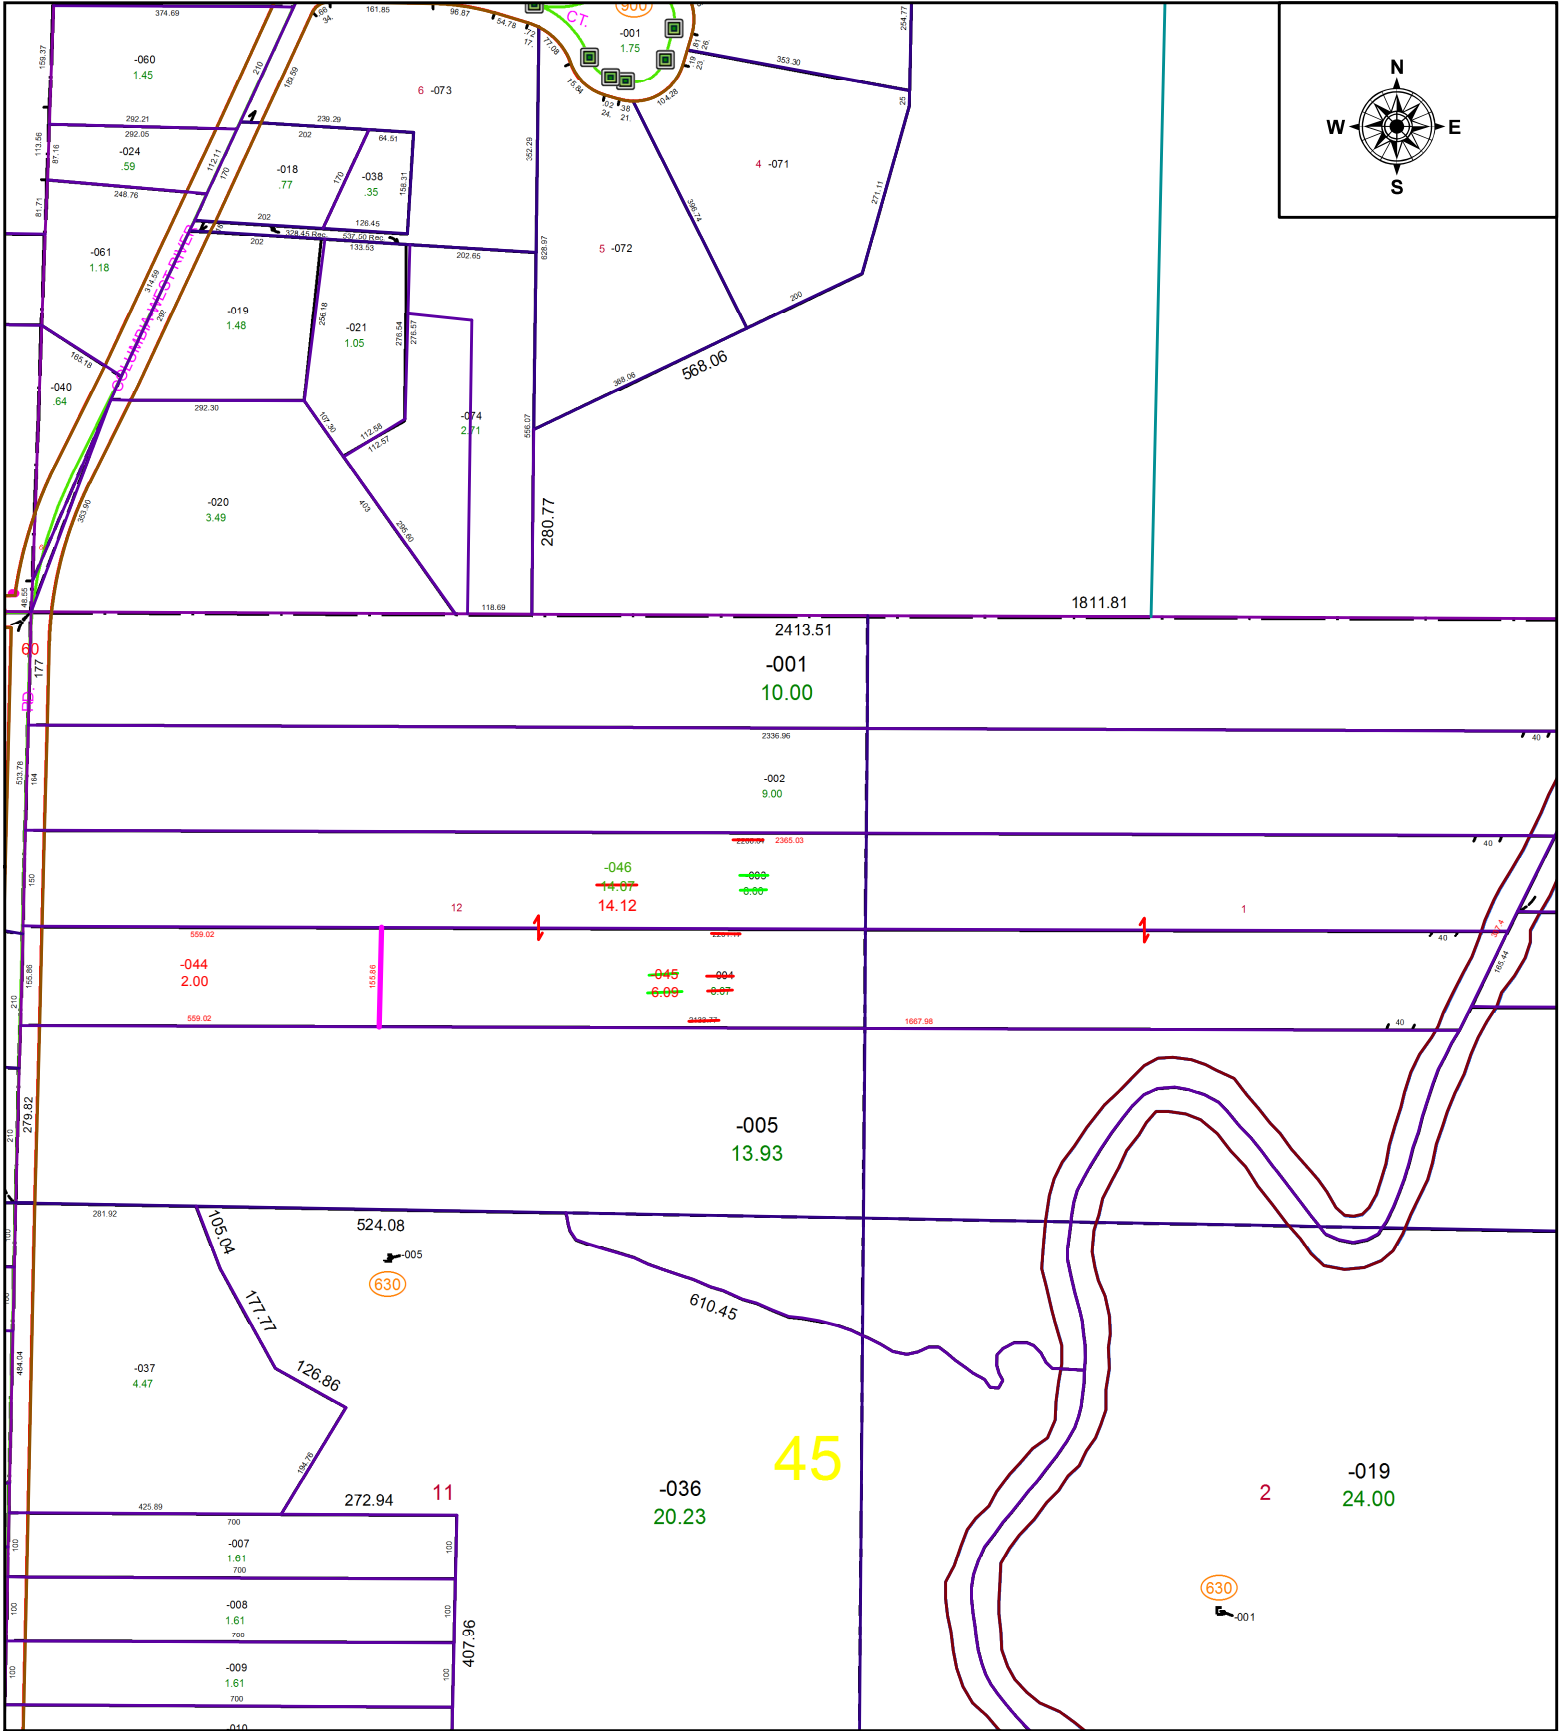

SPLITS/DEEDS PROCESSED
 LORAIN COUNTY TAX MAP DEPARTMENT
 226 MIDDLE AVE. ELYRIA, OH

SURVEYED BY: JOSHUA S. RIEDY
CLOSURE: 1: -2147483648
MAP PAGE(S): 12-00-045
APPROVED BY: WRZ **DATE:** 9/27/2021
SCALE: 1" = 300 **PRIOR INSTRUMENT:** 2017-0649363