
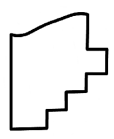
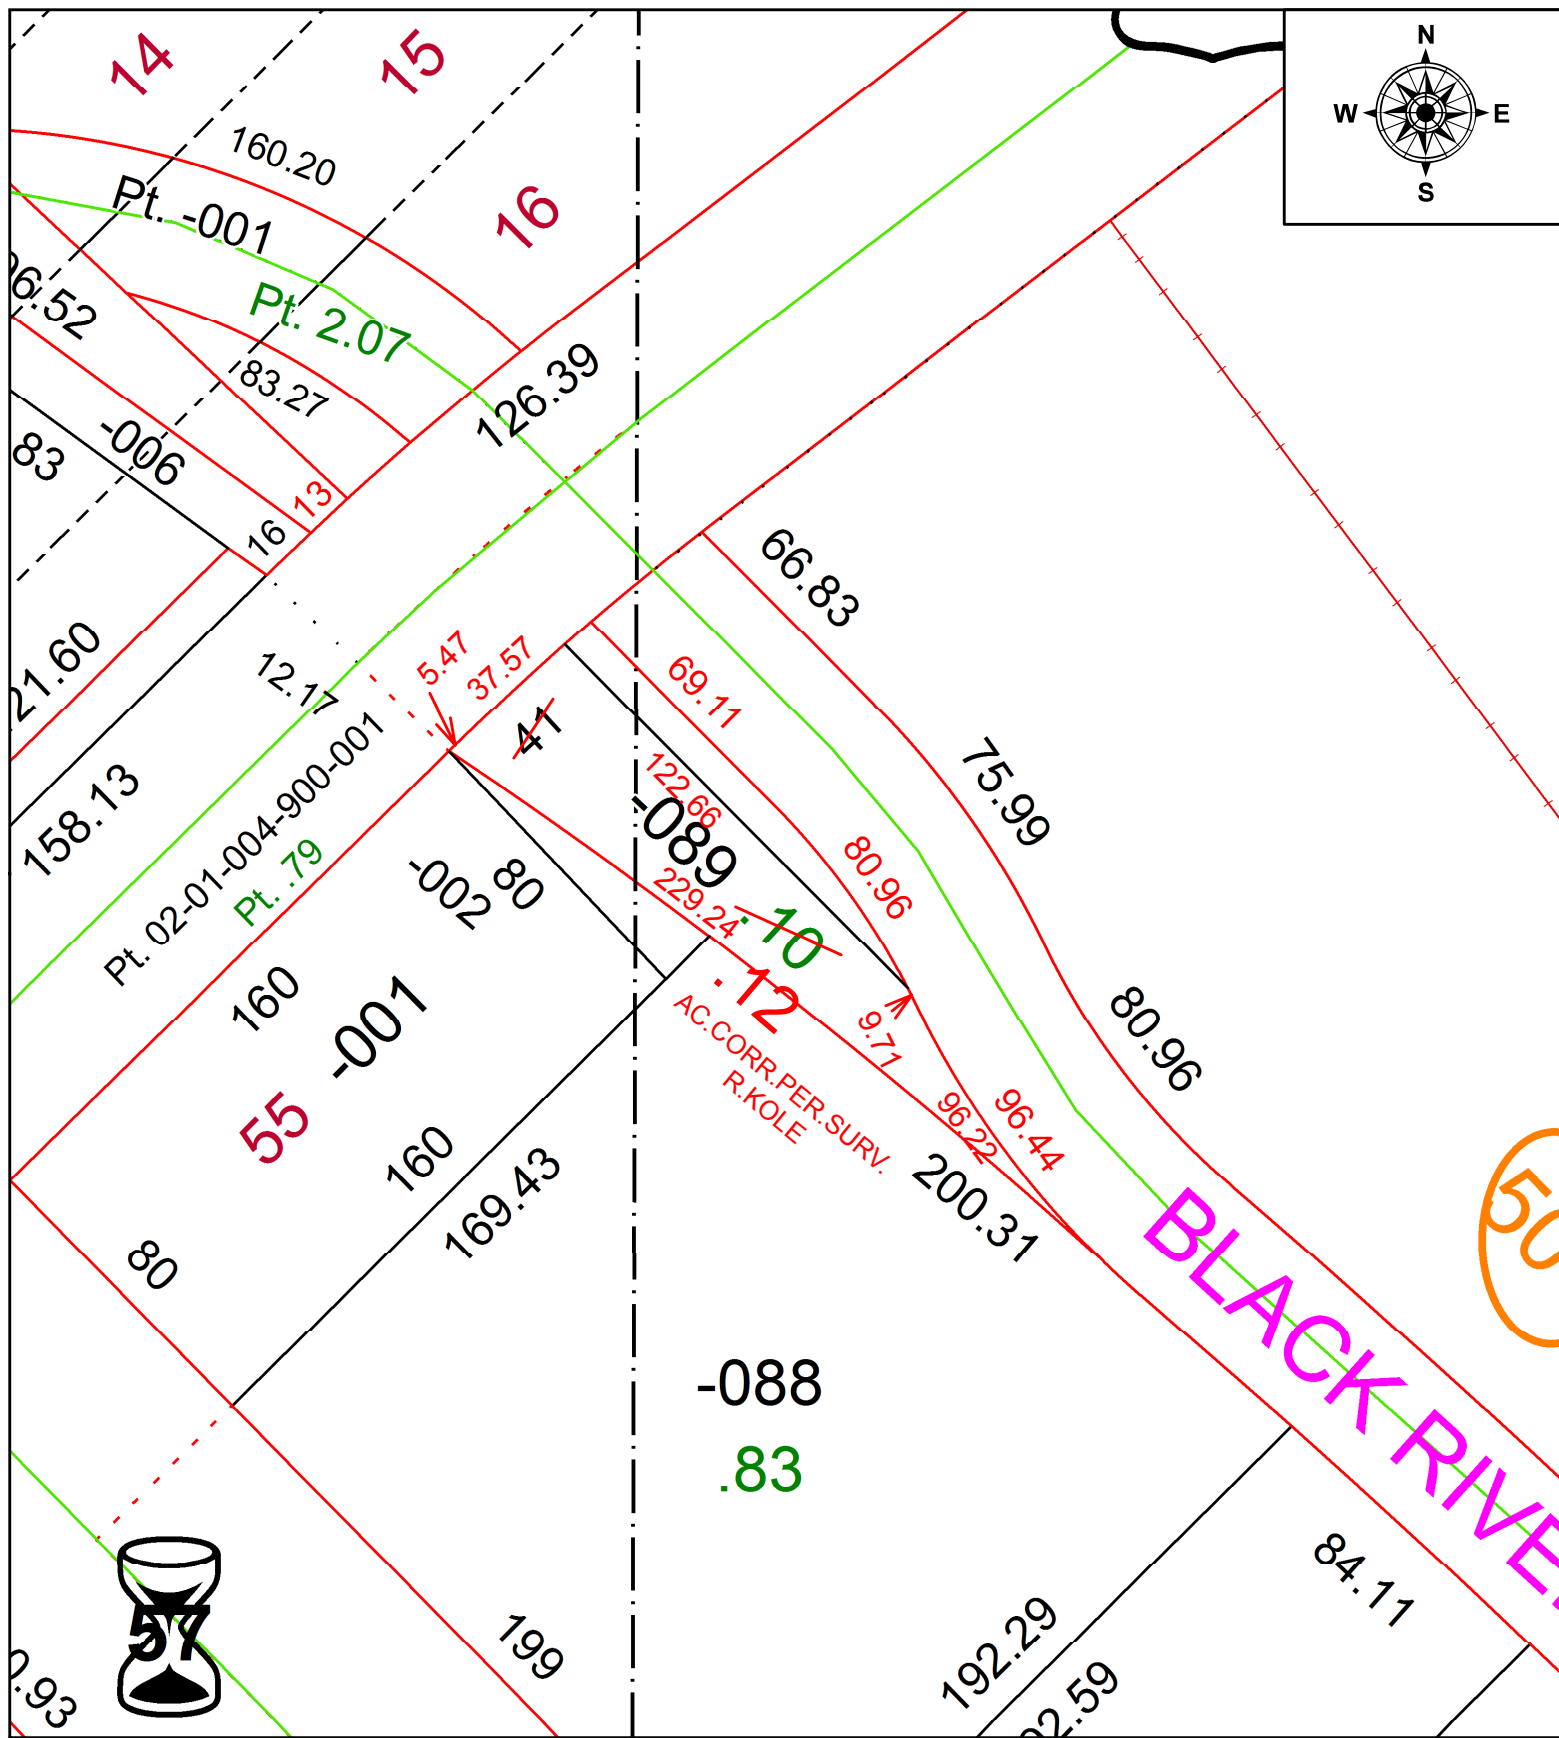


PARENT PARCEL: 02-01-004-101-089

CHILD PARCEL:

STARTING POINT: NORTHEAST CORNER OF S/L 55 IN DURAND'S PLAT OF CHARLESTON

20-04380-D

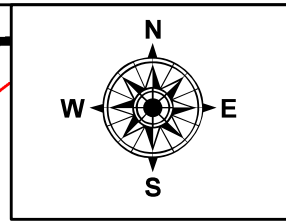

SPLITS/DEEDS PROCESSED
LORAIN COUNTY TAX MAP DEPARTMENT
226 MIDDLE AVE. ELYRIA, OH

SURVEYED BY: RICHARD J. KOLE
CLOSURE: 1:67,086
MAP PAGE(S): 2-01-004
APPROVED BY: RRM DATE: 8-13-20
SCALE: 1" = 50 PRIOR INSTRUMENT: 20200764174