


PARENT PARCEL: 18-00-028-108-019

CHILD PARCEL:


STARTING POINT:

NORTHWEST CORNER OF S/L 20 IN D/L WADSWORTH'S ADD.

20-04384-D

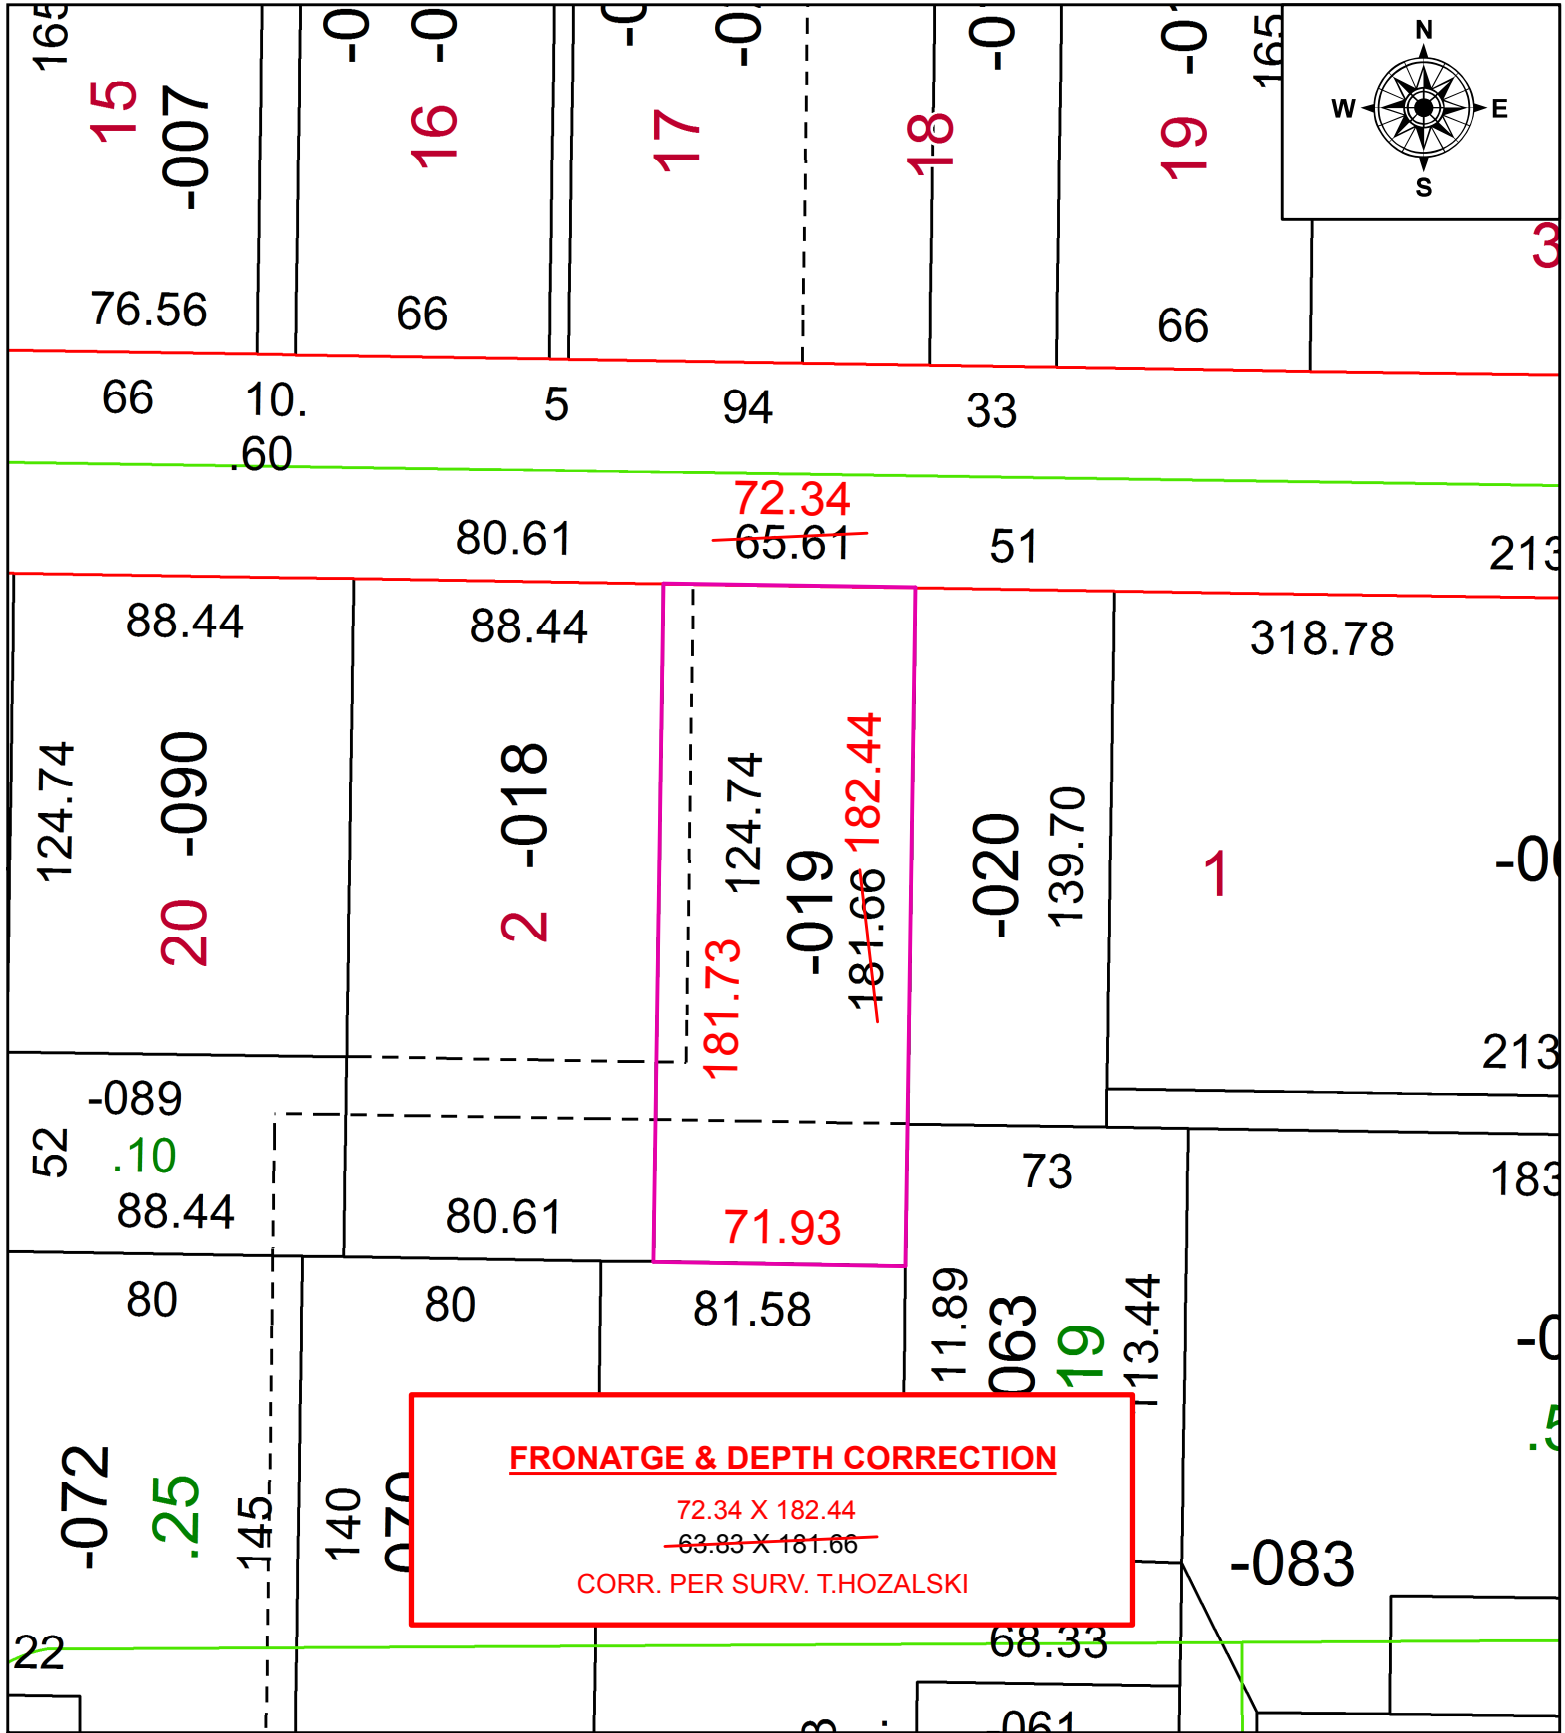

FRONTAGE & DEPTH CORRECTION
 72.34 X 182.44
~~63.83 X 181.66~~
 CORR. PER SURV. T.HOZALSKI

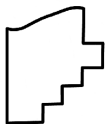

SPLITS/DEEDS PROCESSED
 LORAIN COUNTY TAX MAP DEPARTMENT
 226 MIDDLE AVE. ELYRIA, OH

SURVEYED BY: TIMOTHY D. HOZALSKI
 CLOSURE: 1:58,015
 MAP PAGE(S): 18-00-028
 APPROVED BY: RRM DATE: 8-13-20
 SCALE: 1" = 50 PRIOR INSTRUMENT: 20130487588