
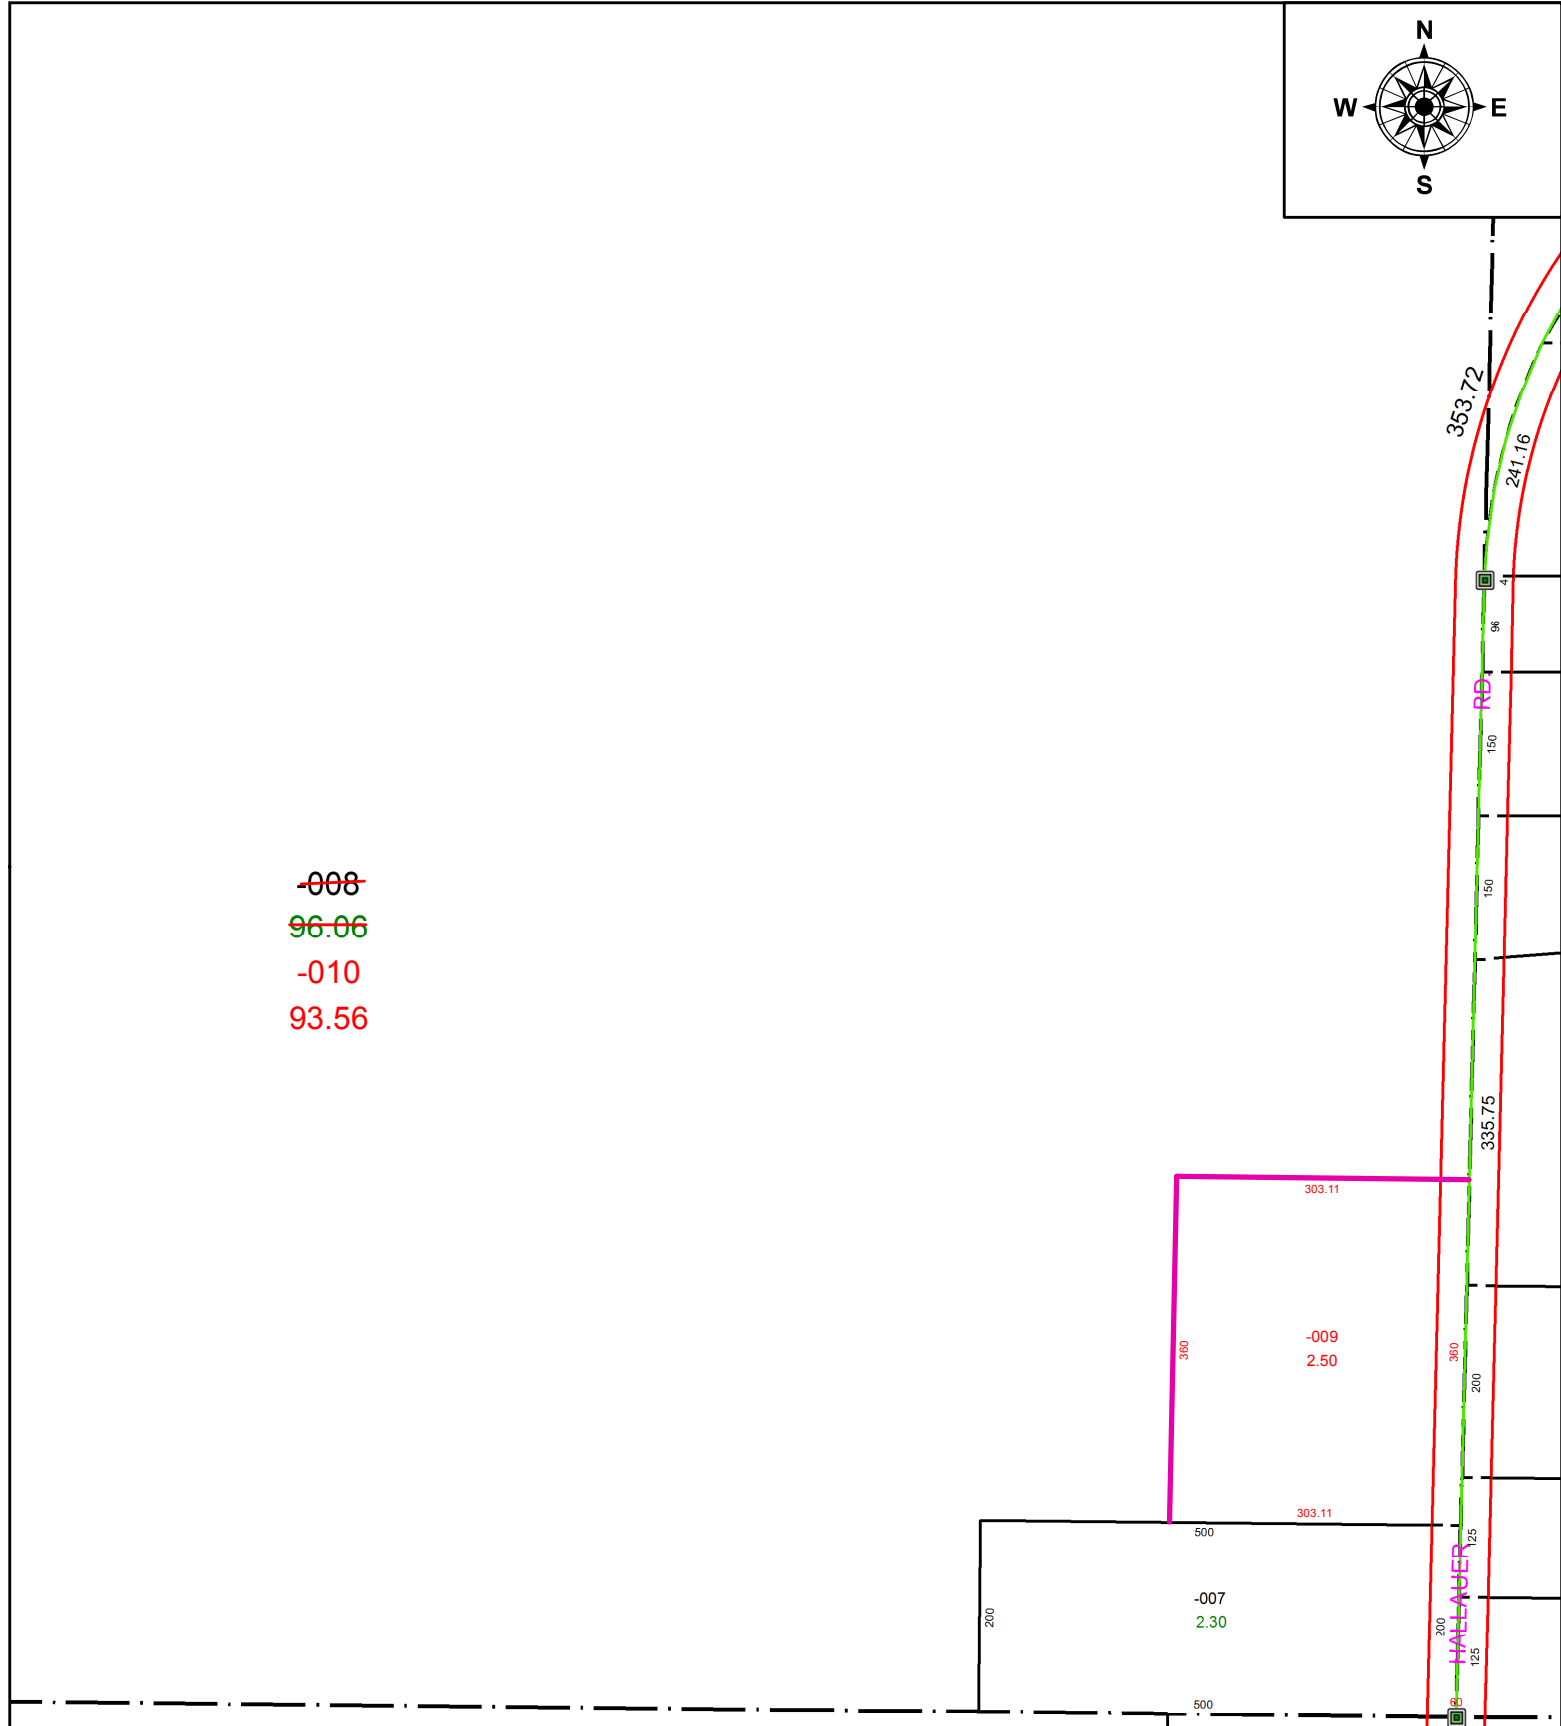


PARENT PARCEL: 14-00-036-000-008


CHILD PARCEL: 14-00-036-000-009, -010

STARTING POINT: SE CORNER OF O/L 36 AND C/L OF HALLAUER RD

21-04385

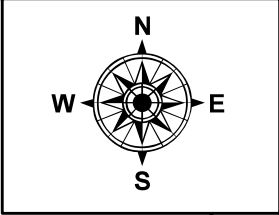

~~-008~~
96.06
-010
93.56

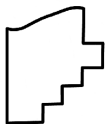

SPLITS/DEEDS PROCESSED
LORAIN COUNTY TAX MAP DEPARTMENT
226 MIDDLE AVE. ELYRIA, OH

SURVEYED BY: TIMOTHY D. HOZALSKI
CLOSURE: 1: 2147483648
MAP PAGE(S): 14-00-036-A-B
APPROVED BY: AC DATE: 10/6/2021
SCALE: 1" = 200 PRIOR INSTRUMENT: 2002- 0815522