




PARENT PARCEL: 21-05-012-000-004, -009

CHILD PARCEL: 21-05-012-000-034

COMBINATION PER PRIOR DEED

21-04392

STARTING POINT: C/L OF BURSLEY AND CLARK RD

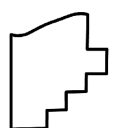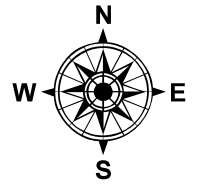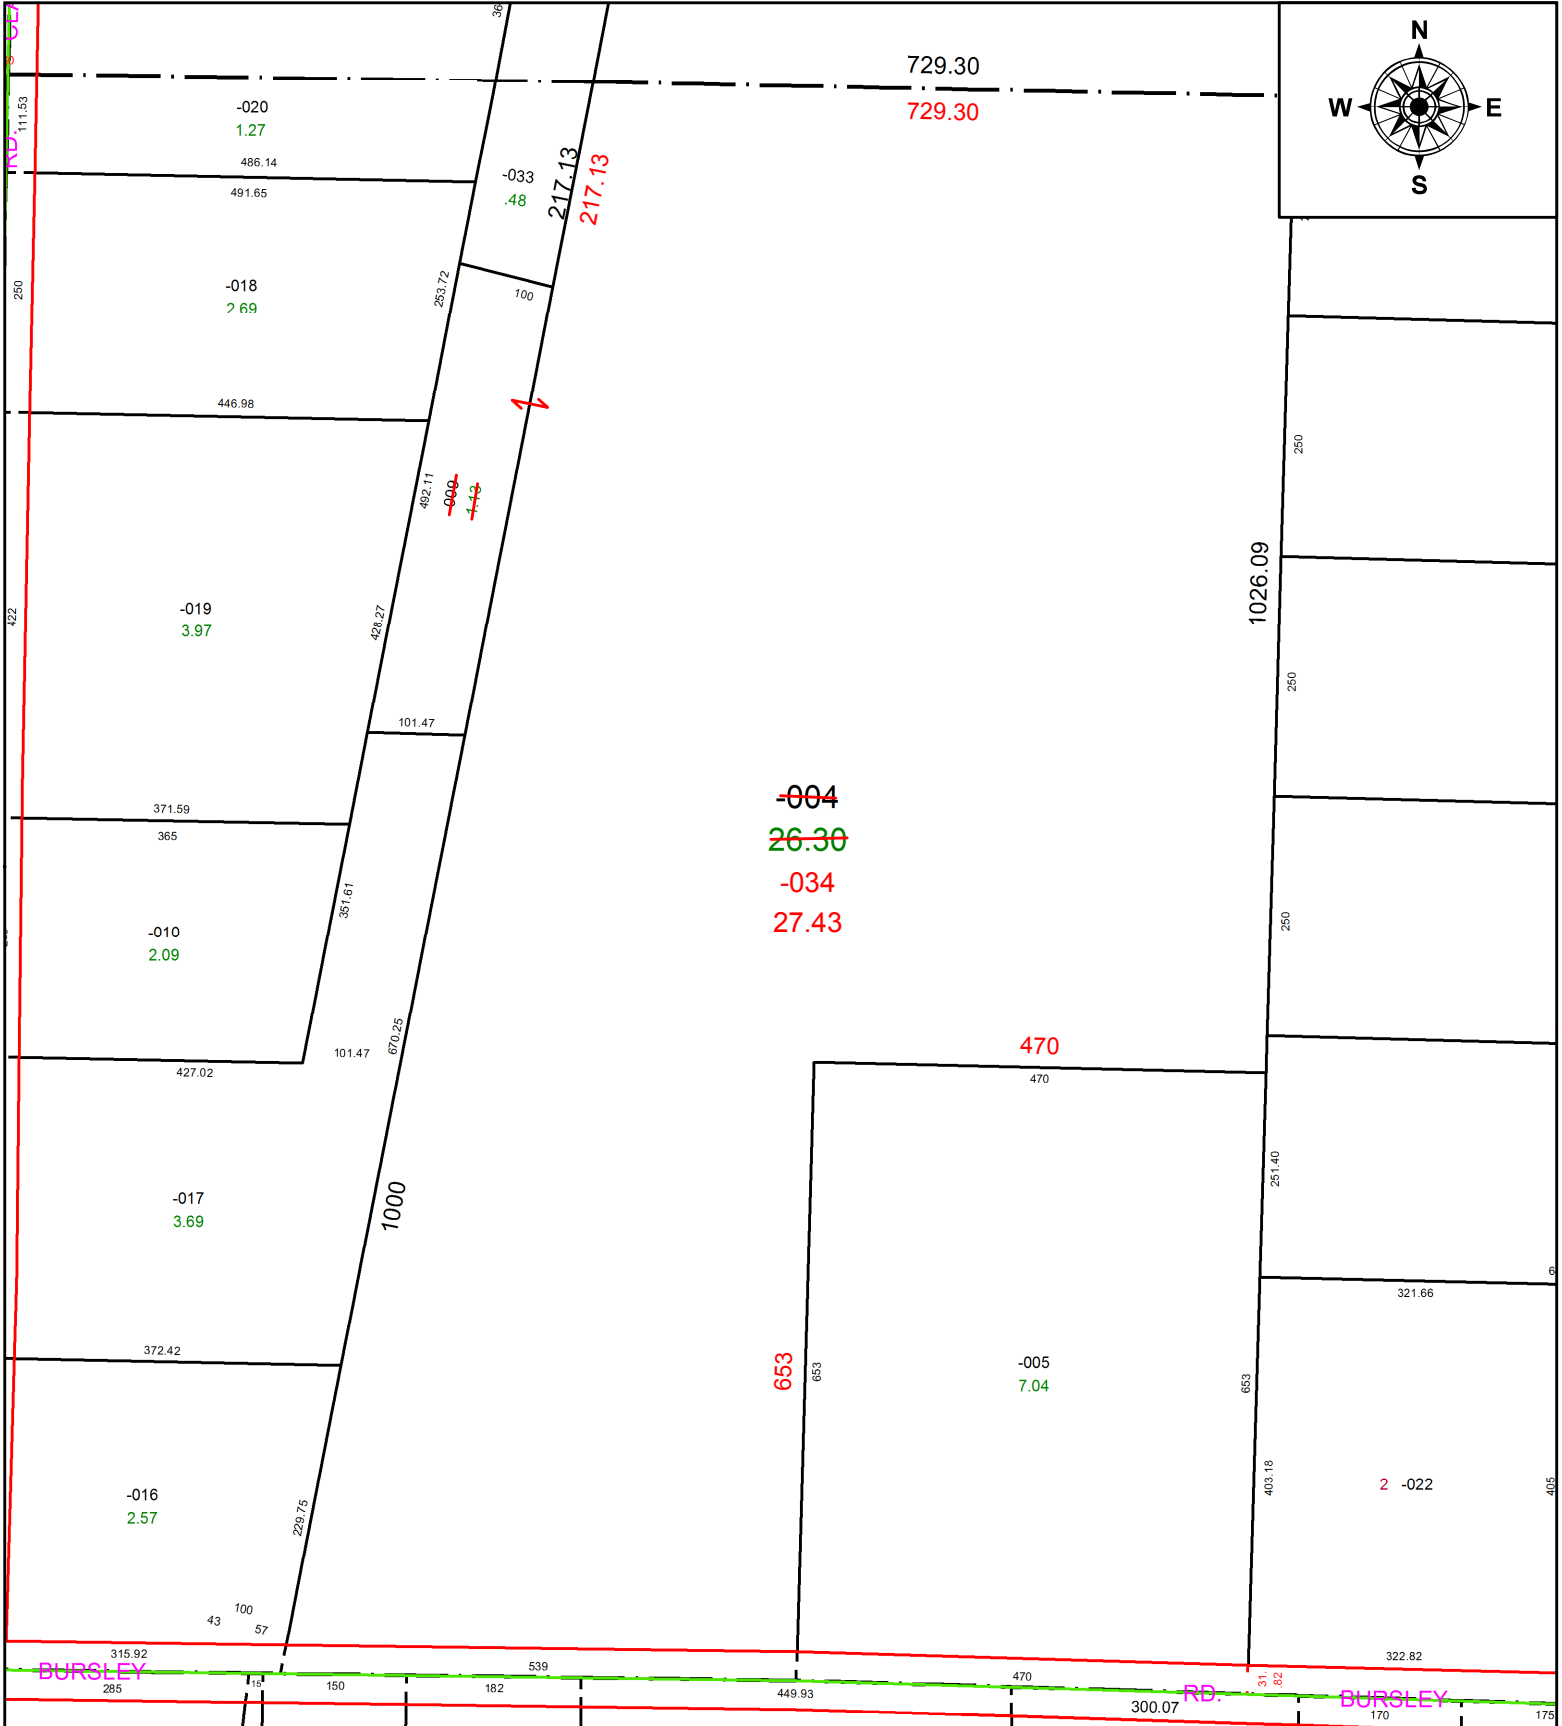

SPLITS/DEEDS PROCESSED
 LORAIN COUNTY TAX MAP DEPARTMENT
 226 MIDDLE AVE. ELYRIA, OH

SURVEYED BY: THOMAS G. REEL
 CLOSURE: 1: 63829
 MAP PAGE(S): 21-05-012
 APPROVED BY: AC DATE: 10/20/2021
 SCALE: 1" = 200 PRIOR INSTRUMENT: 2017- 0655817