
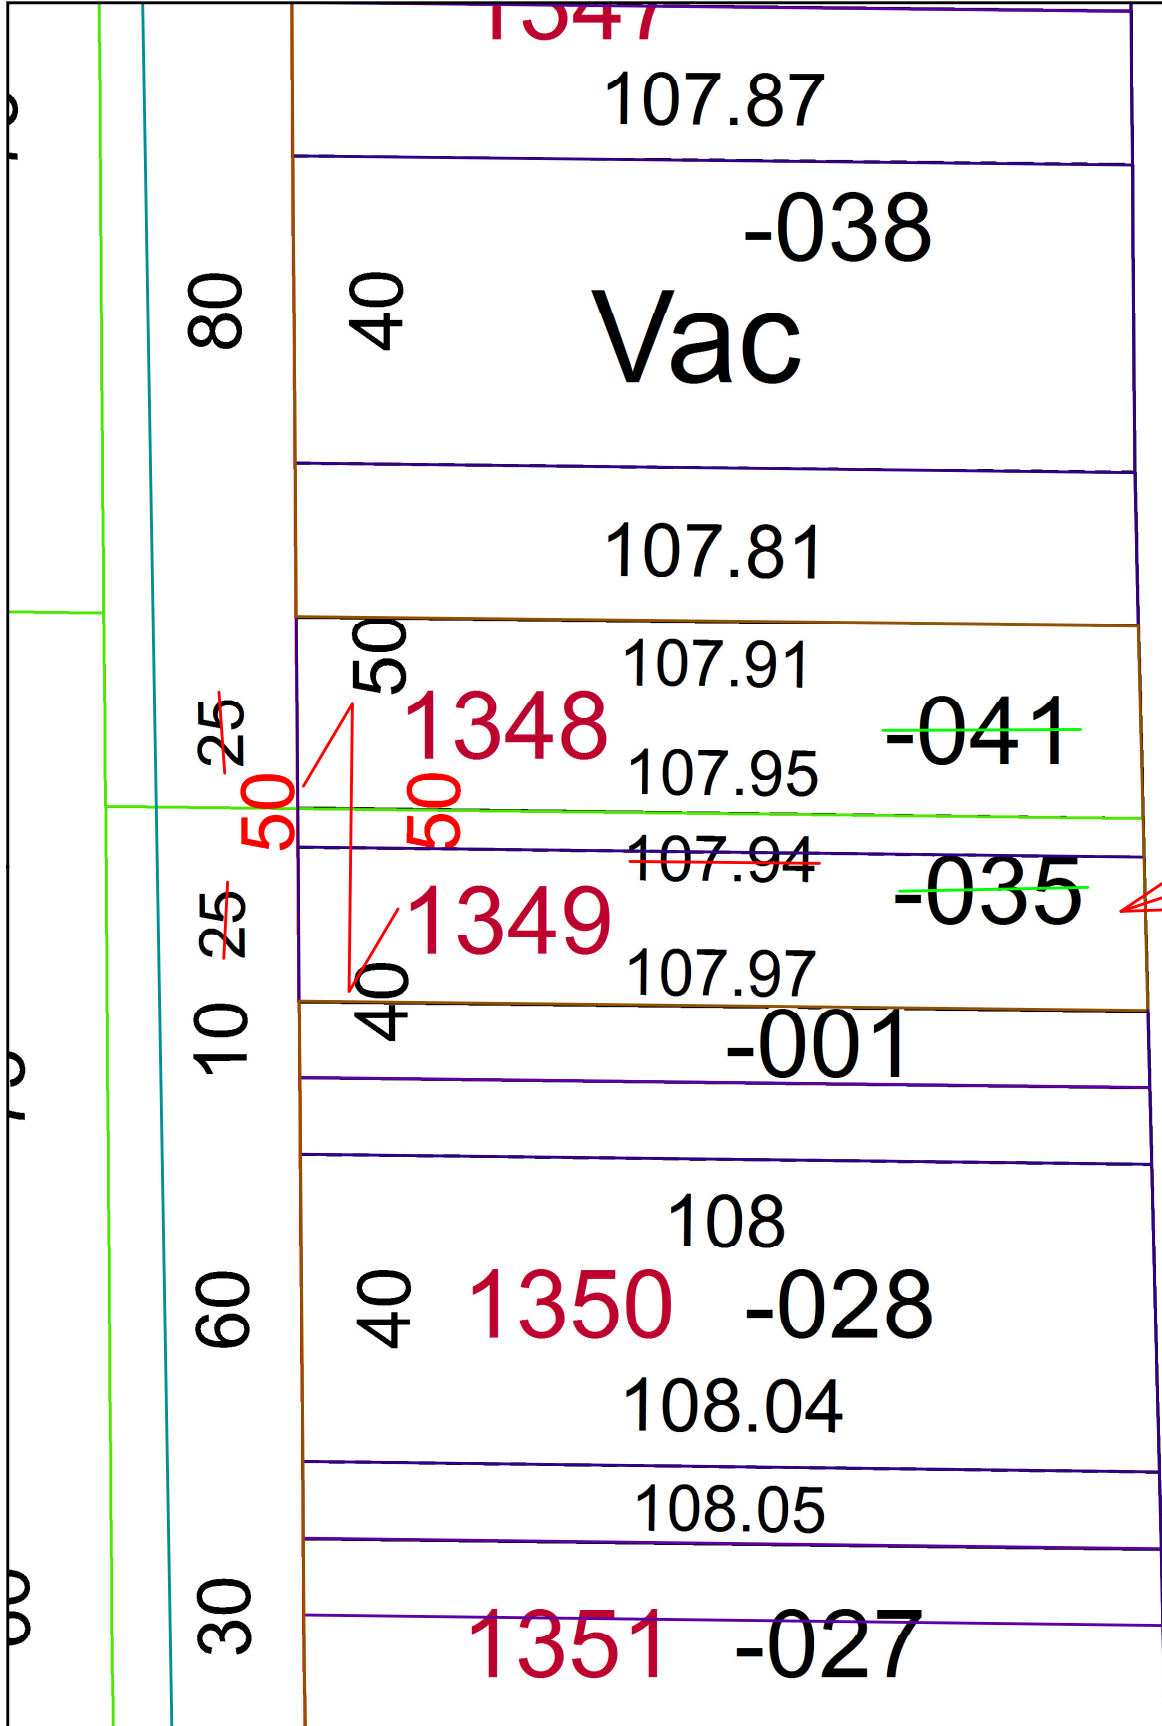



PARENT PARCEL: 01-00-002-118-041 & 01-00-002-122-035

CHILD PARCEL: 01-00-002-122-036

STARTING POINT: INTERSECTION EASTERLY LINE OF HIGH BRIDGE RD & SOUTH LINE OF THORNWOOD RD

21-04394

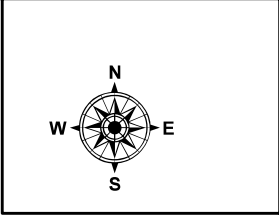

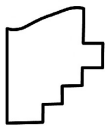 **SPLITS/DEEDS PROCESSED**  
 LORAIN COUNTY TAX MAP DEPARTMENT  
 226 MIDDLE AVE. ELYRIA, OH

SURVEYED BY: PATRICK MCGANNON  
 CLOSURE: 1: 93,212  
 MAP PAGE(S): 01-00-002  
 APPROVED BY: WRZ DATE: 10/22/2021  
 SCALE: 1" = 25' PRIOR INSTRUMENT: VOL. 23 PG. 20