
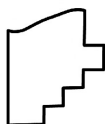
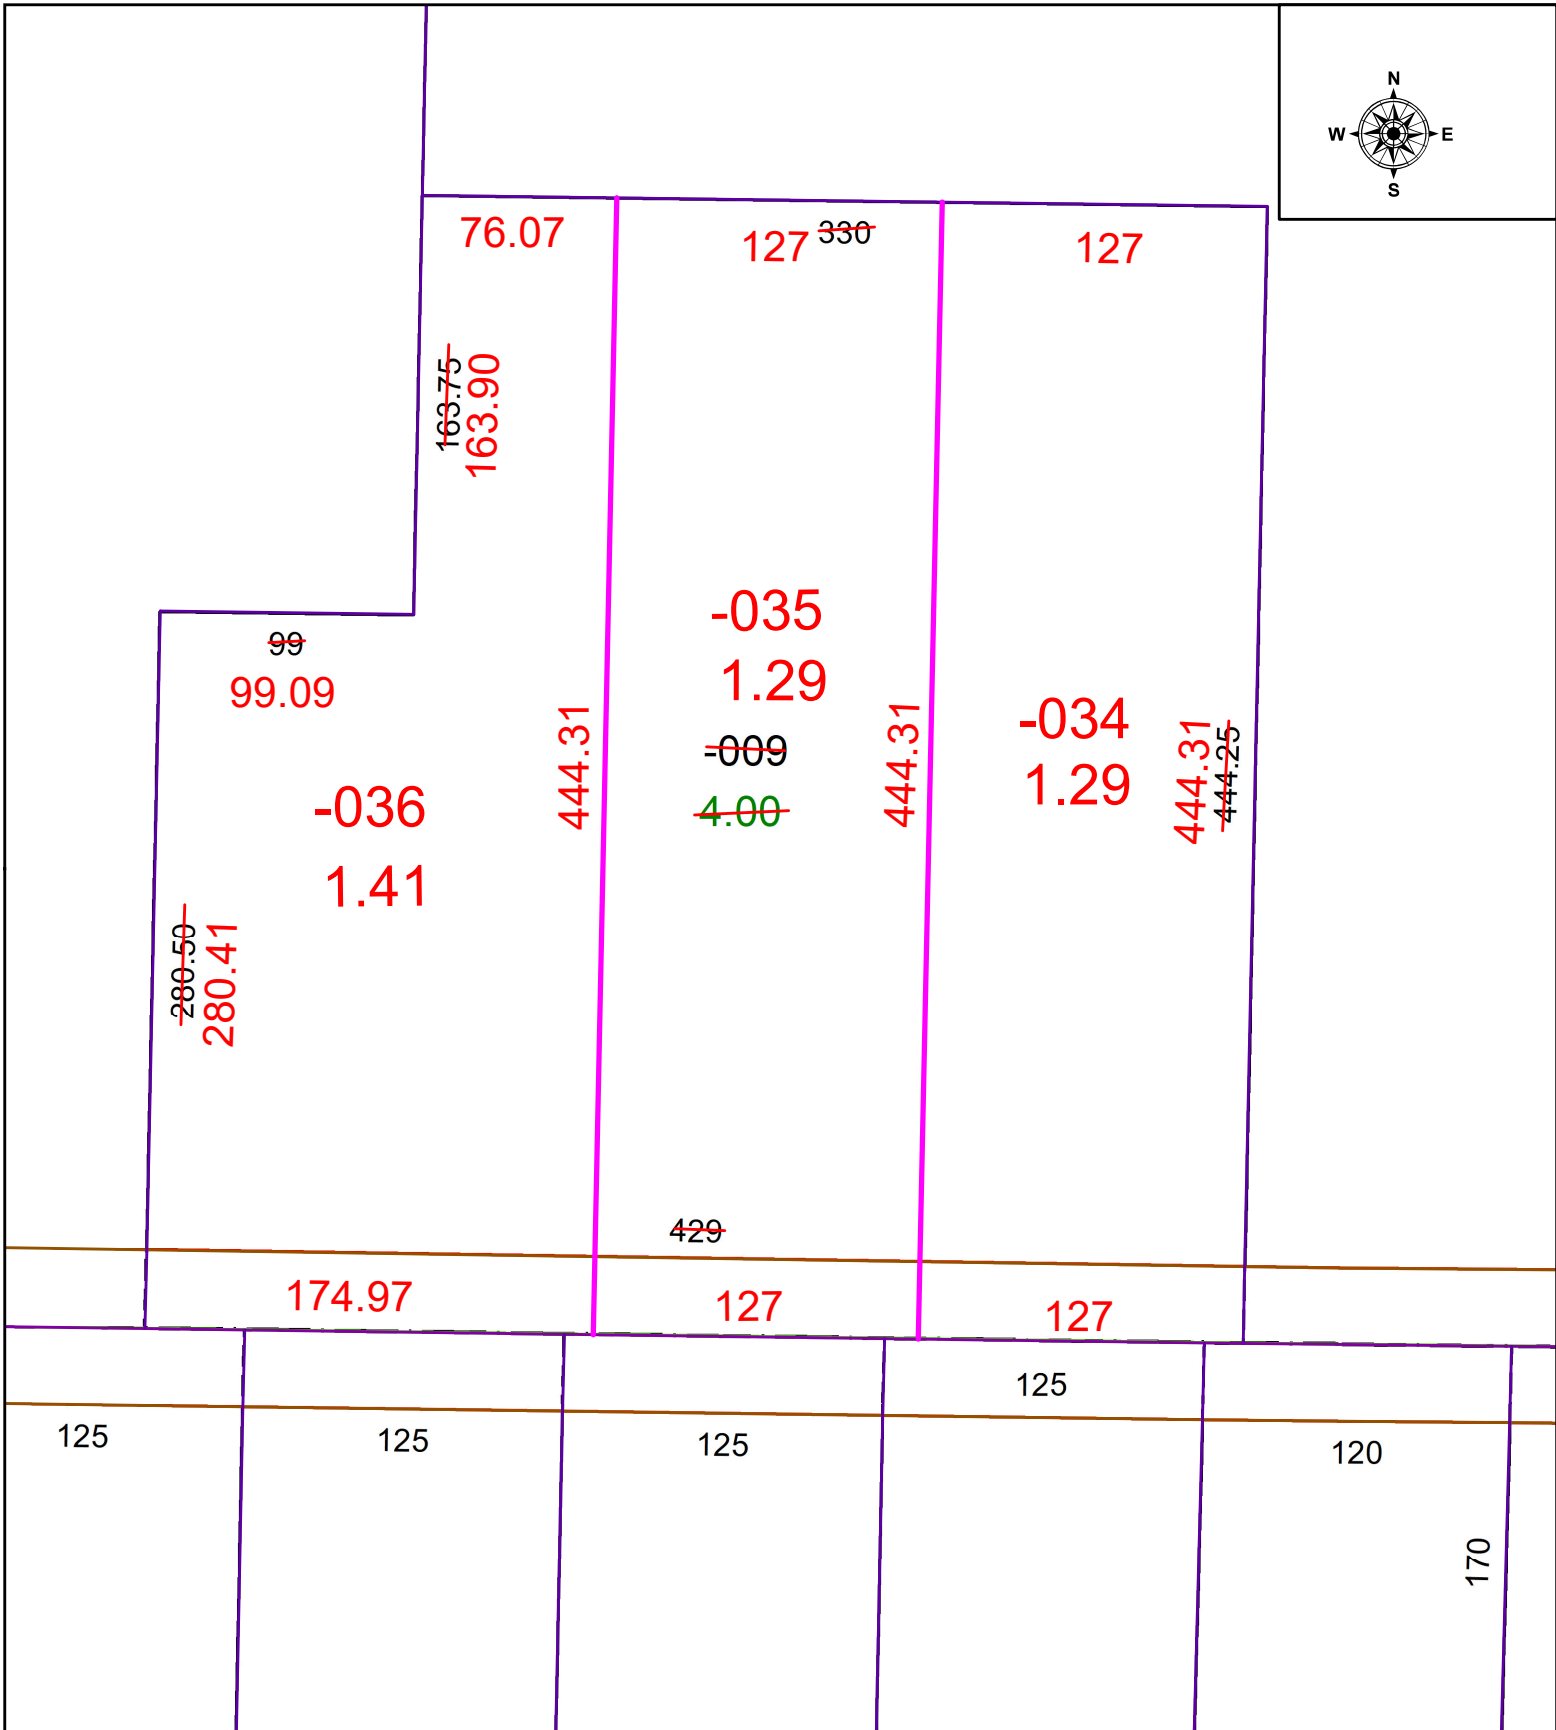


PARENT PARCEL: 09-00-092-000-009

CHILD PARCEL: 09-00-092-000-034, -035, -036

STARTING POINT: MONUMENT BOX AT INTERSECTION OF QUARRY RD & WEST HAMILTON ST

21-04397

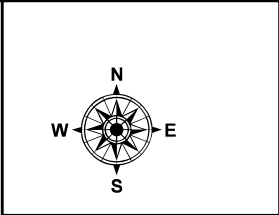

SPLITS/DEEDS PROCESSED
 LORAIN COUNTY TAX MAP DEPARTMENT
 226 MIDDLE AVE. ELYRIA, OH

SURVEYED BY: JOHN A. DECHANT JR.
CLOSURE: 1: -2147483648
MAP PAGE(S): 09-00-092
APPROVED BY: WRZ **DATE:** 10/28/2021
SCALE: 1" = 75 **PRIOR INSTRUMENT:** 2021-0803554